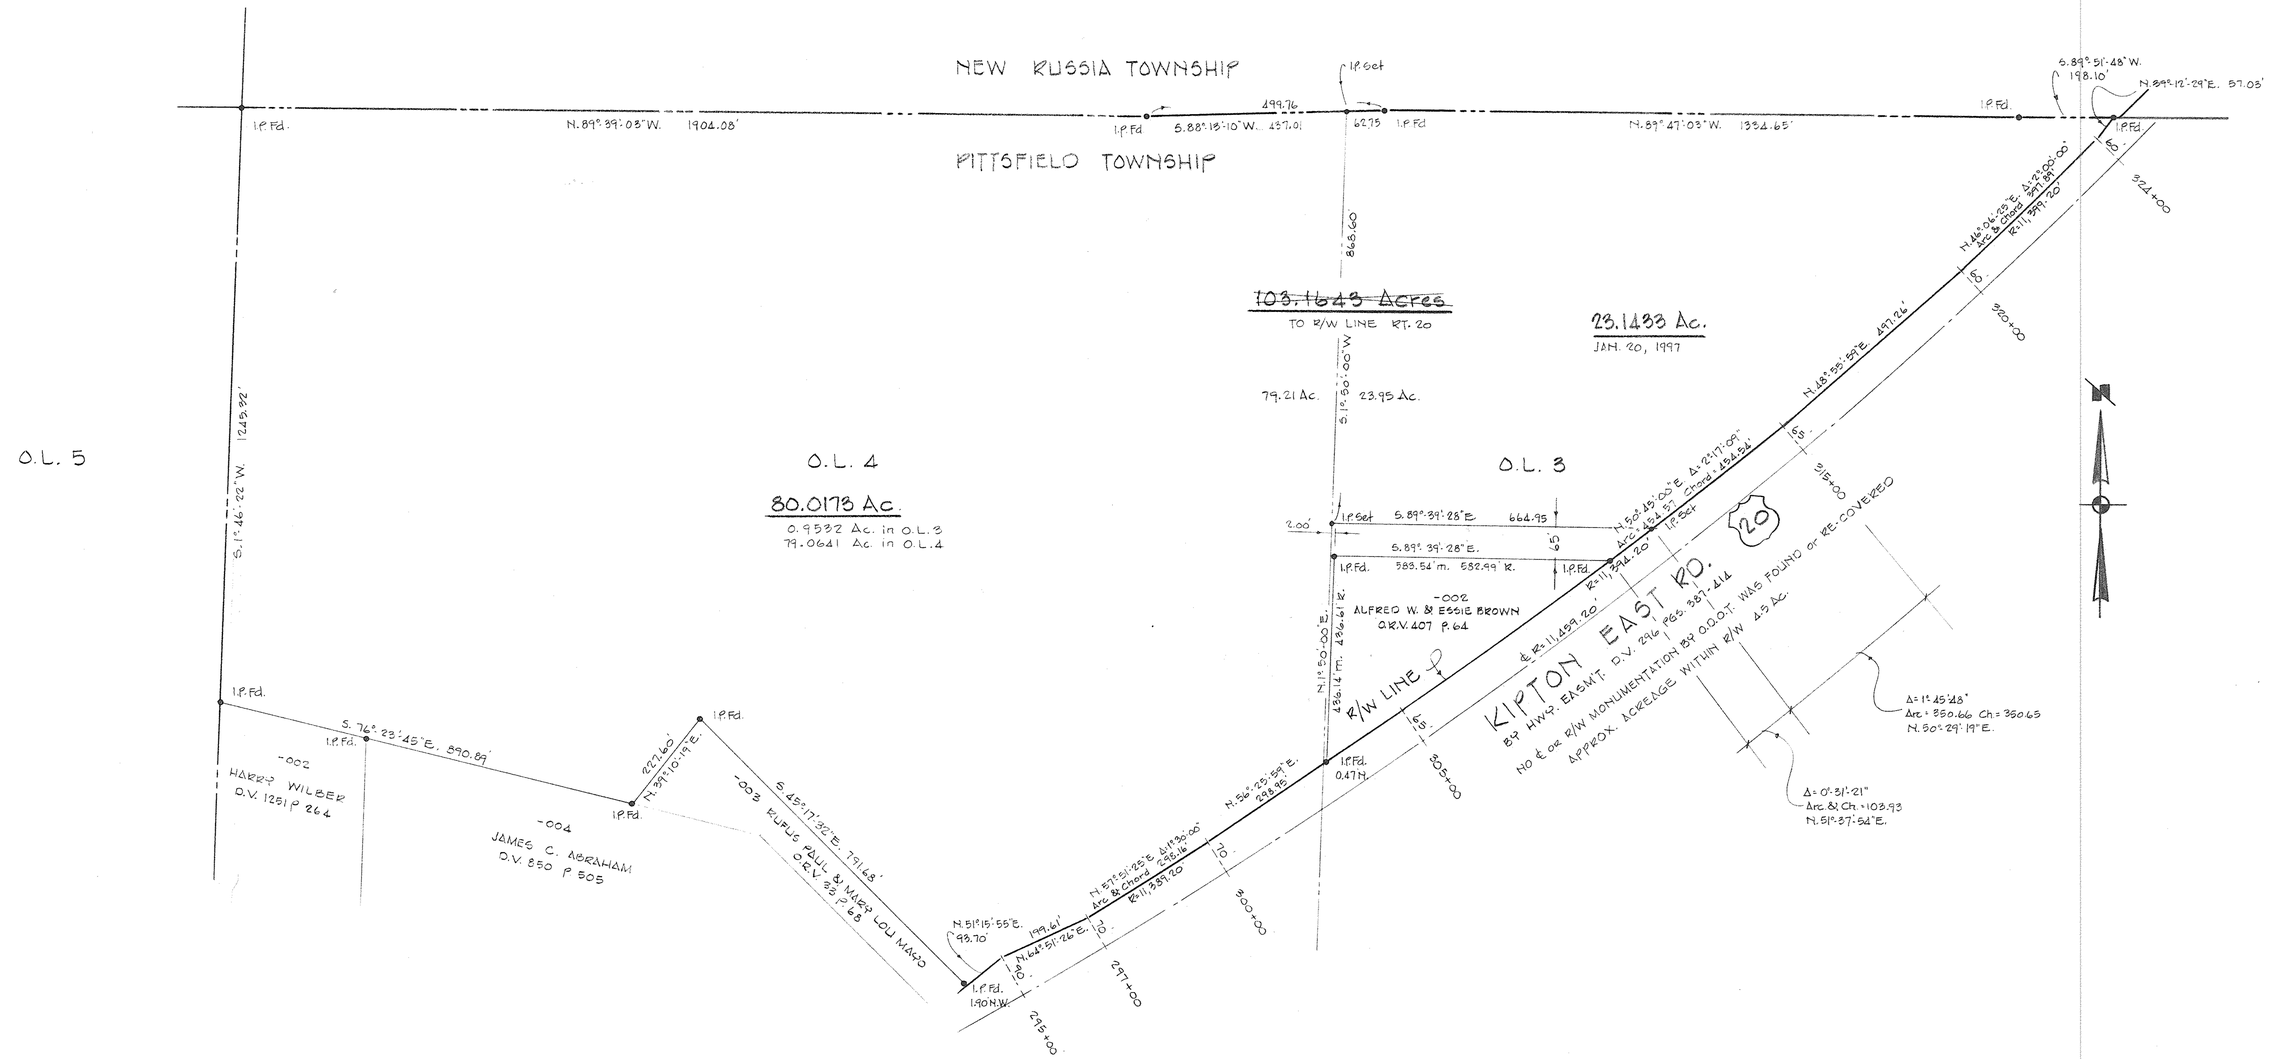

SURVEY FOR THE ESTATE
OF

MELVIN C. HURST

PART OF O.L.s 2 & 4 — TOWNSHIP OF PITTSFIELD
COUNTY OF LORAIN — STATE OF OHIO
SCALE 1" = 150' — AUGUST 1996

LAUNDON • SIMON • CAHL & ASSOC.
PROFESSIONAL LAND SURVEYORS
JOB No. 96-2871 — F.B. 229 P. 41-45

REV. JAN. 20, 1997 - 23.1433 Ac. REL.

14-00-004-000-006 14-C
14-00-003-000-018

338