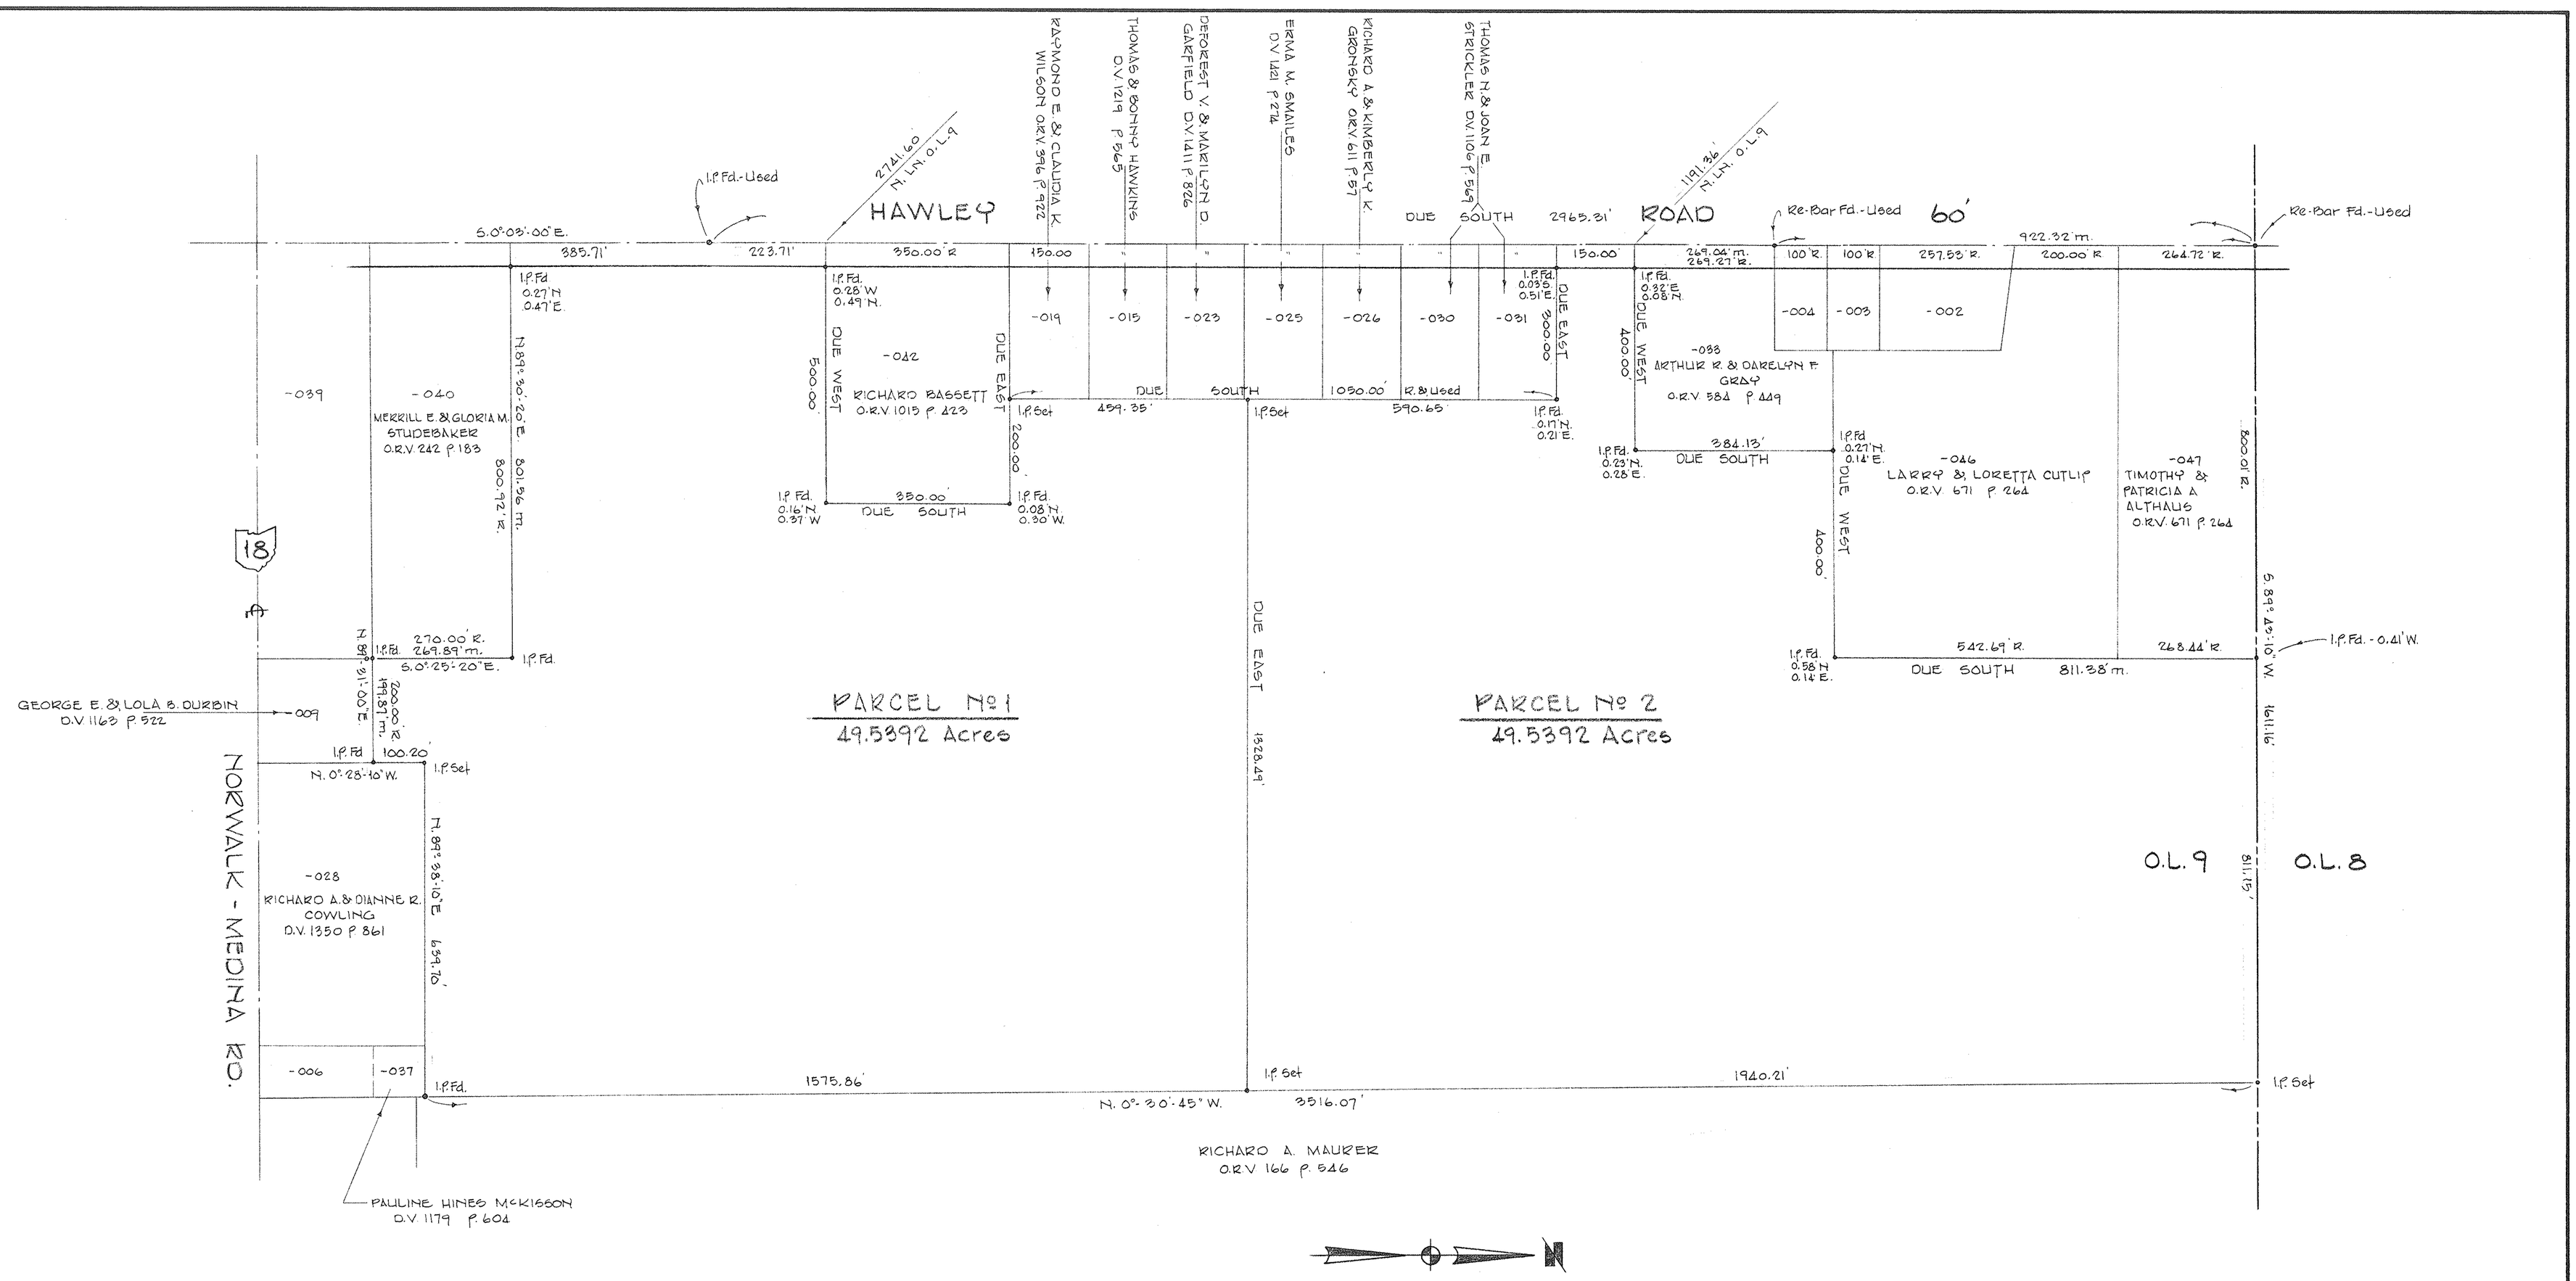

SURVEY FOR

MERRILL E. & GLORIA M. STUDEBAKER
AND
CYNTHIA BURGE

PART OF O.L. 9 TOWNSHIP OF WELLINGTON
COUNTY OF LORAIN STATE OF OHIO
SCALE 1"=150' DEC. 1995

LAUNDON · SIMON · CAHL & ASSOC.
PROFESSIONAL LAND SURVEYORS
JOB No 95-2797 FB. 238 P. 10-11

18-00-009.000-066 18-D 330

78-87