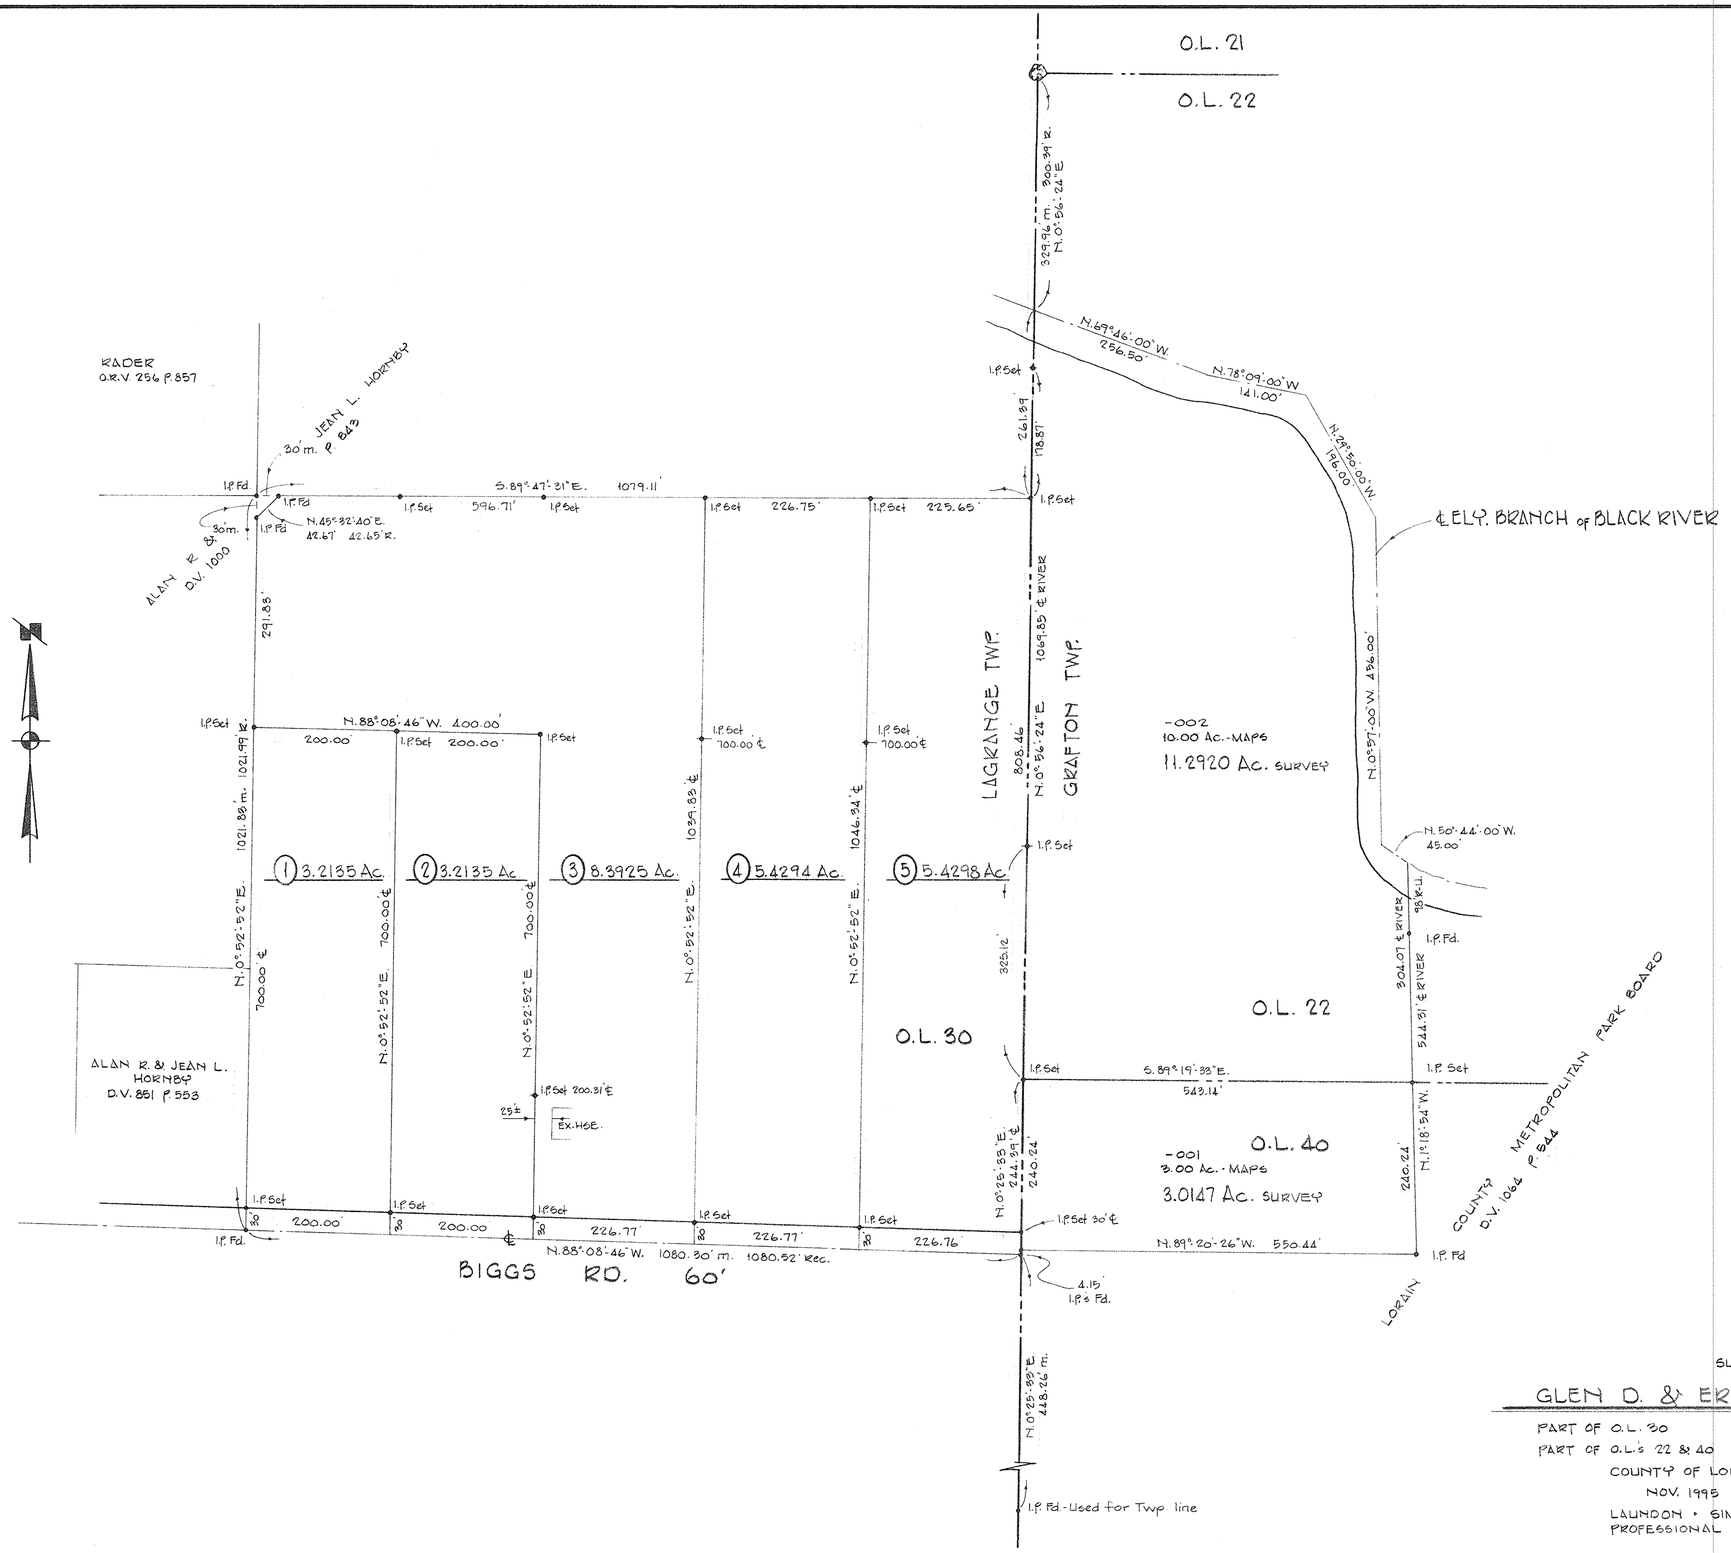

SURVEY FOR

GLEN D. & ERIC D. HOVATTER

PART OF O.L. 30 — TOWNSHIP OF LAGRANGE

PART OF O.L.'s 22 & 40 — TOWNSHIP OF GRAFTON

COUNTY OF LORAIN — STATE OF OHIO

NOV. 1995 — SCALE 1"=100'

LAUNDON • SIMON • CAHL & ASSOC.
PROFESSIONAL LAND SURVEYORS

95-2779 — FB. 238 P. 1,2+3

16-00-022-000-002 16-A

328