



EX. BLDG.

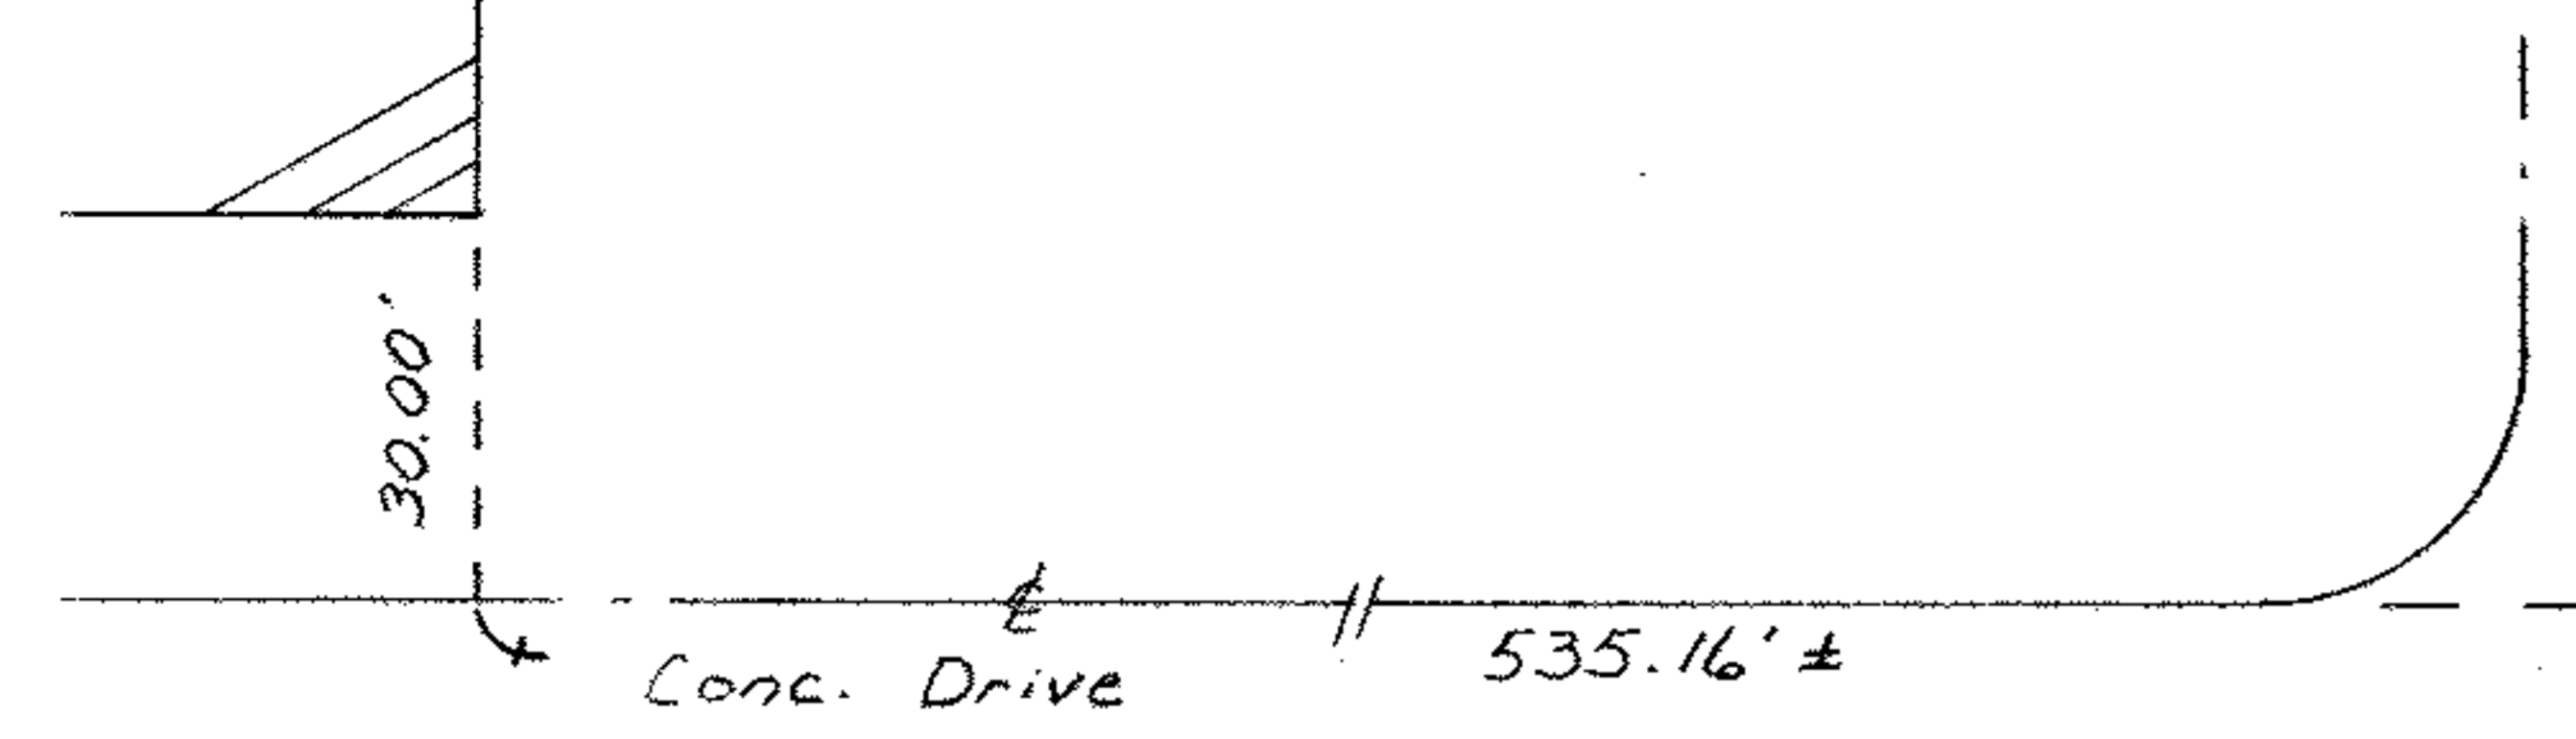

NORTH
ASSUMED
SCALE 1"=40'
NOVEMBER 1991

 

OHM CORPORATION
 SLUDGE PIT COORDINATES
 AT FISHER GUIDE SITE
 ELYRIA, OHIO
 LAUNDON · SIMON · CAHL & ASSOC.
 110 MIDDLE AVE. ELYRIA, O. 44035 91-2121

7/27/95