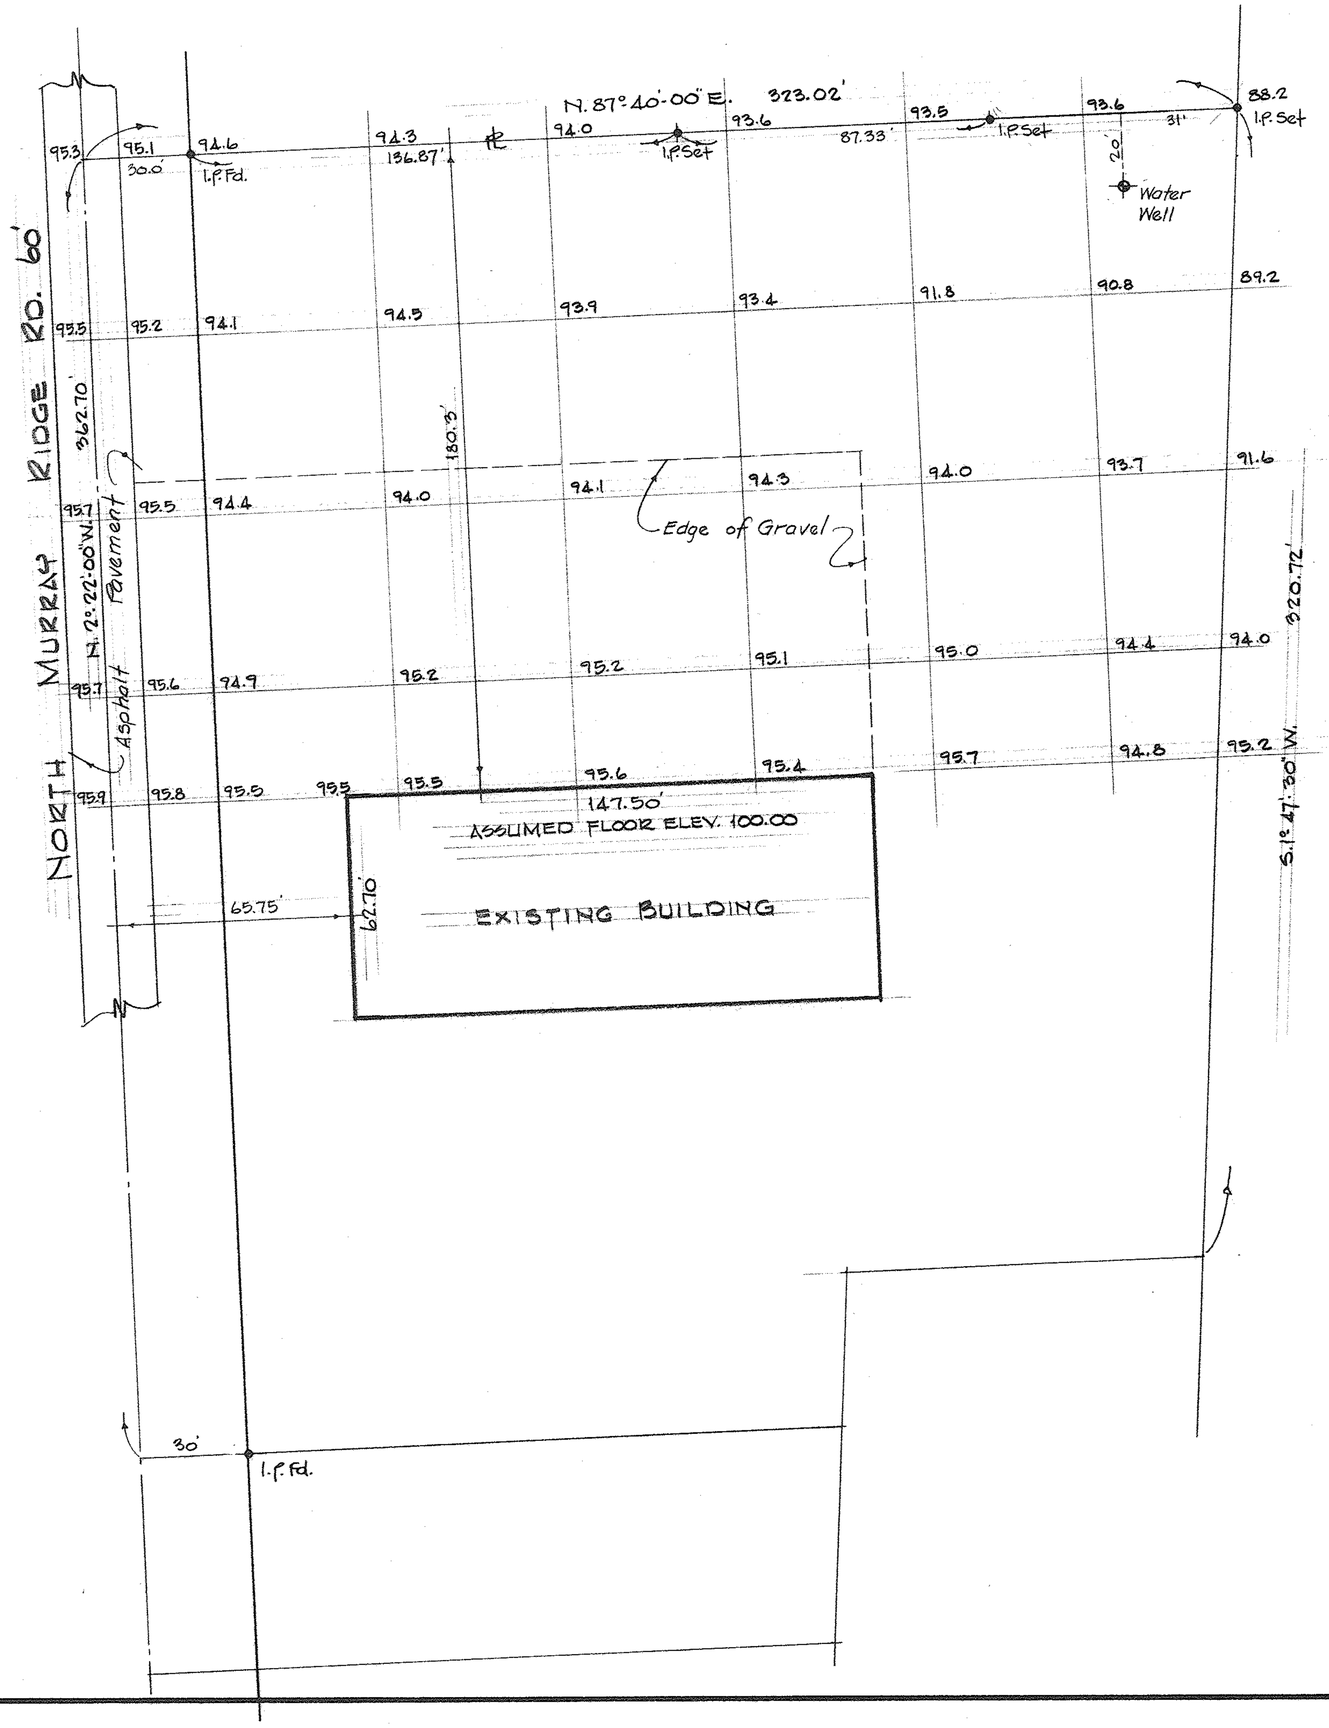

TOPOGRAPHICAL SURVEY FOR

ROADWAY SERVICES INC.

8055 NORTH MURRAY RIDGE ROAD
ELYRIA, OHIO

FEBRUARY 1992 SCALE 1" = 30'

LAUNDON • SIMON • CAHL & ASSOC.
ENGINEERS SURVEYORS
110 MIDDLE AVE. ELYRIA, OH. 44035
216-322-7625

92-2151

06-24-021-000-055 06-95

267