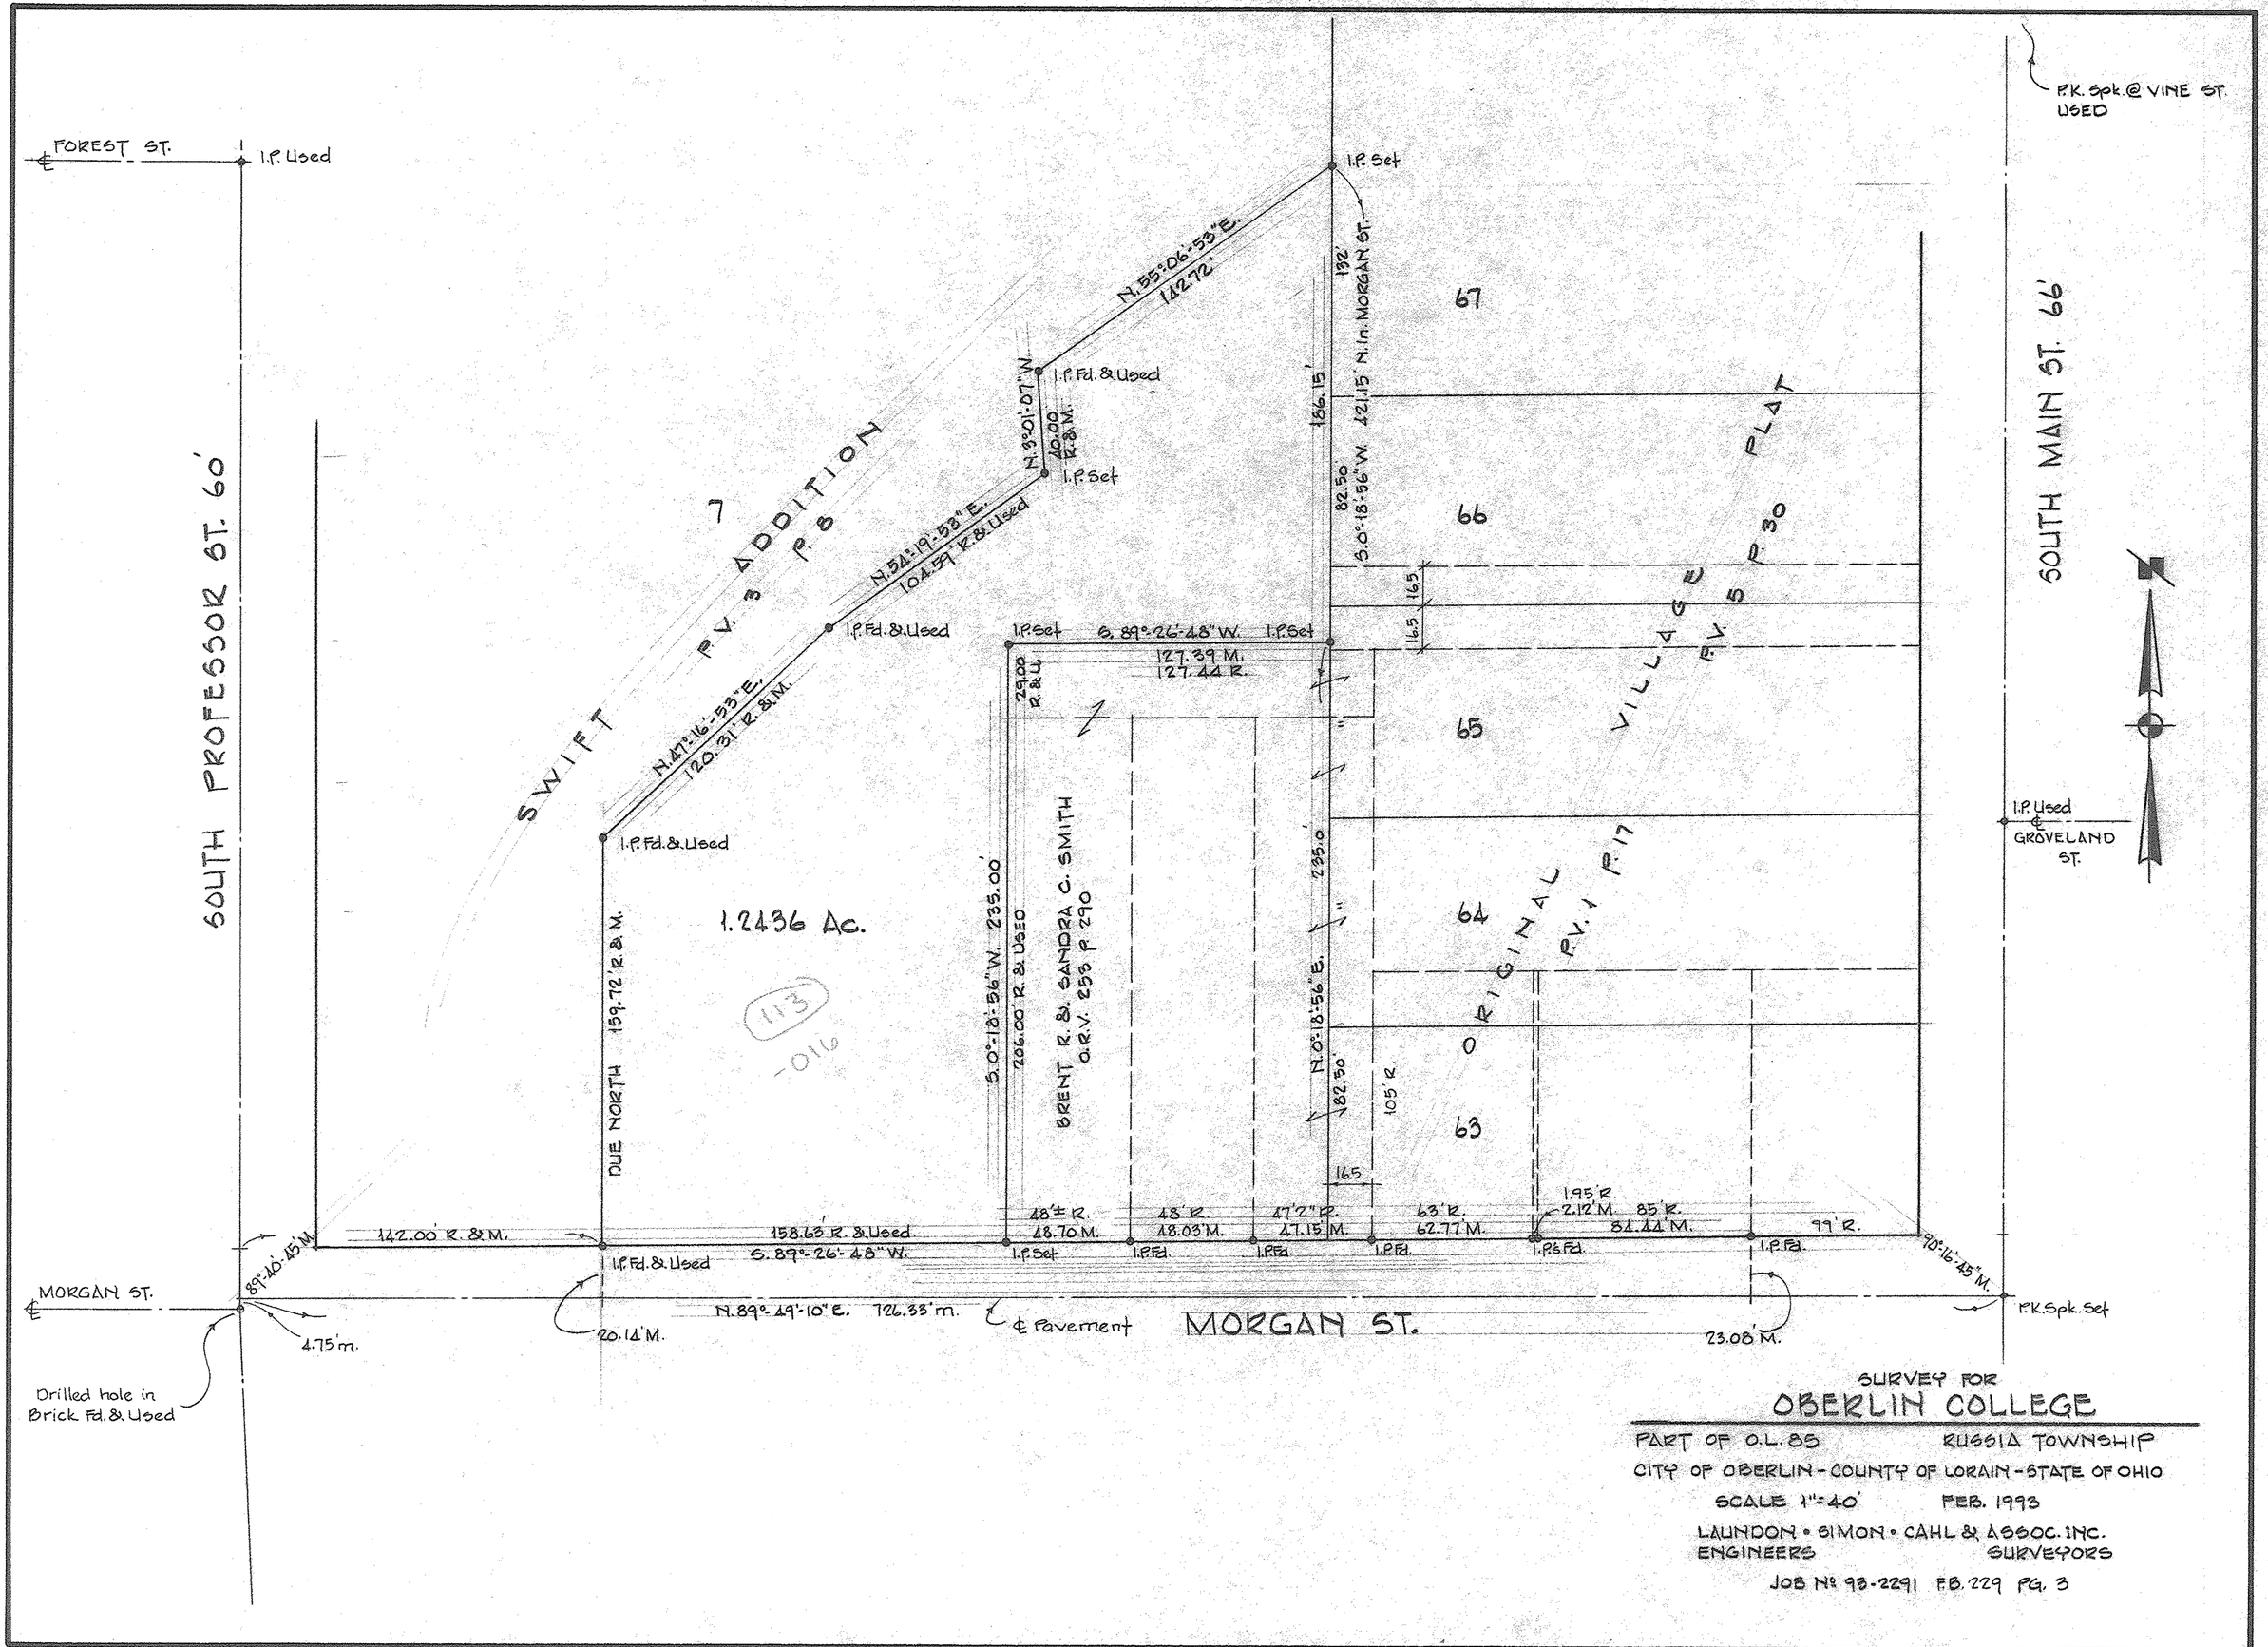

SURVEY FOR

OBERLIN COLLEGE

PART OF O.L. 85 RUSSIA TOWNSHIP

CITY OF OBERLIN - COUNTY OF LORAIN - STATE OF OHIO

SCALE 1"=40' FEB. 1993

LAUNDON • SIMON • CAHL & ASSOC. INC.

ENGINEERS SURVEYORS

JOB Nº 93-2291 F.B. 229 PG. 3

113
-016

09-00-085-113-016

09-00-085-B

276