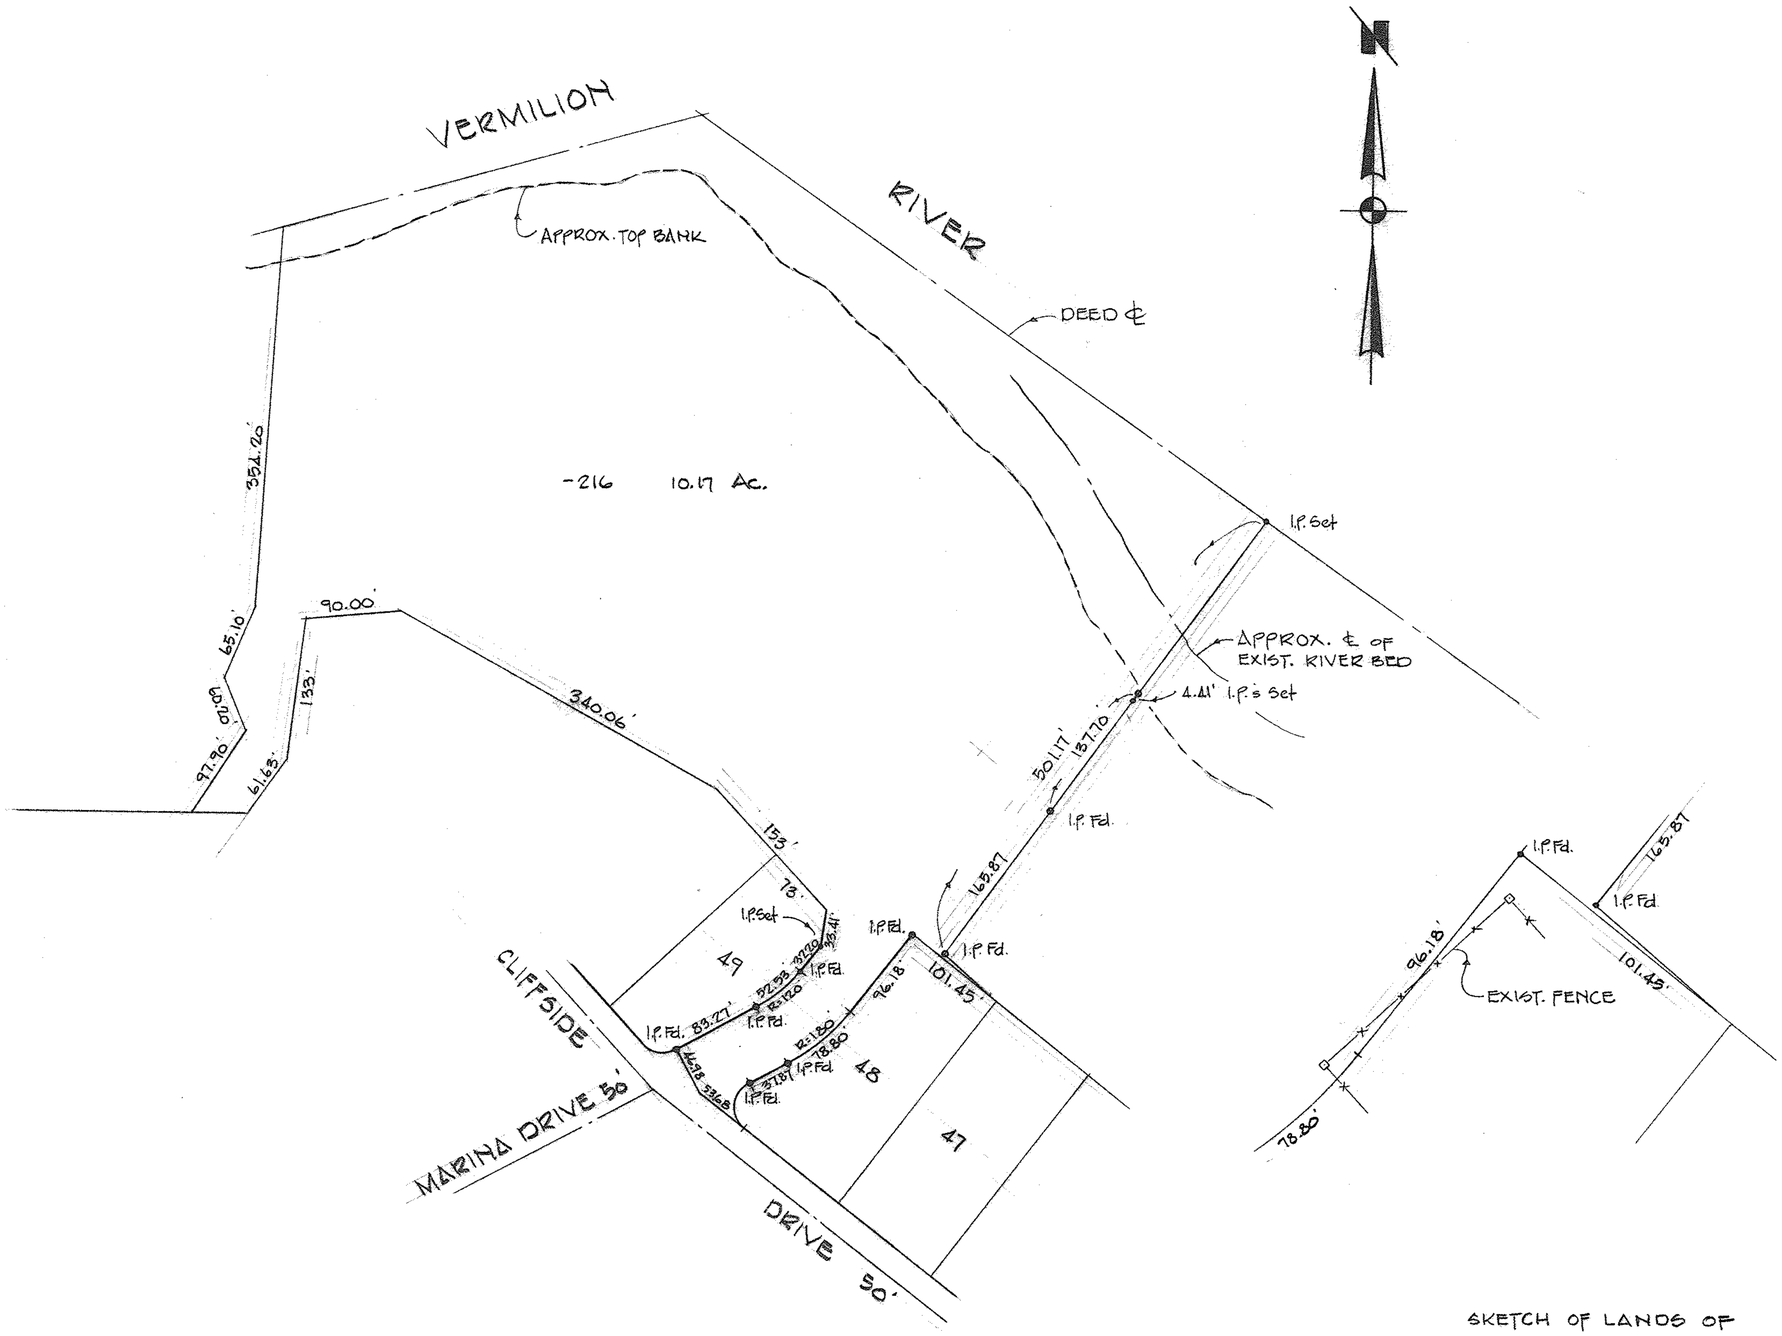

SKETCH OF LANDS OF

ROGER & GERALDINE MEDLIN

O.R.V. 532 PAGE 353

PART OF O.L. 17 TOWNSHIP OF BROWNHELM

COUNTY OF LORAIN STATE OF OHIO

SCALE 1" = 100' FEB. 1993

LAUNDON • SIMON • CAHL & ASSOC.

ENGINEERS SURVEYORS 92-2222

01-00-017-B

01-00-017-000-216

278