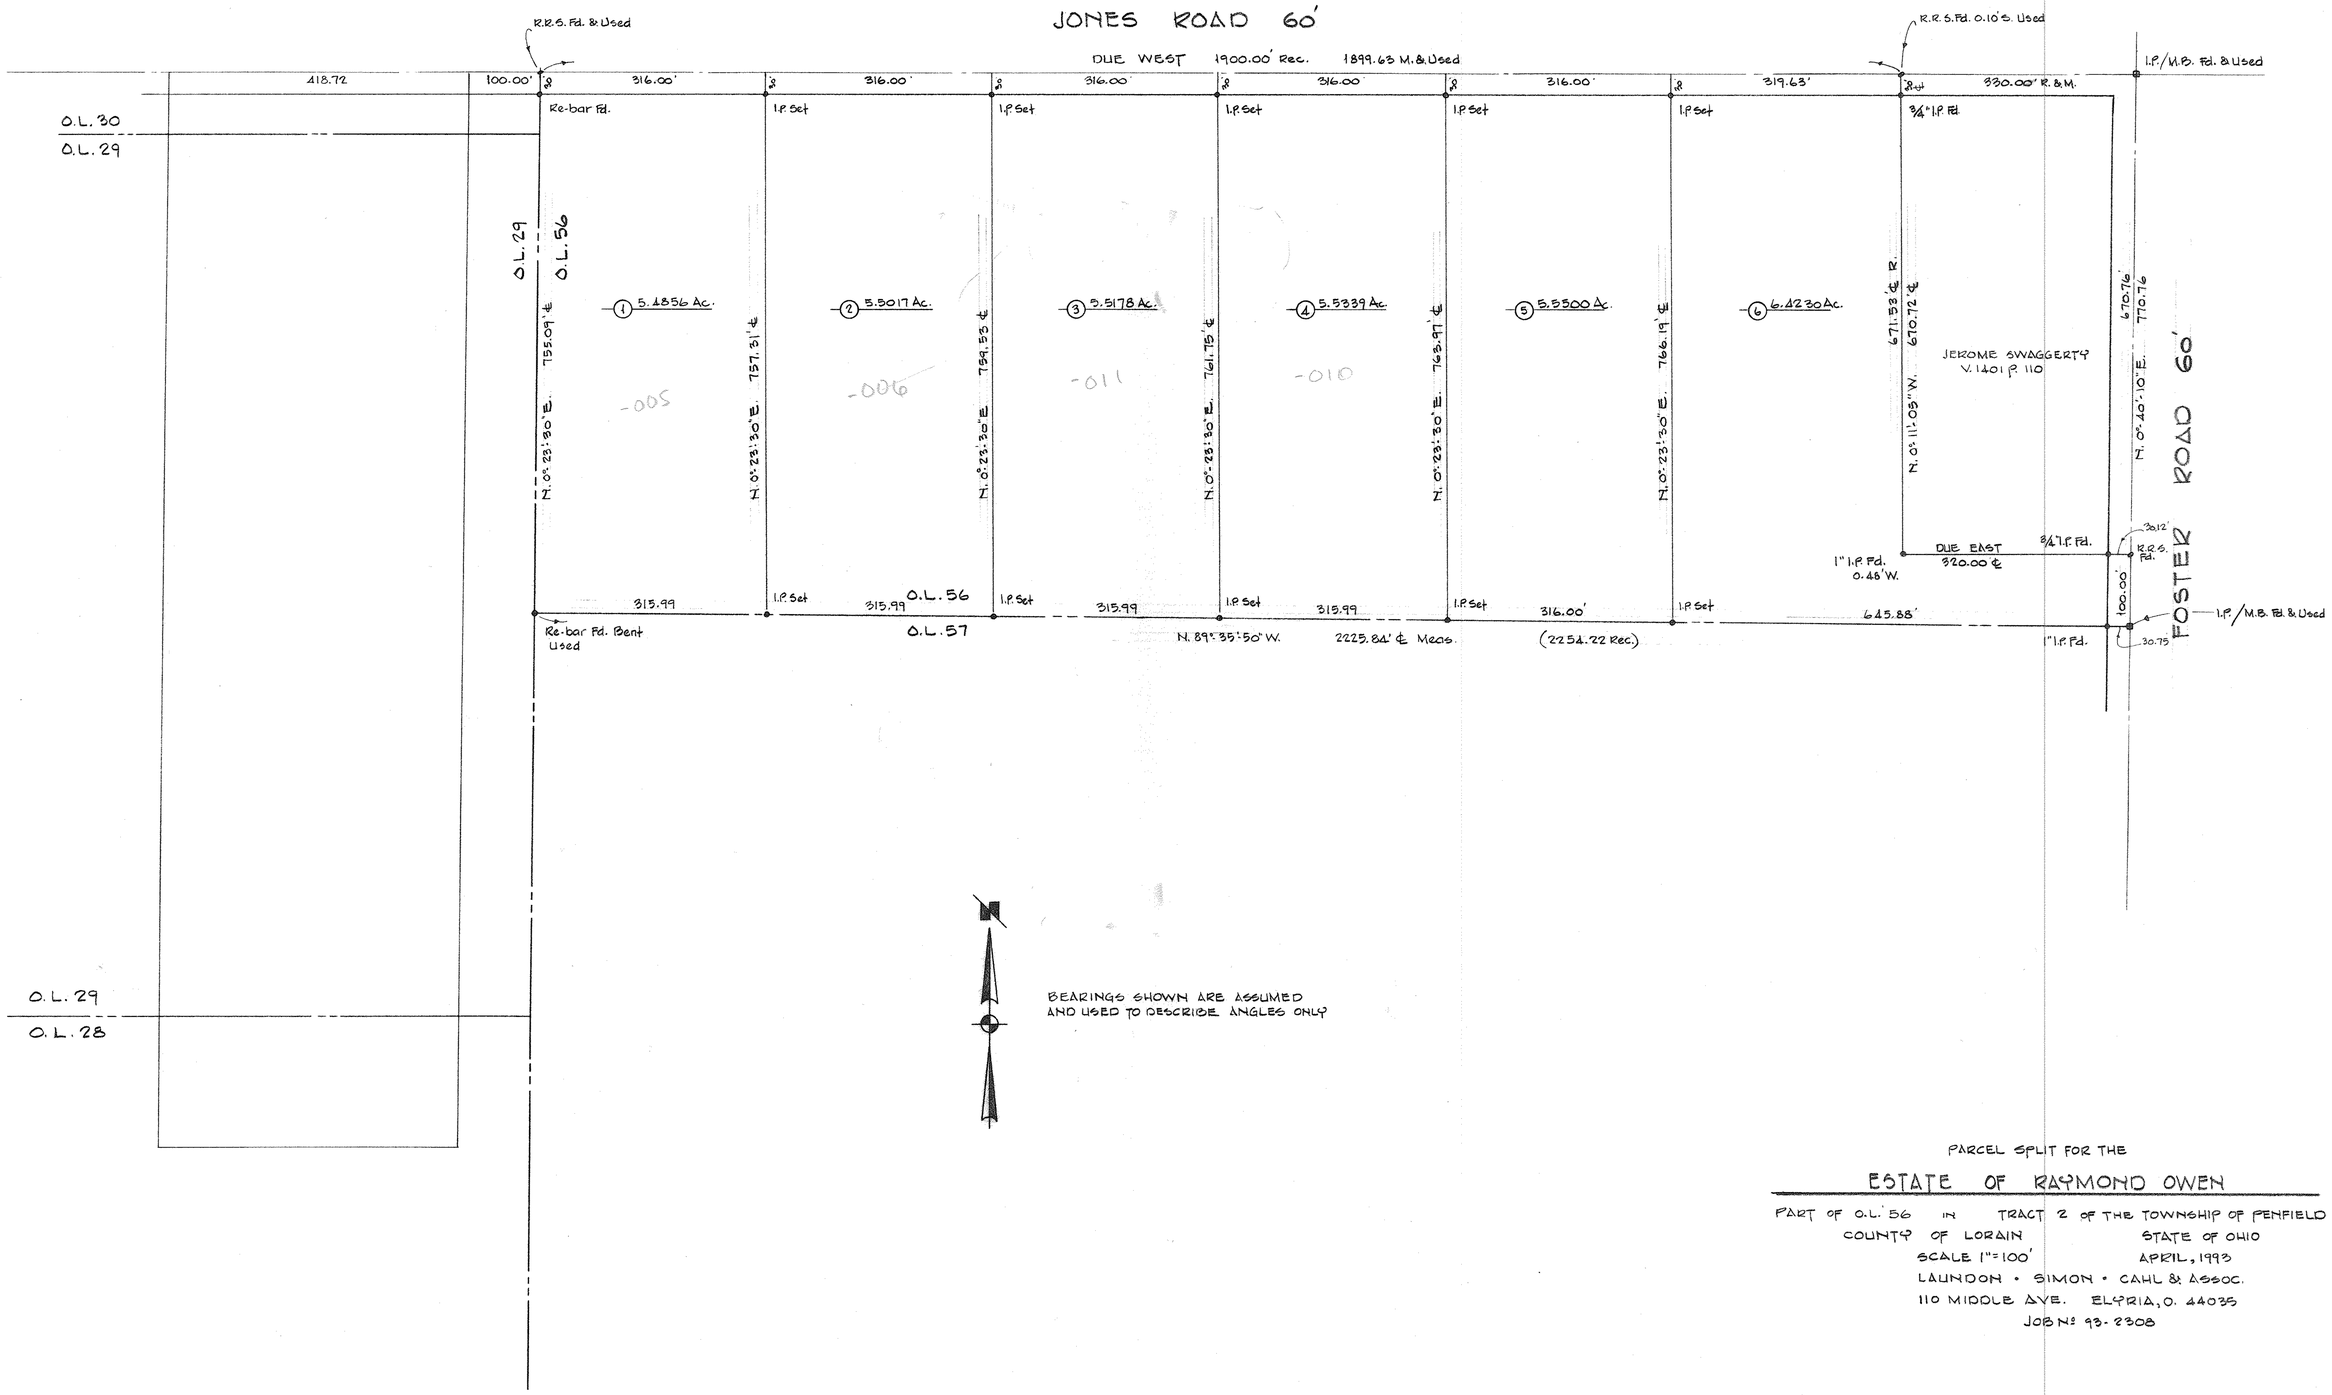

PARCEL SPLIT FOR THE

ESTATE OF RAYMOND OWEN

PART OF O.L. 56 IN TRACT 2 OF THE TOWNSHIP OF PENFIELD
COUNTY OF LORAIN STATE OF OHIO
SCALE 1"=100' APRIL, 1993
LAUNDON • SIMON • CAHL & ASSOC.
110 MIDDLE AVE. ELYRIA, O. 44035
JOB Nº 93-2308

REV. 6-29-93 Corr. Brg. Foster Rd. to N.0°40'10"E.

19-02-056-000-005, -010
-006
-011

19-H 295