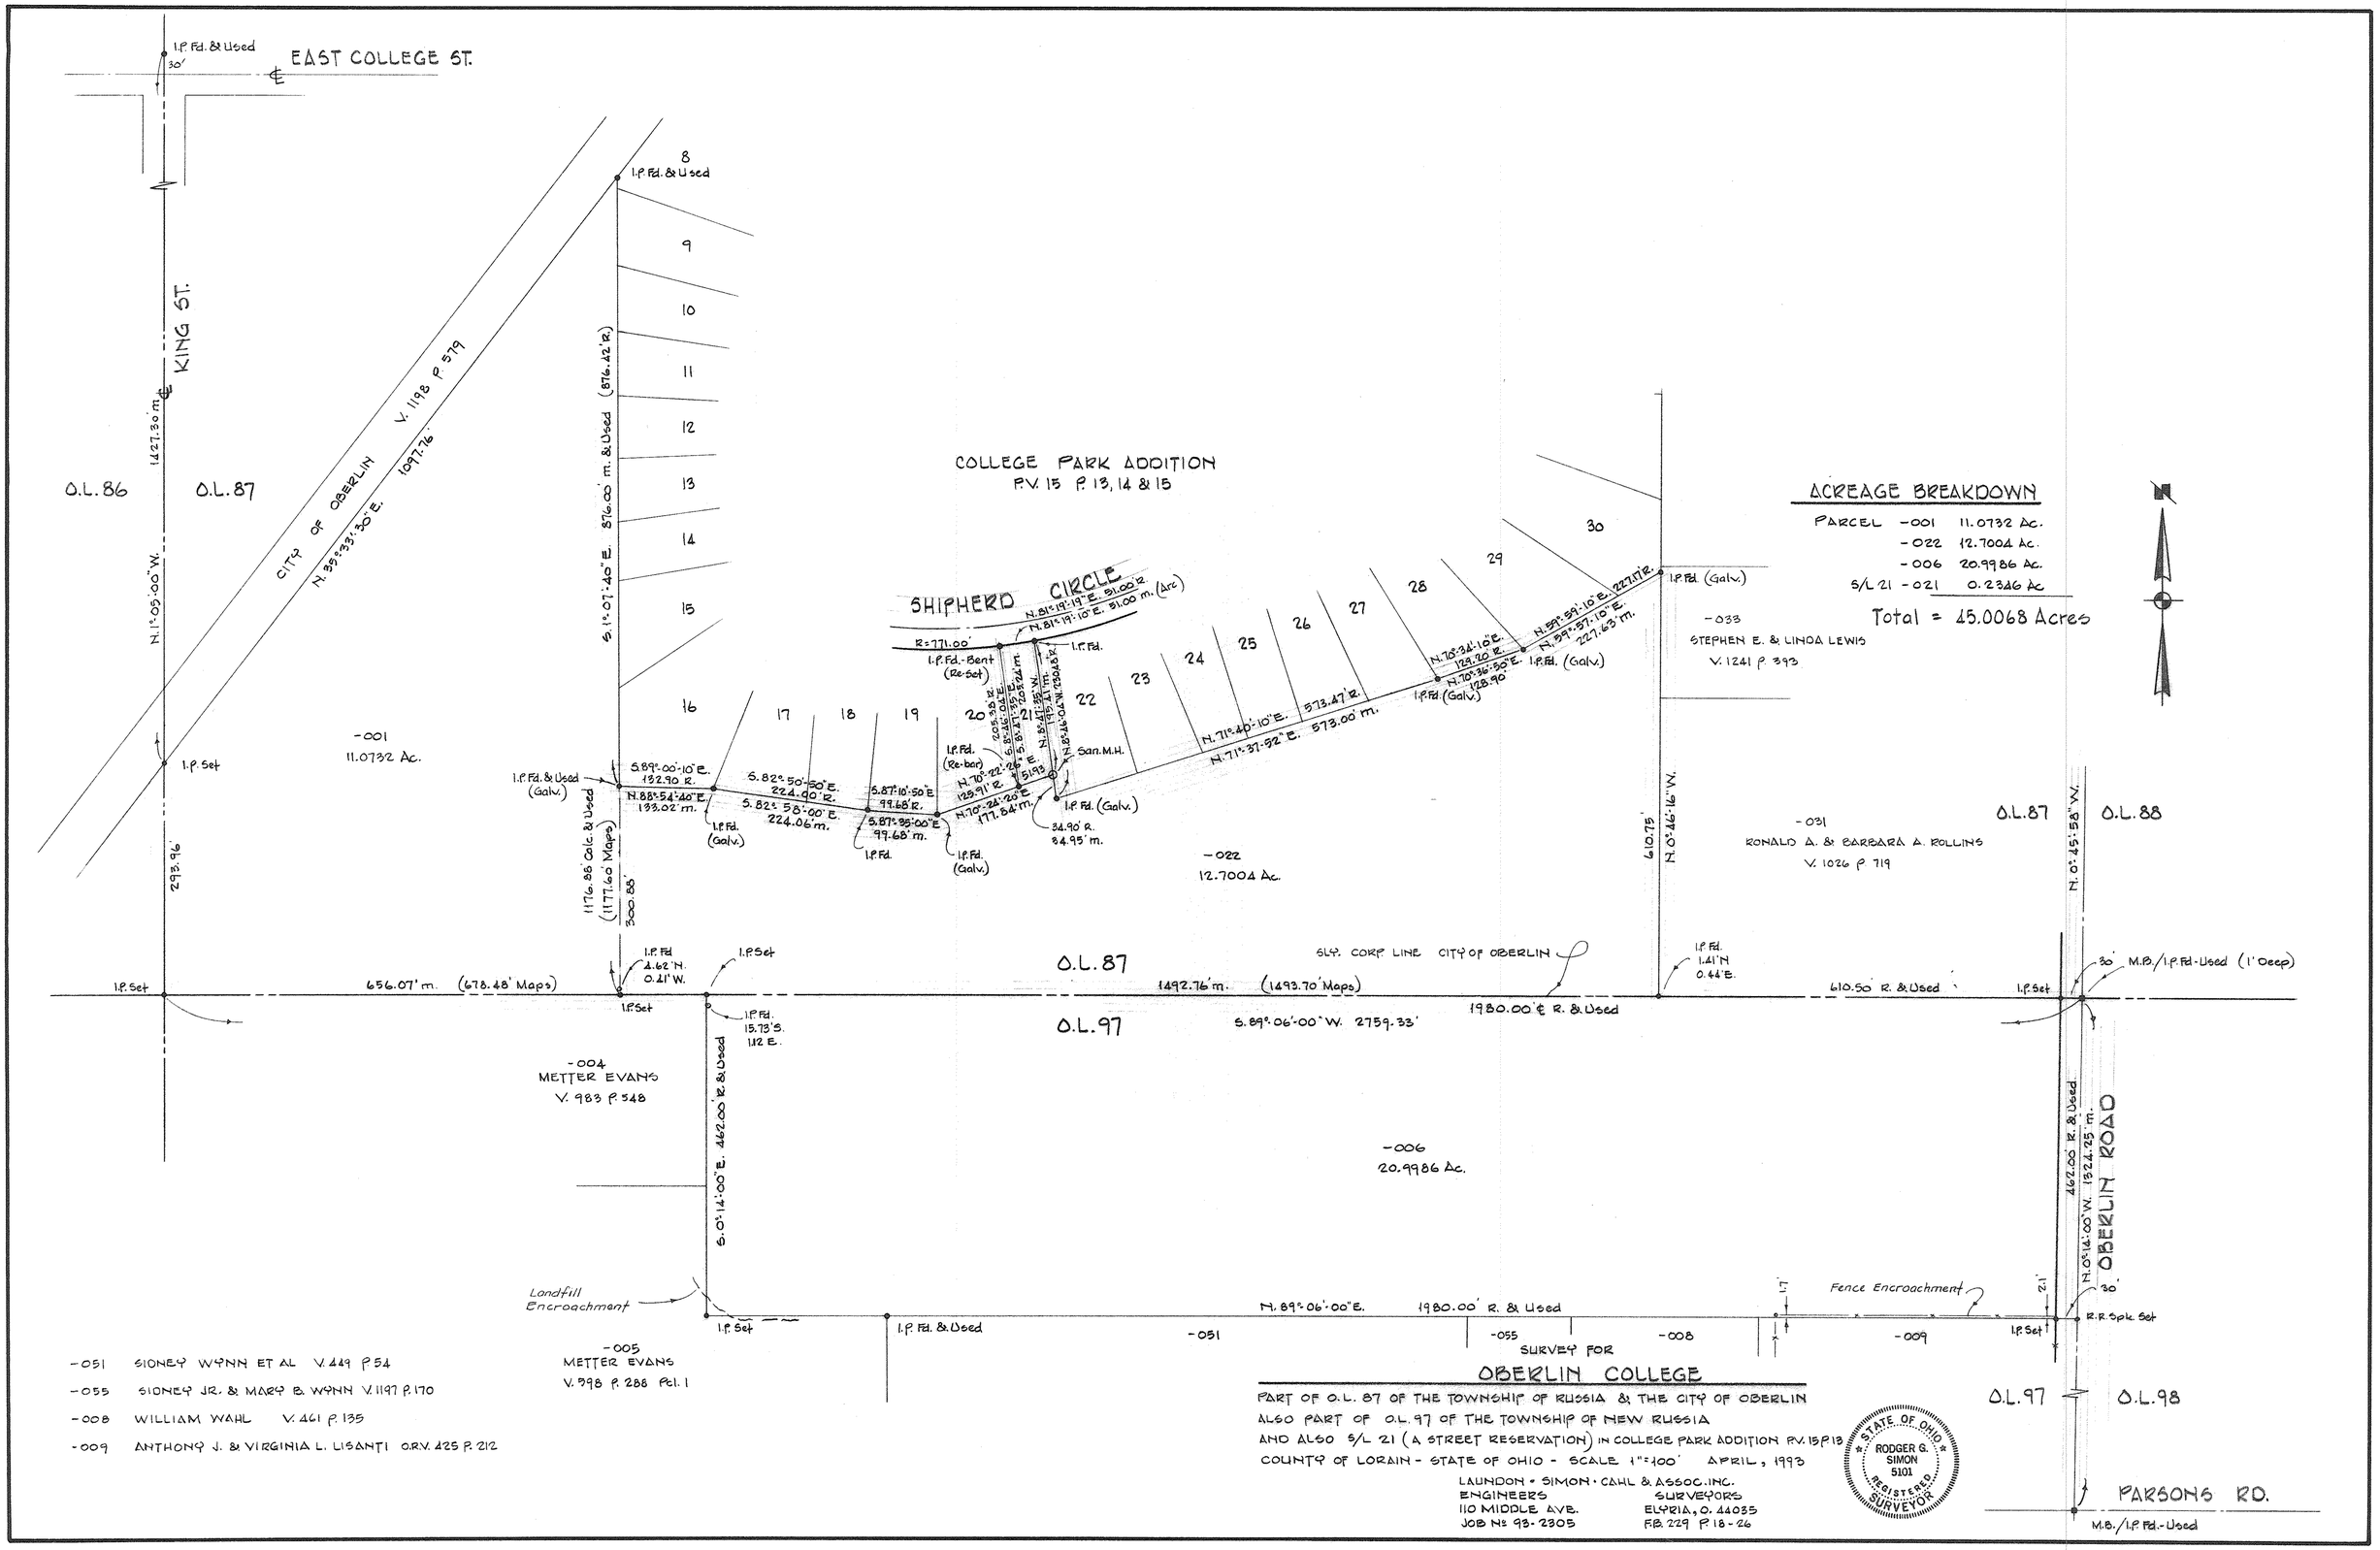

09-00-087-105-022 09-00-087-B
09-00-097-000-006 09-00-097-B

287