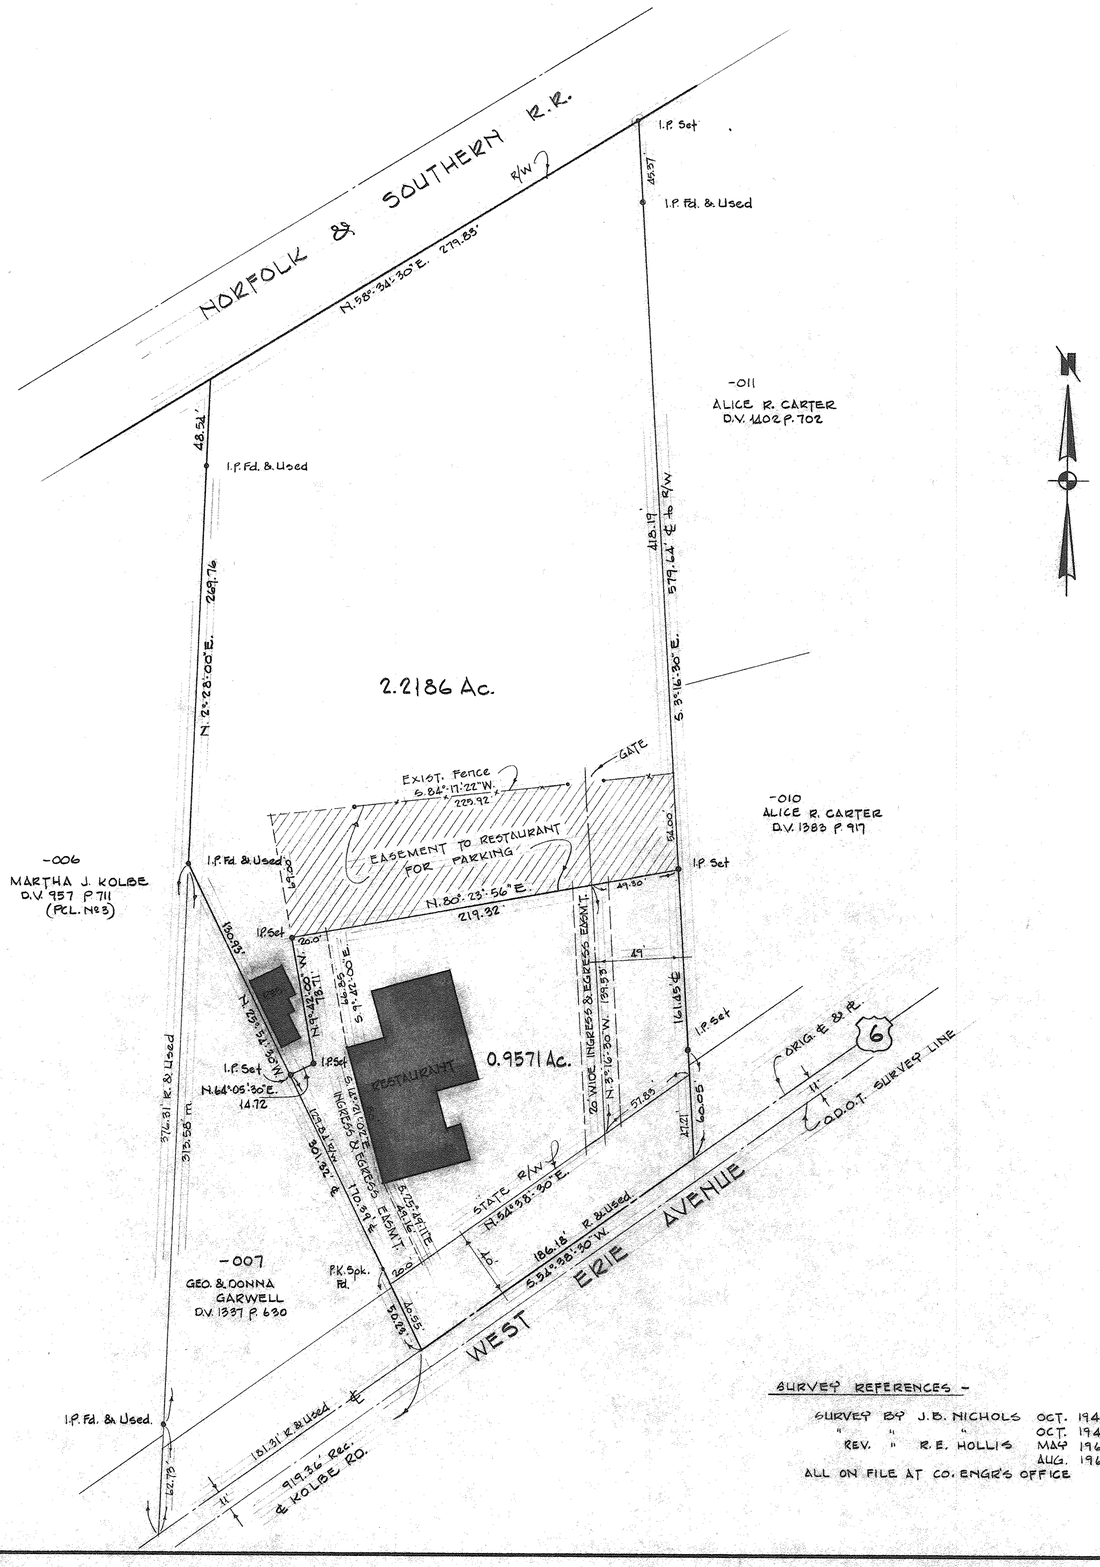

SURVEY REFERENCES -

SURVEY BY	J.B. NICHOLS	OCT.	1945
" "	"	OCT.	1947
REV. "	R.E. HOLLIS	MAY	1969
		AUG.	1966

ALL ON FILE AT CO. ENGR'S OFFICE

SURVEY FOR

PLOMARITIS ENTERPRISES INC.

PART OF O.L. 1 TRACT Nº 3 BLACK RIVER TOWNSHIP
CITY OF LORAIN COUNTY OF LORAIN STATE OF OHIO
SCALE 1"=40' DECEMBER, 1992

LAUNDON • SIMON • CAHL & ASSOC.
ENGINEERS SURVEYORS
110 MIDDLE AVE. ELYRIA, O. 44035

JOB Nº 92-2277
F.B. 226 P. 63

REV. FEB. 22, '93
REV. FEB. 3, '93

02-03-001-102-029 02-03-001-B 286