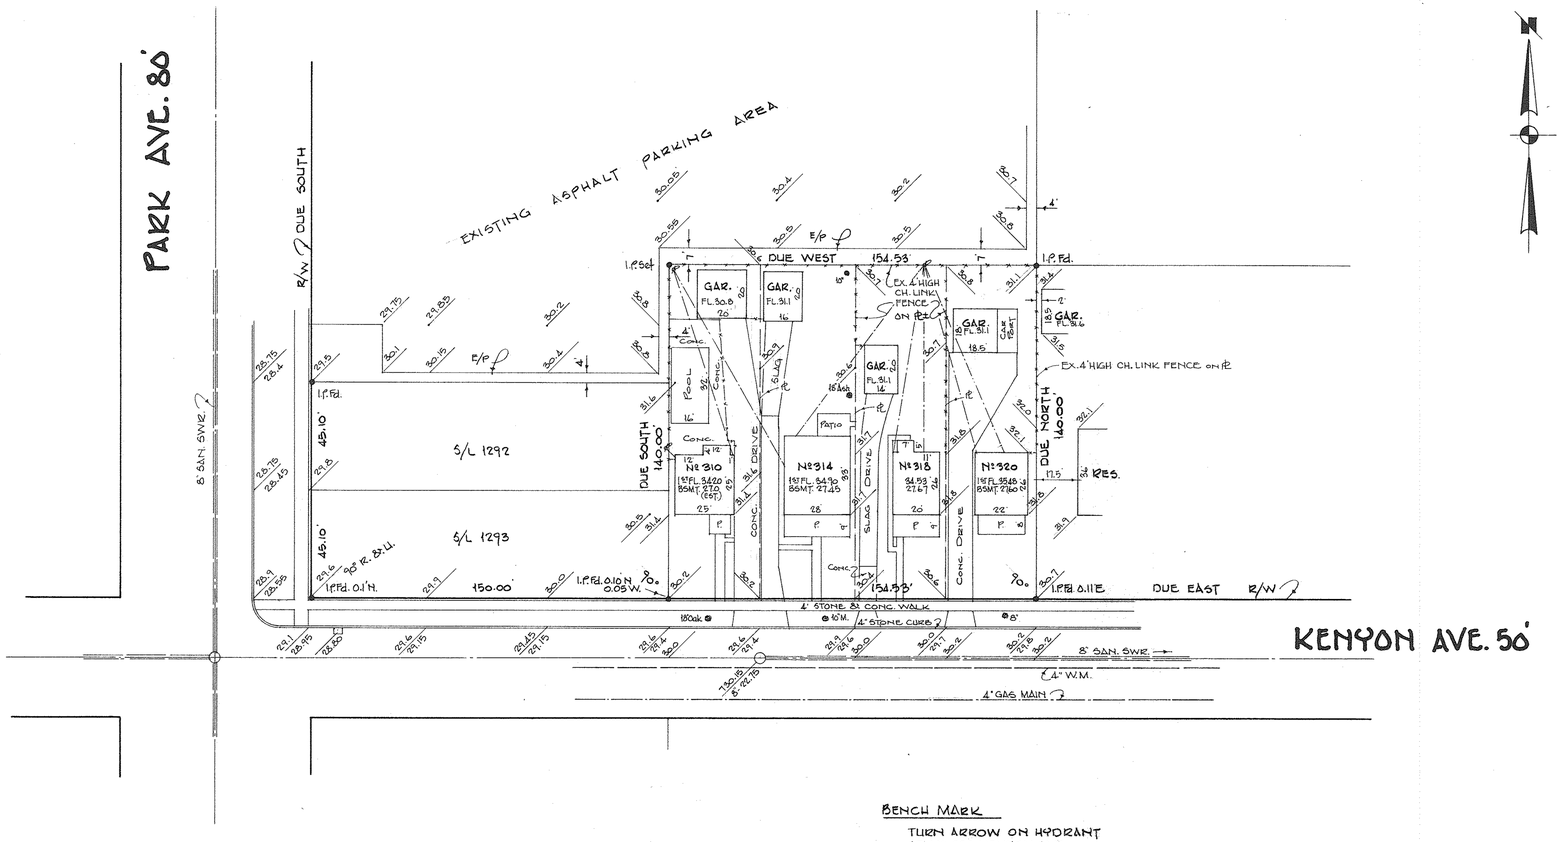

BENCH MARK

TURN ARROW ON HYDRANT
AT Nº 329 KENYON AVE.
ELEV. 732.64

NOTE -

ADD 700.00 TO ELEVATIONS SHOWN
FOR U.S.G.S. & CITY DATUM.

BOUNDARY AND TOPOGRAPHICAL SURVEY

ELYRIA MEMORIAL HOSPITAL

S/Ls 12, 13 & 22 IN HILL REALTY CO'S. SUB'N. Nº 1 P.V. 6 P. 55
PART of O.L.s 70 & 76 EAST of BLACK RIVER IN THE TOWNSHIP of ELYRIA
CITY of ELYRIA COUNTY of LORAIN STATE of OHIO

SCALE 1" = 30' APRIL, 1991

LAUNDON • SIMON • CAHL & ASSOC.
ENGINEERS SURVEYORS
106 MIDDLE AVE. ELYRIA, OHIO

91-2035

06-25-076-102-021 THRU -024 06-122 269