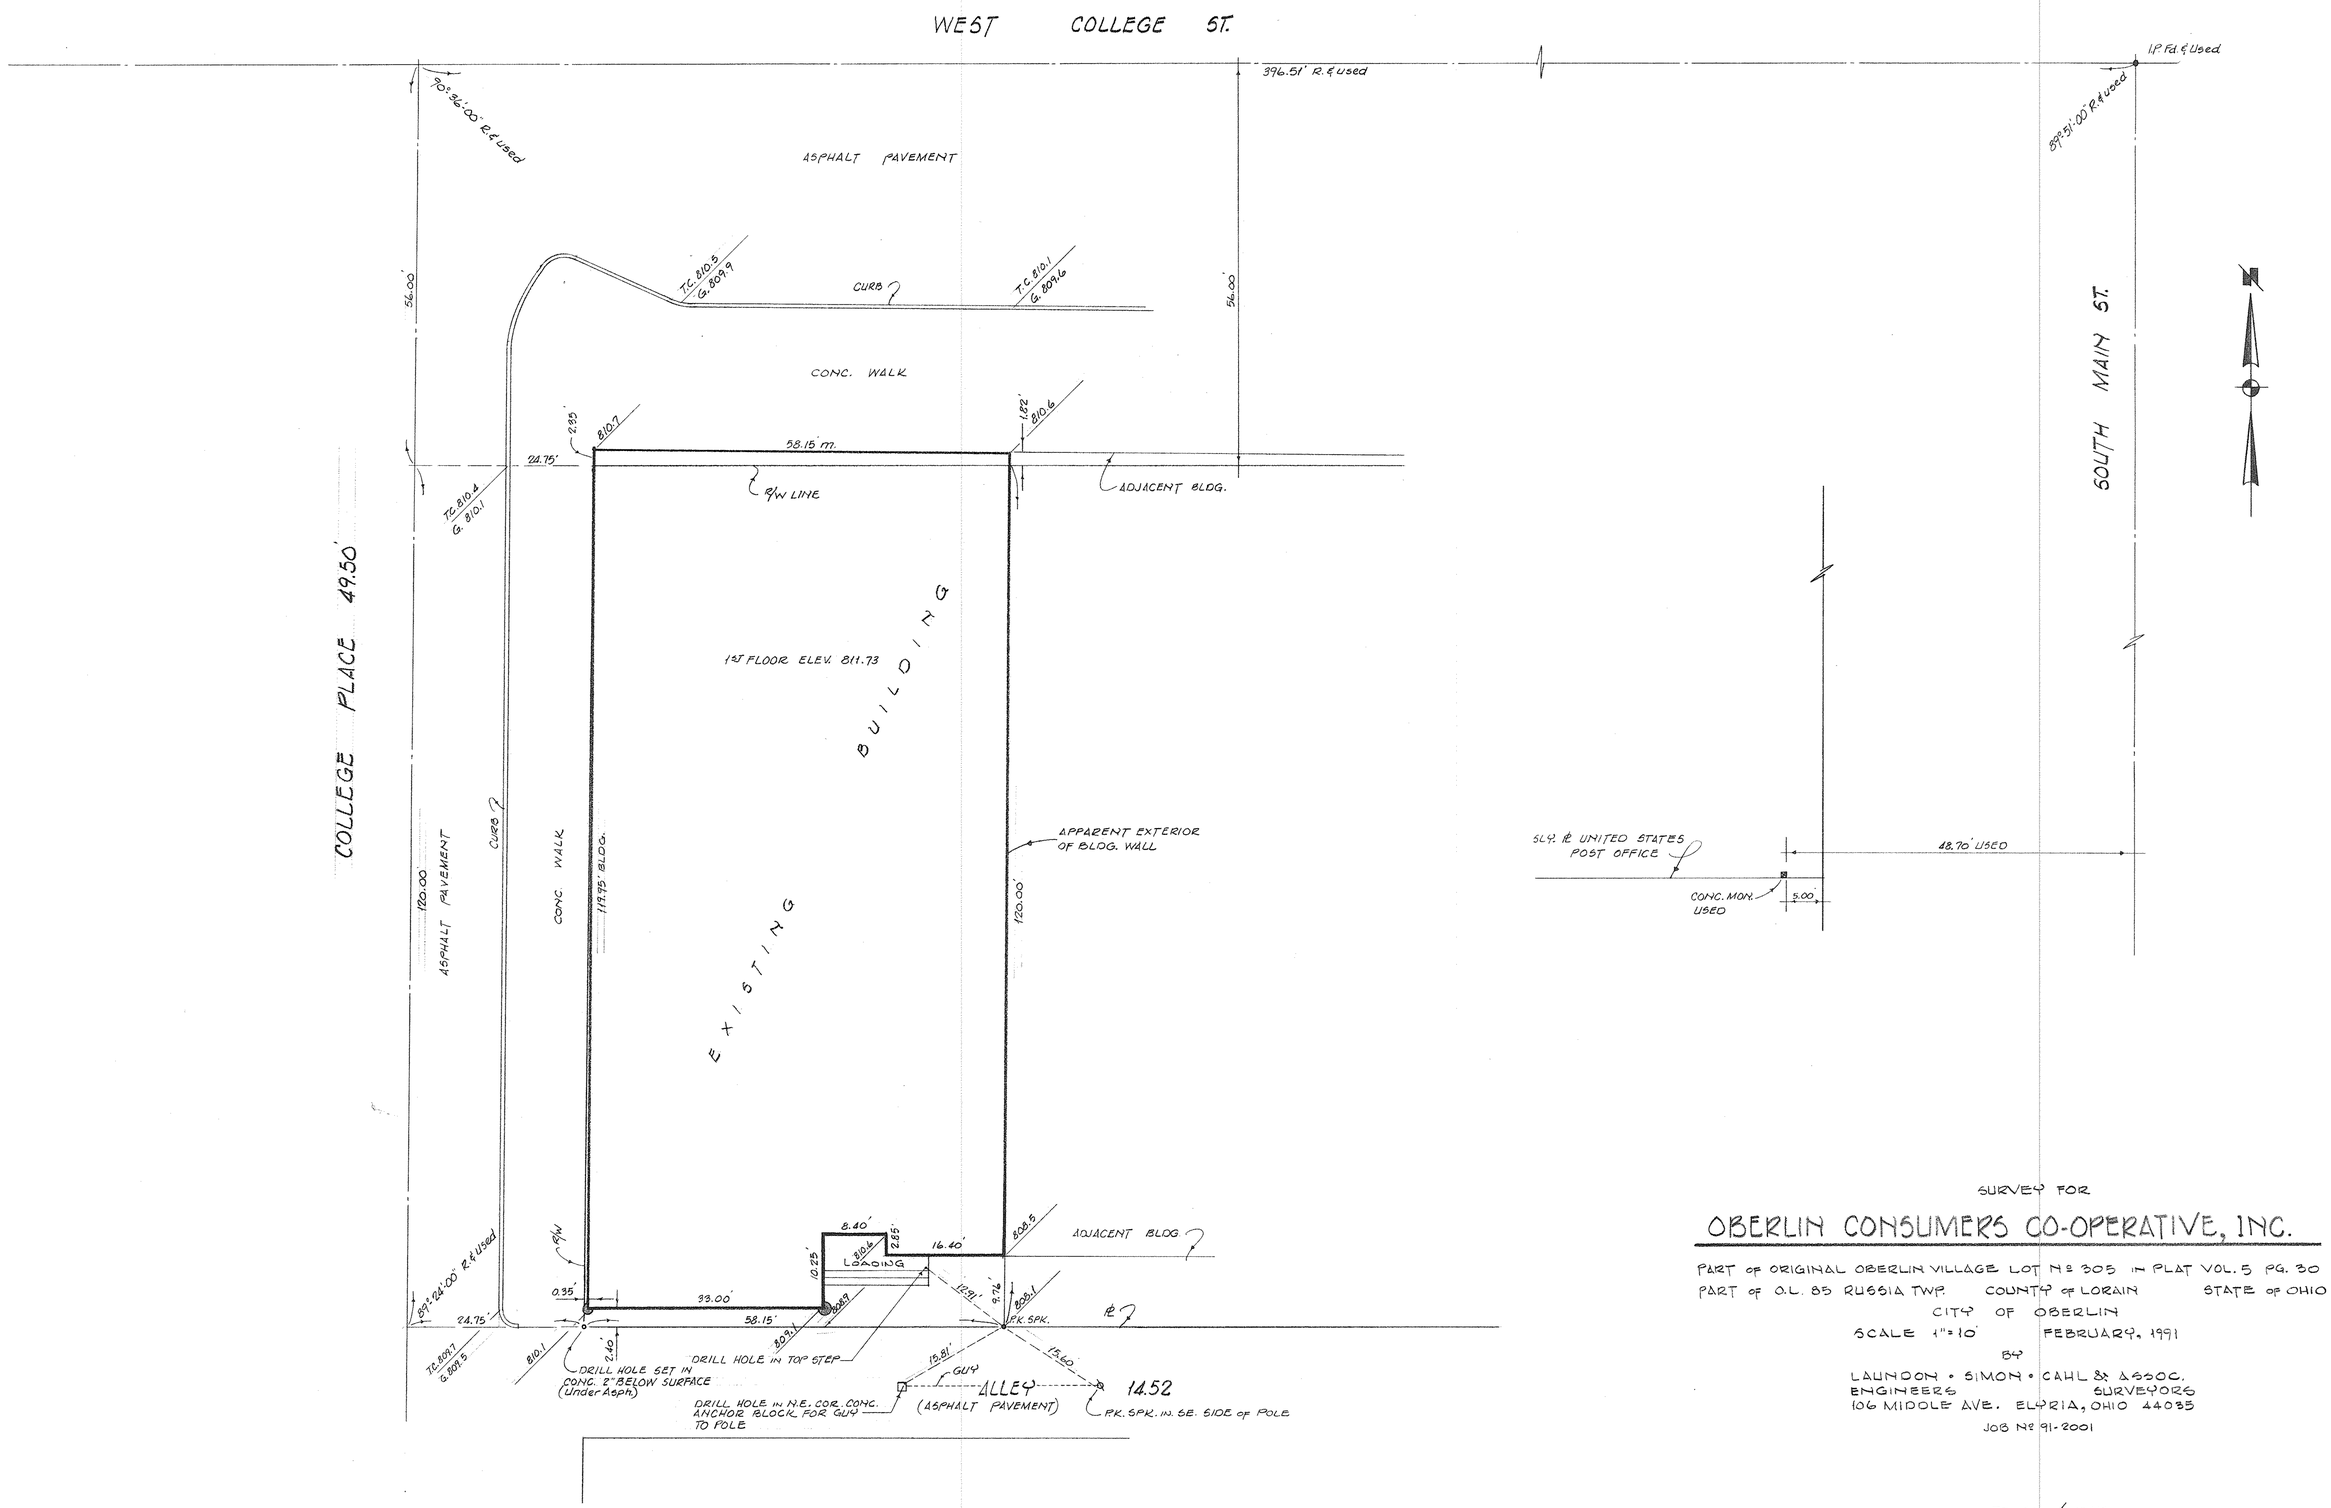

SURVEY FOR

OBERLIN CONSUMERS CO-OPERATIVE, INC.

PART OF ORIGINAL OBERLIN VILLAGE LOT Nº 305 IN PLAT VOL. 5 PG. 30
PART OF O.L. 85 RUSSIA TWP. COUNTY OF LORAIN STATE OF OHIO
CITY OF OBERLIN
SCALE 1" = 10' FEBRUARY, 1991
BY
LAUNDON • SIMON • CAHL & ASSOC.
ENGINEERS SURVEYORS
106 MIDDLE AVE. ELYRIA, OHIO 44035
JOB Nº 91-2001

FB. 220/11, 12 & 13

09-00-085-112-001 09-00-085 B 260