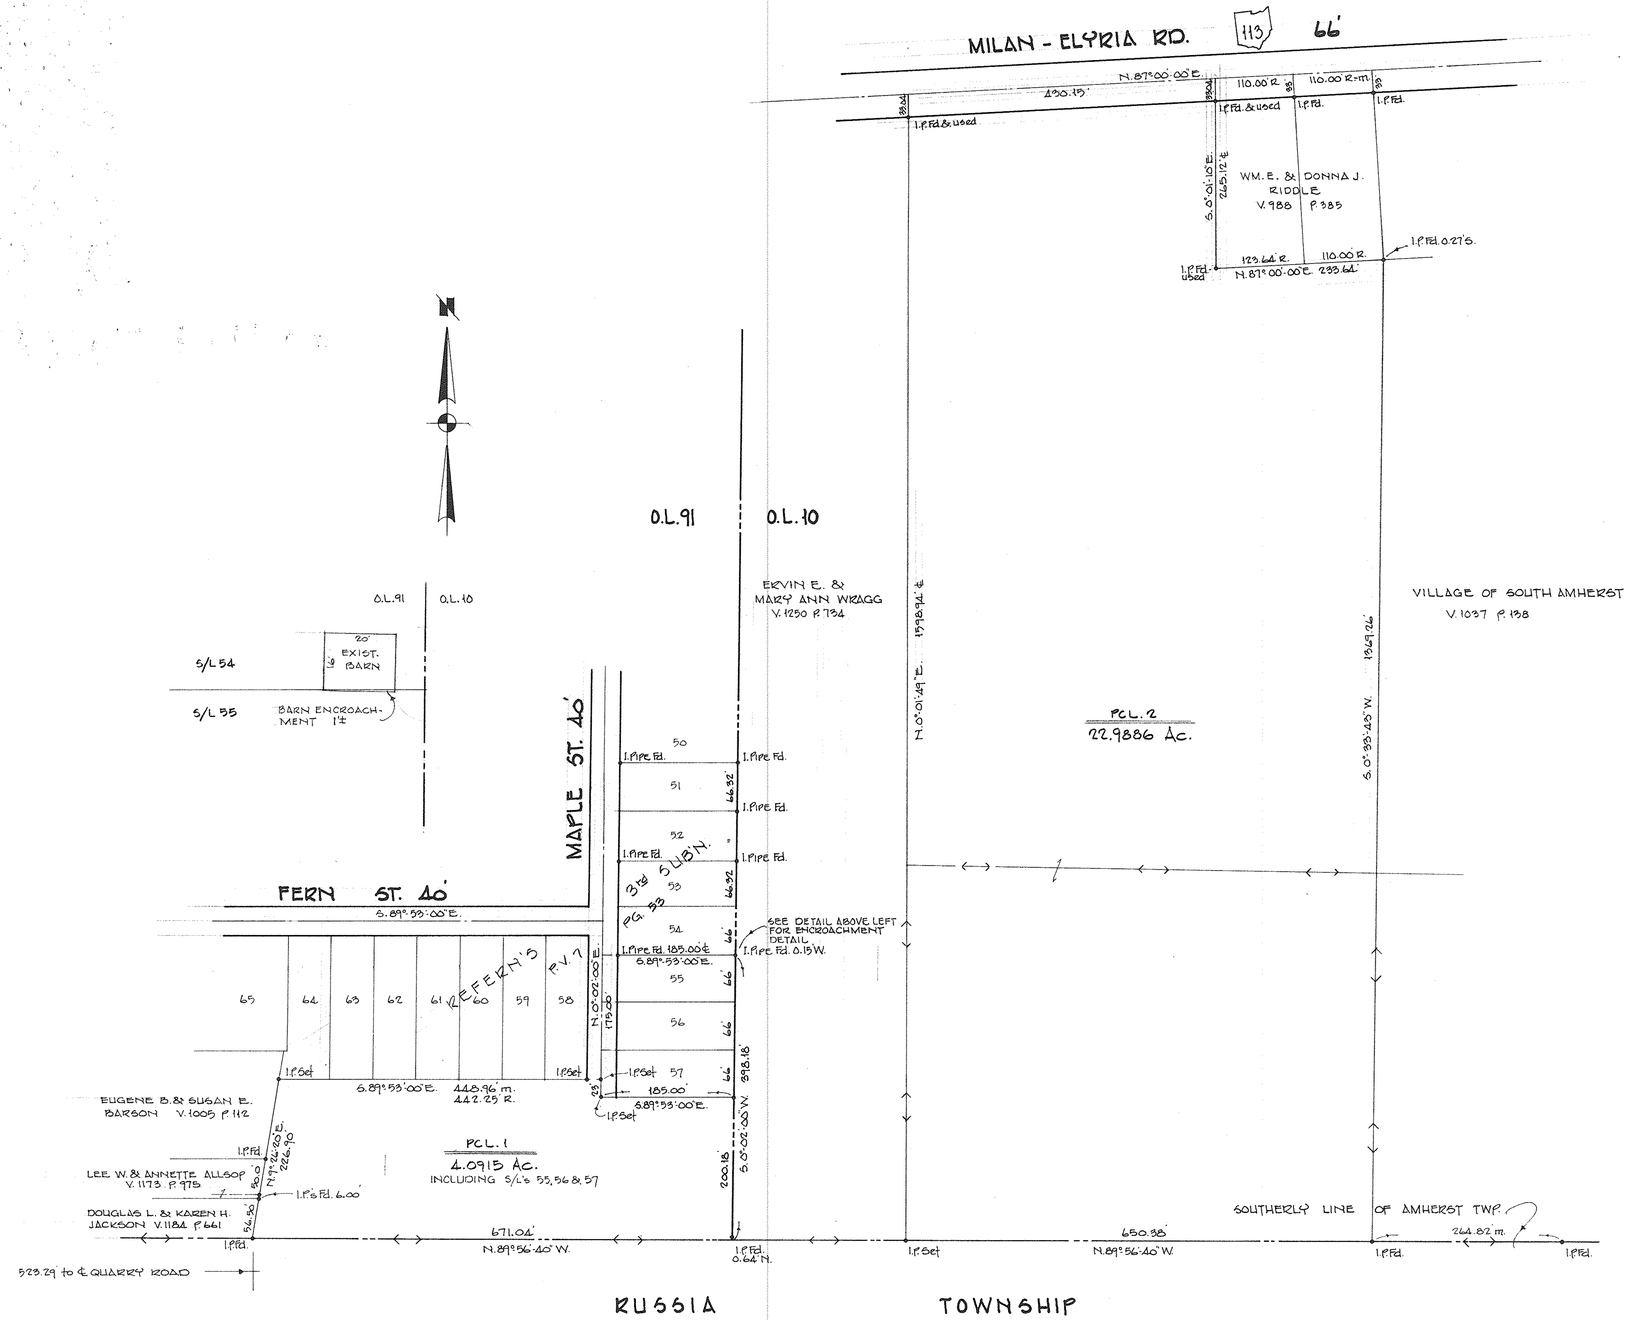

SURVEY FOR

ALEXANDER PAUKST ET AL

S/L's 55, 56 & 57 IN REFERN'S 3RD SUBDIVISION P.V. 7 P. 53

PART OF O.L.'s 10 & 91 TOWNSHIP OF AMHERST

PART OF THE VILLAGE OF S. AMHERST COUNTY OF LORAIN

STATE OF OHIO

SCALE 1"=100' MARCH, 1990

LAUNDON • SIMON • CAHL & ASSOC.
ENGINEERS SURVEYORS

JOB Nº 90-194

05-00-010-102-052
-058

05-00-010-A

247