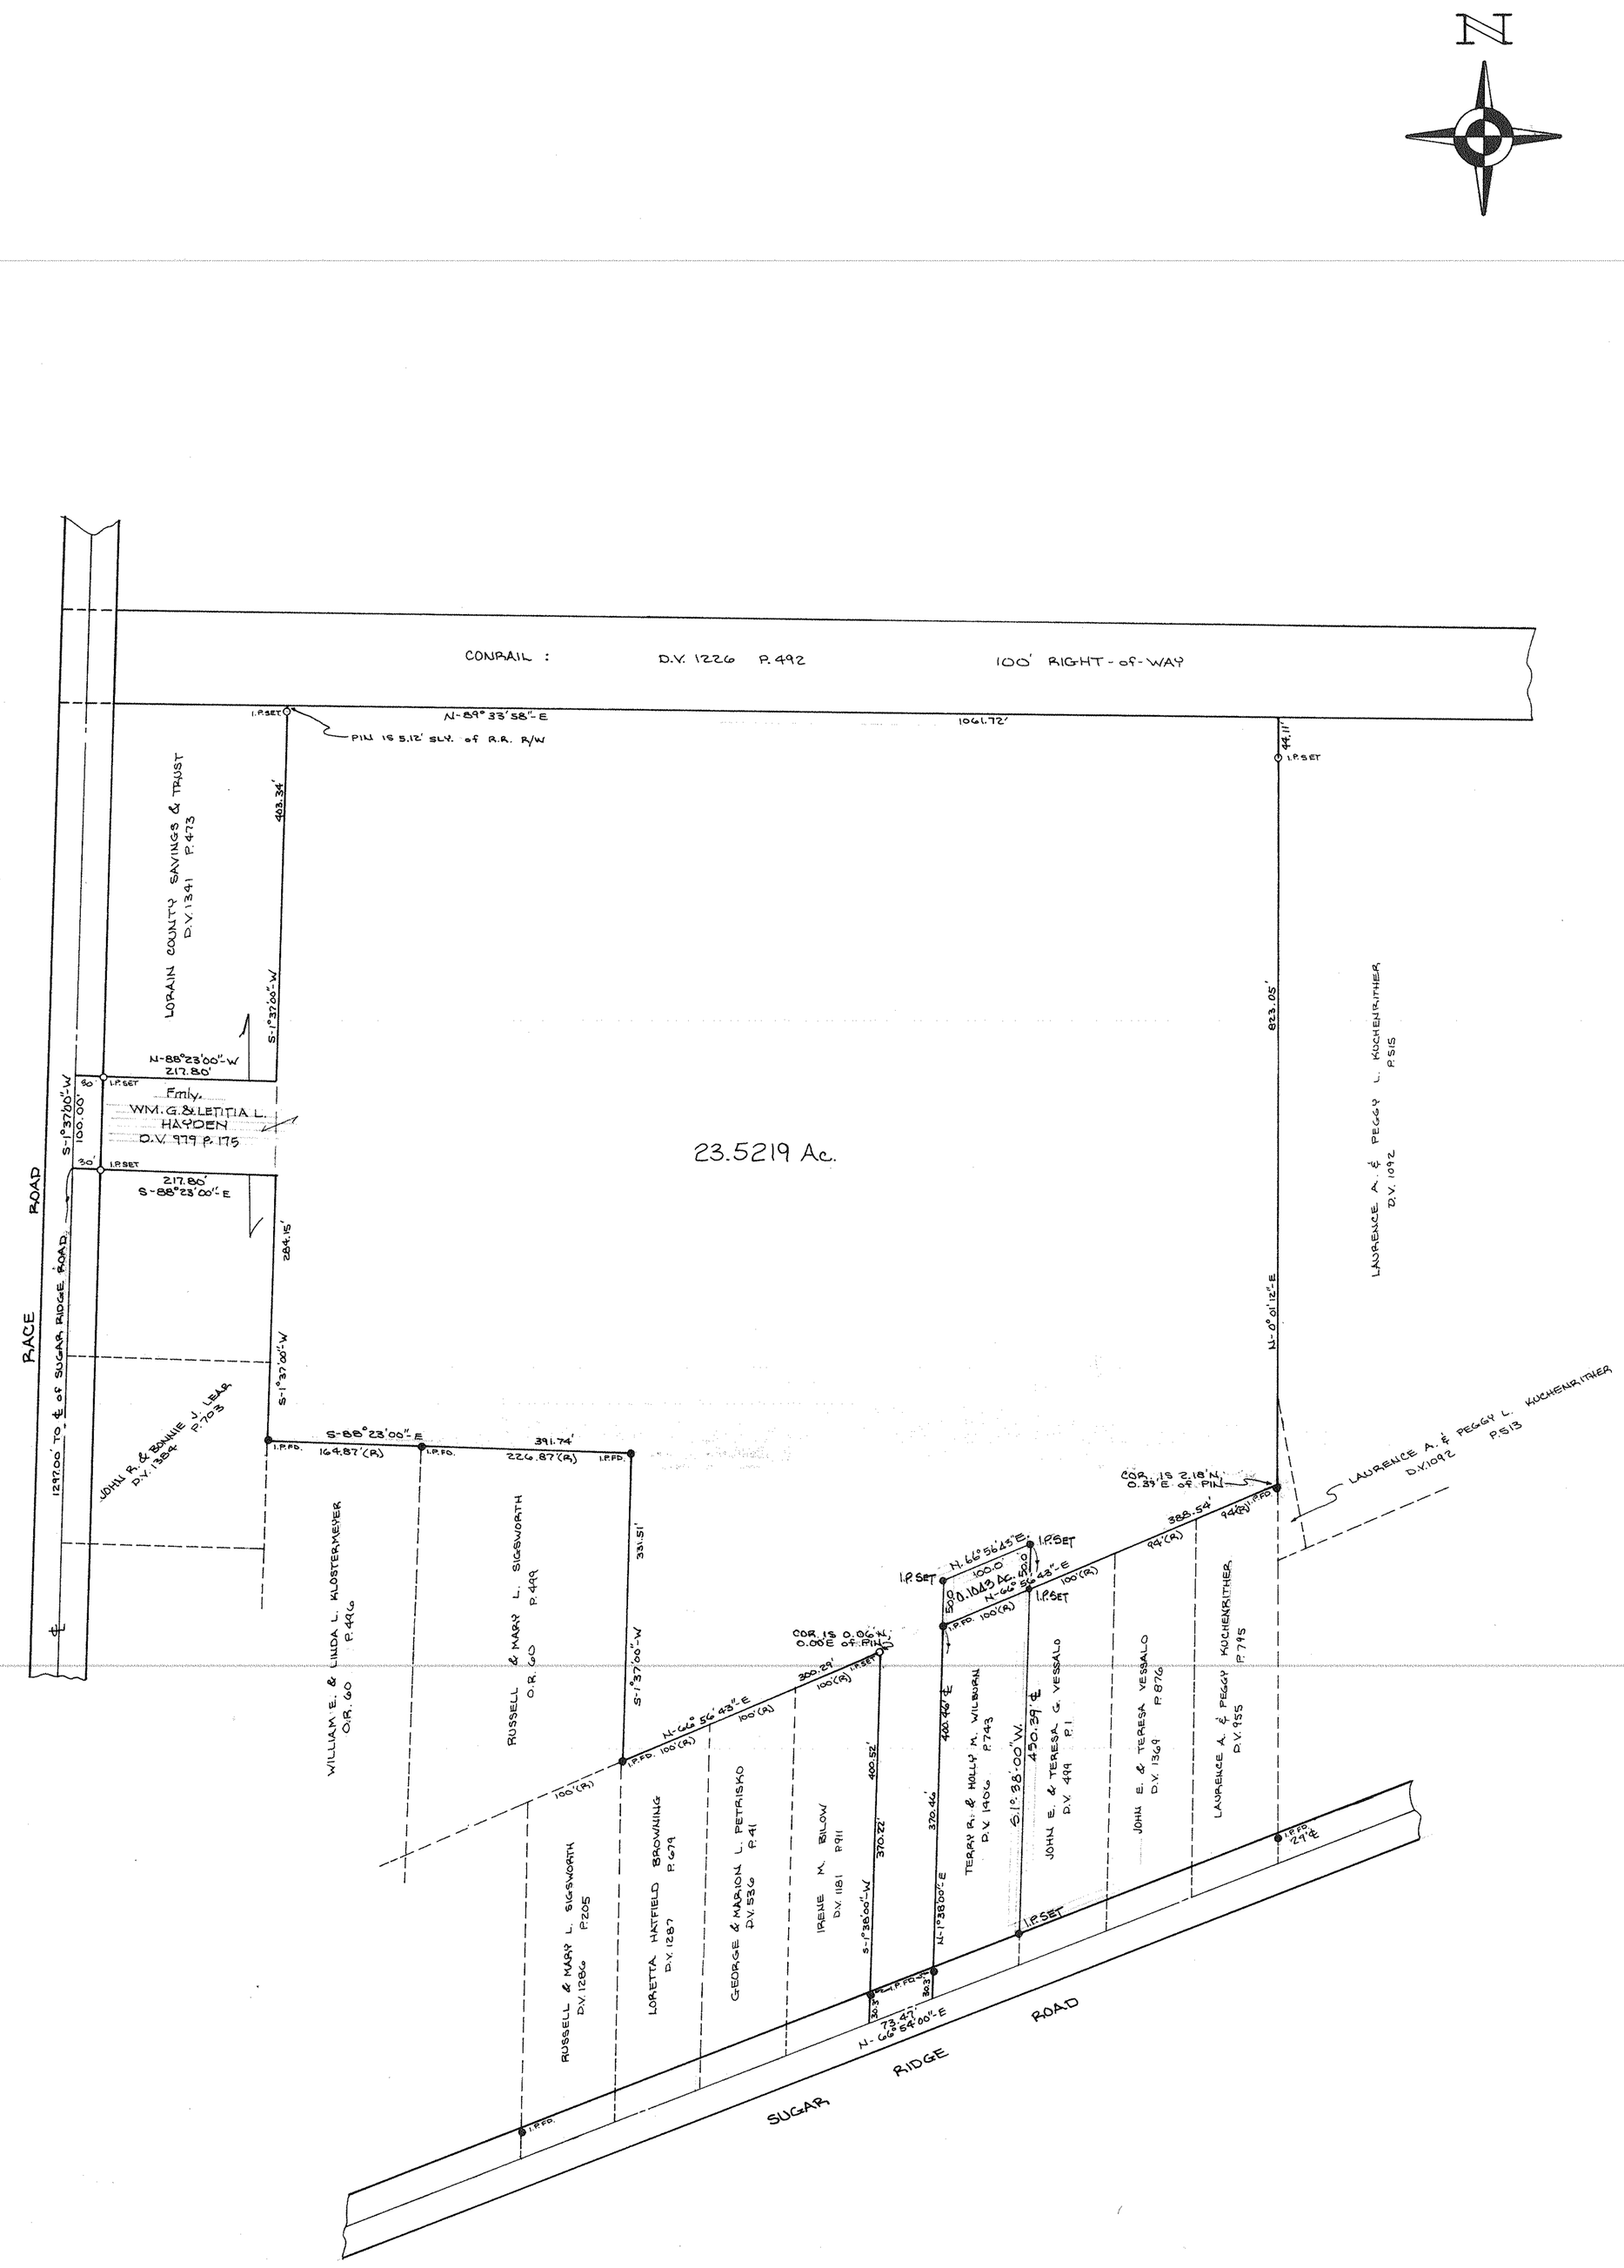

BOUNDARY SURVEY

PART of RIDGEVILLE TOWNSHIP - ORIGINAL LOT Nº 35

CITY of NORTH RIDGEVILLE COUNTY of LORAIN

STATE of OHIO

SCALE: 1" = 100' DATE: OCTOBER, 1989

REGISTERED SURVEYOR: RODGER G. SIMON #5101

PREPARED BY

LAUNDON-SIMON-CAHL & ASSOC., INC.
106 MIDDLE AVENUE
ELYRIA, OHIO 44035

PREPARED FOR

L.A. & P.L. KUCHENRITHER
37464 SUGAR RIDGE ROAD
NORTH RIDGEVILLE, OHIO 44035

REV. FOR T. & H. WILBURN SEPT. '90 Split of 0.1043 Ac. JOB Nº 90-1969

Job. Nº 89-1869

07-00-035-101-004 07-00-035-4

172