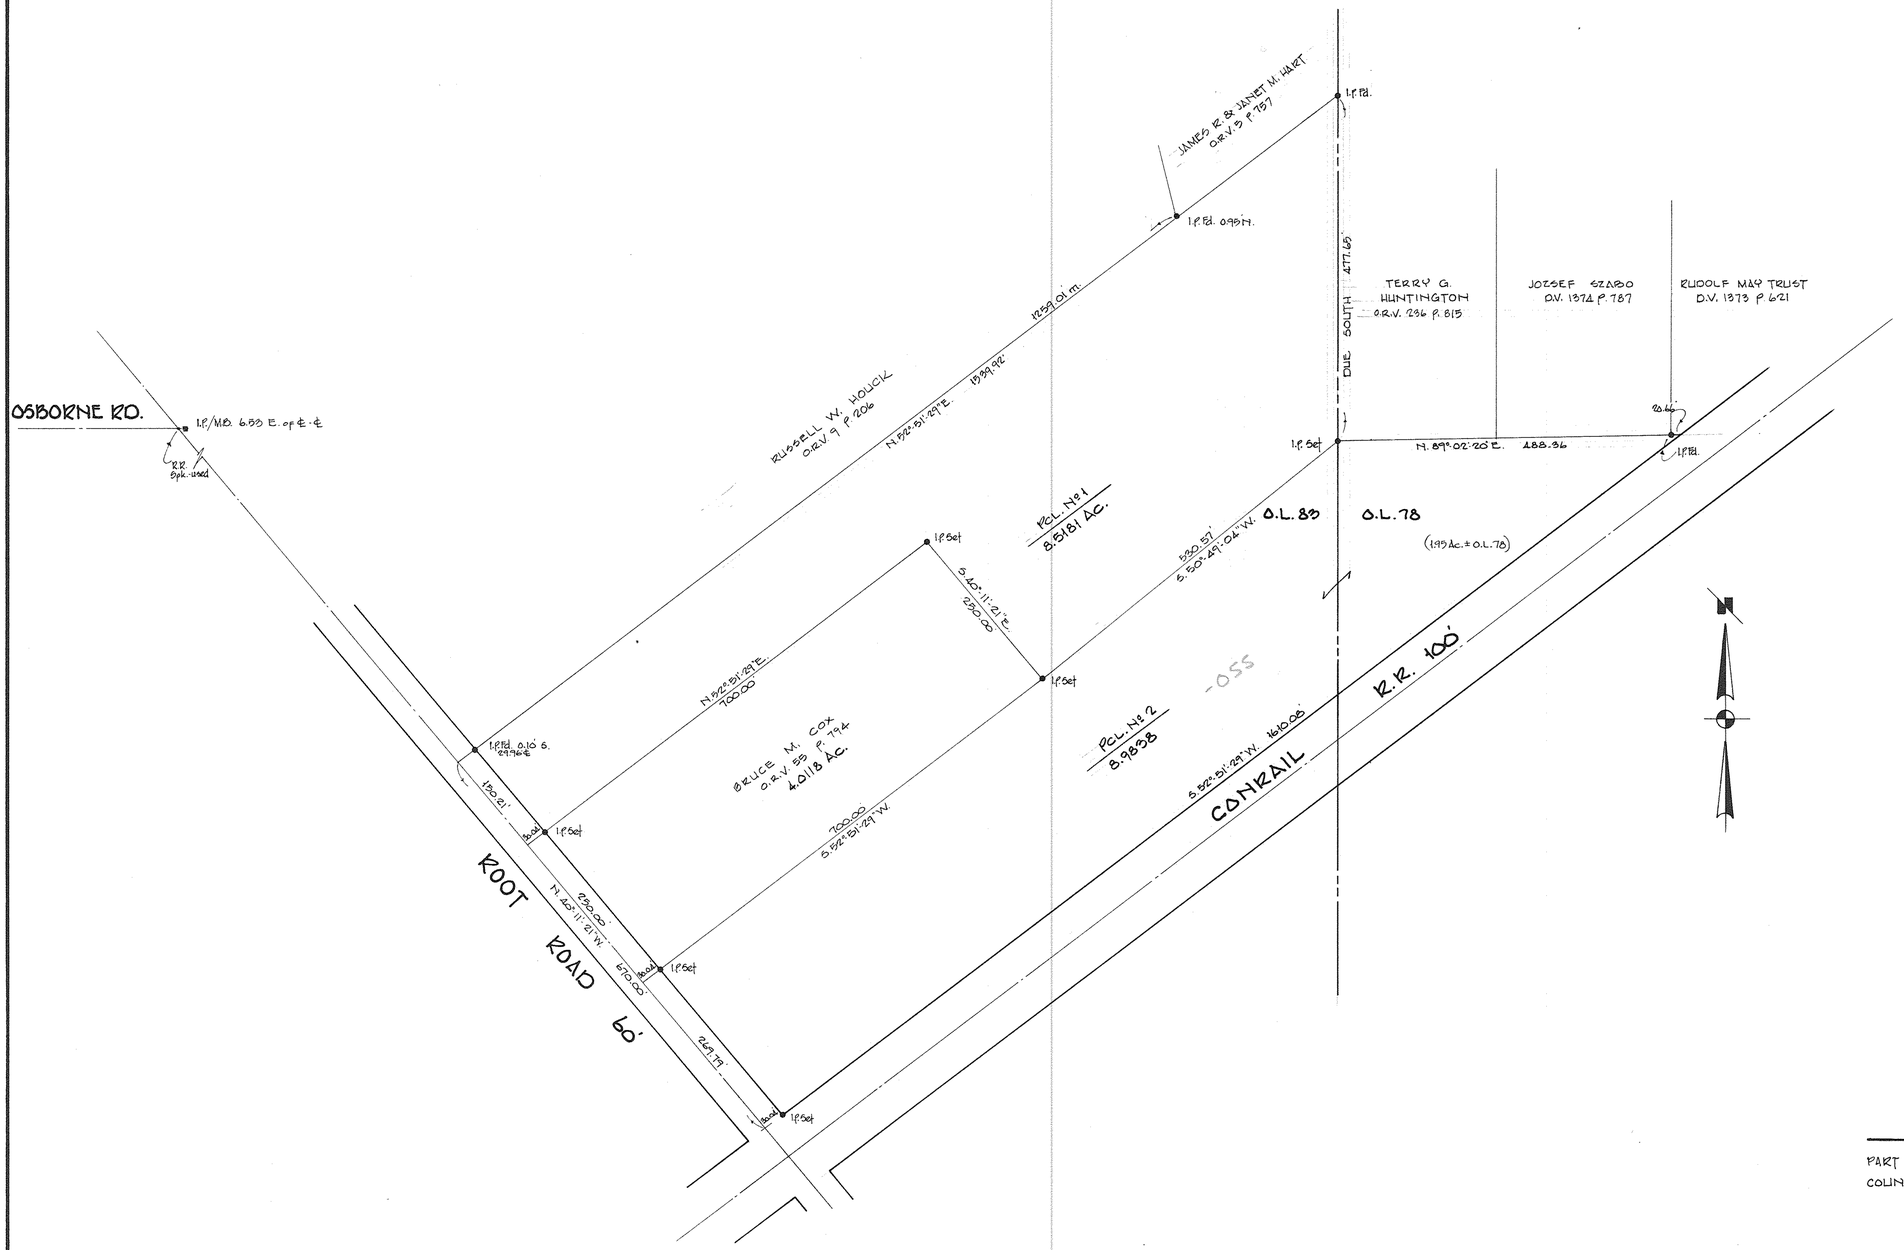


SURVEY FOR

## VINCENT A. & BETH A. GASPAR

PART OF O.L.'S 78 & 83 — COLUMBIA TOWNSHIP
COUNTY OF LORAIN — STATE OF OHIO
SCALE 1" = 100' — MAY, 1990

LAUNDON · SIMON · CAHL & ASSOC.
ENGINEERS — SURVEYORS
Job No. 90-1918

REF. F.B. 156 P. 68

12-00-083-000-055 12-A

250