06-24-021-000-
6-75

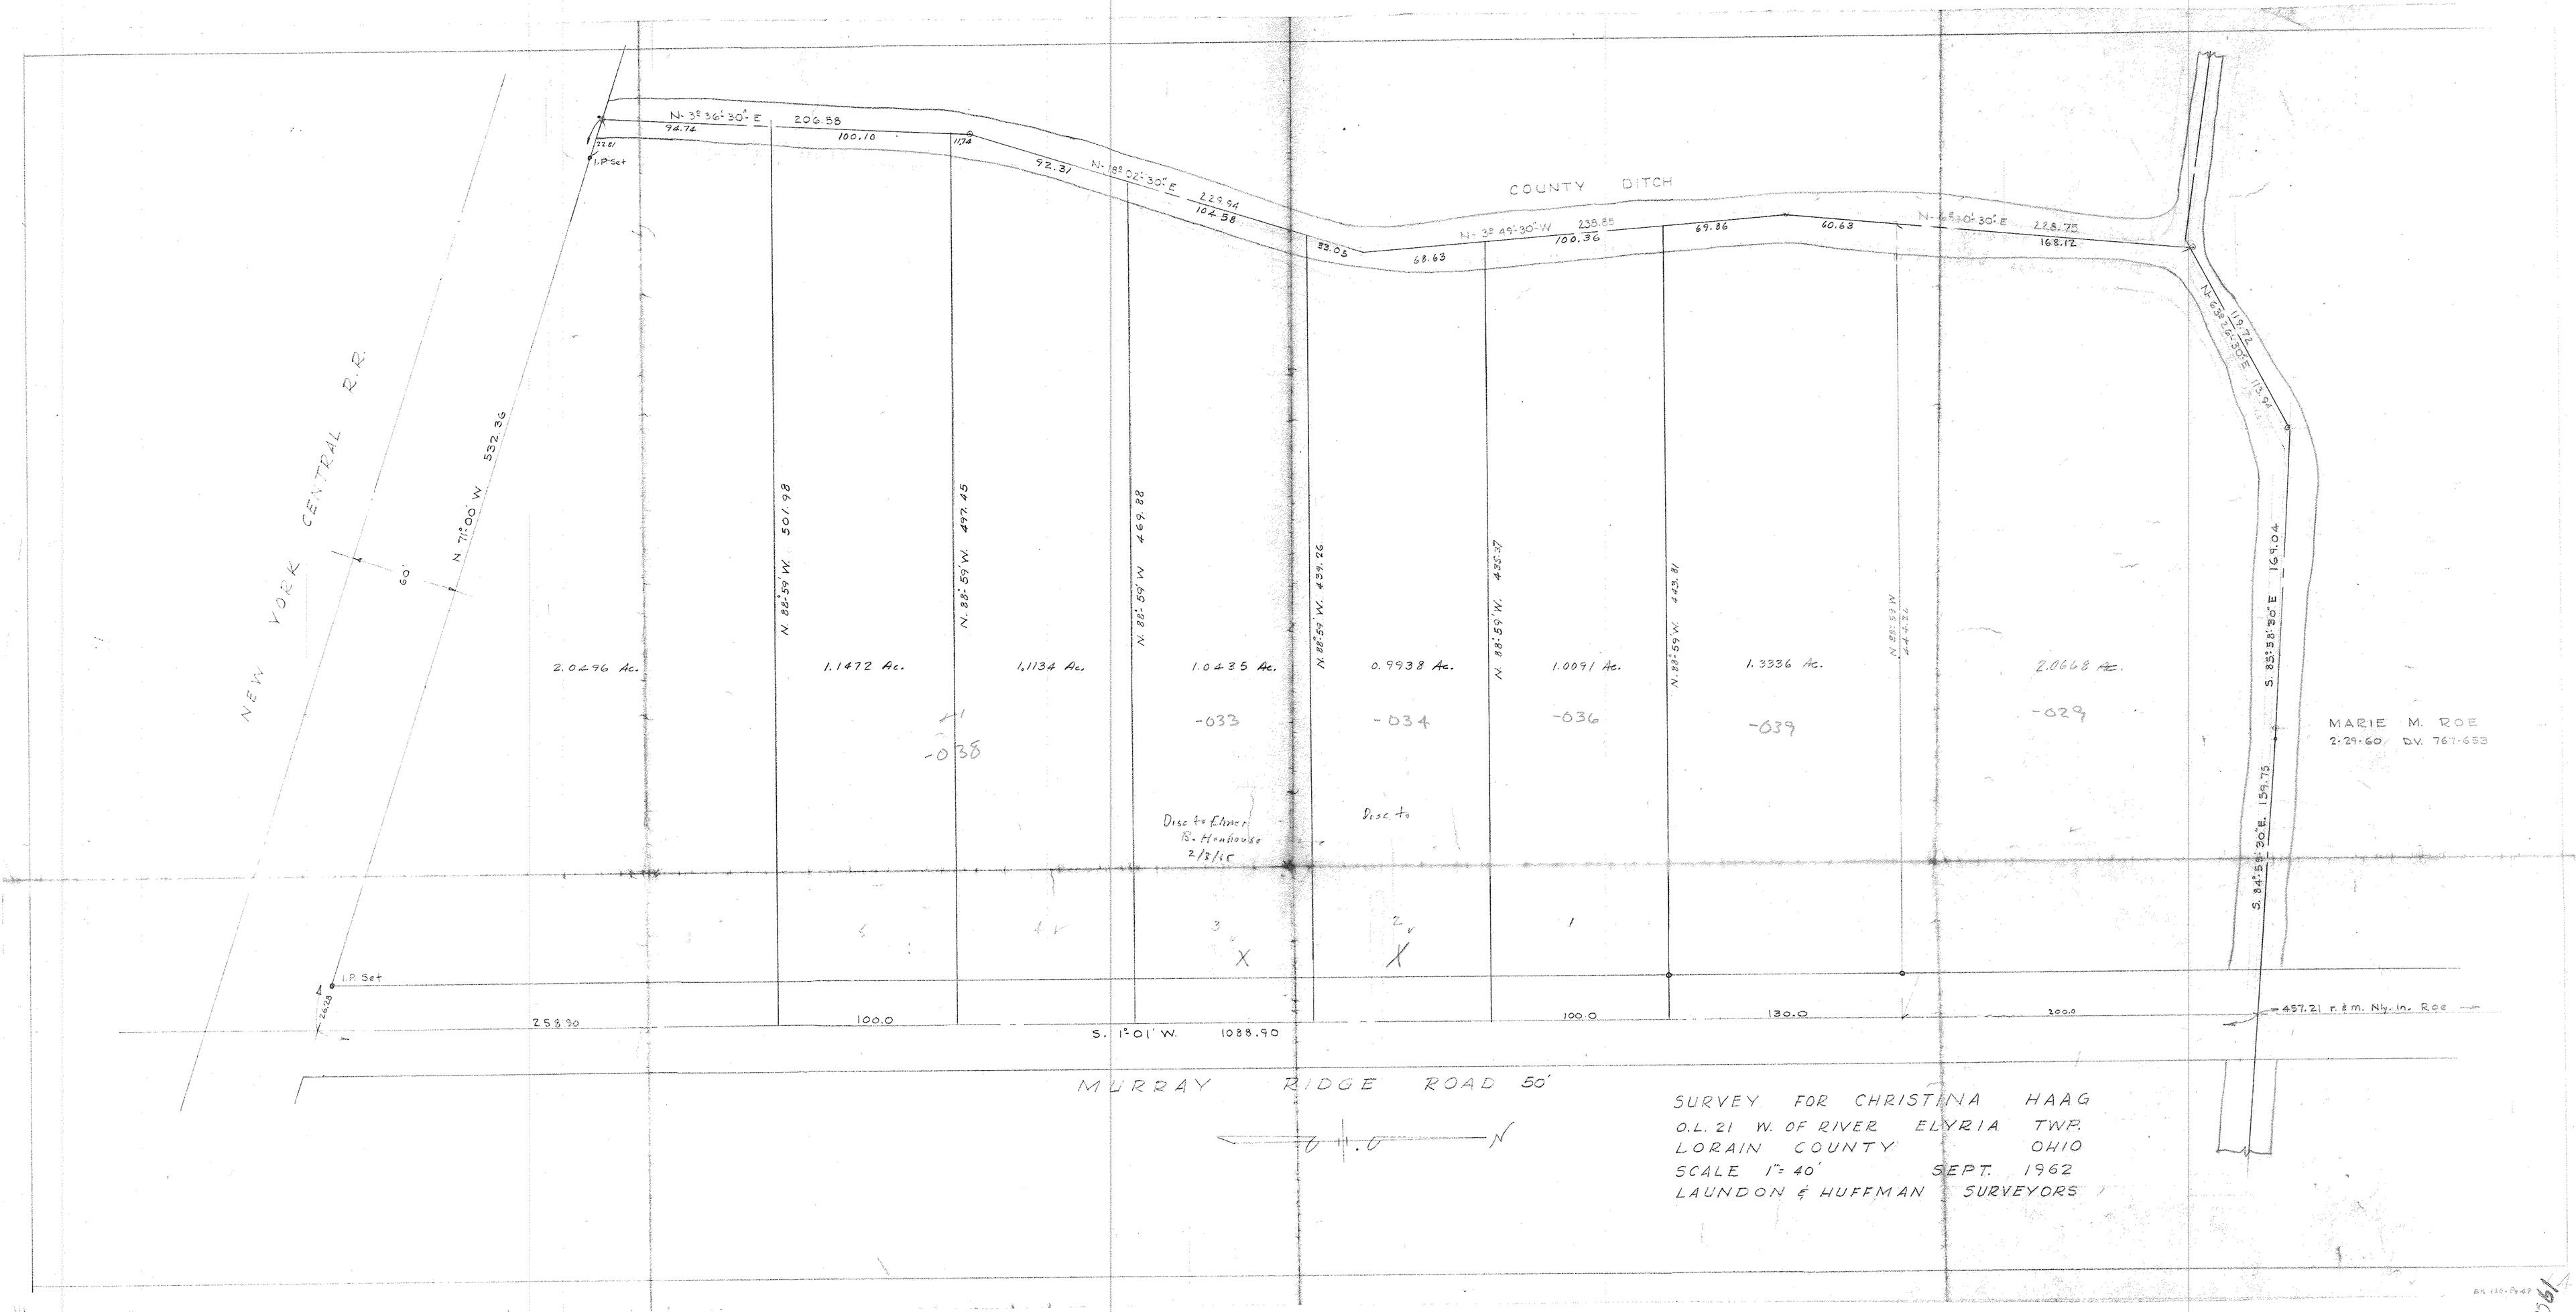

06-24-021-000-

06-75

BK 130-P.49

42361