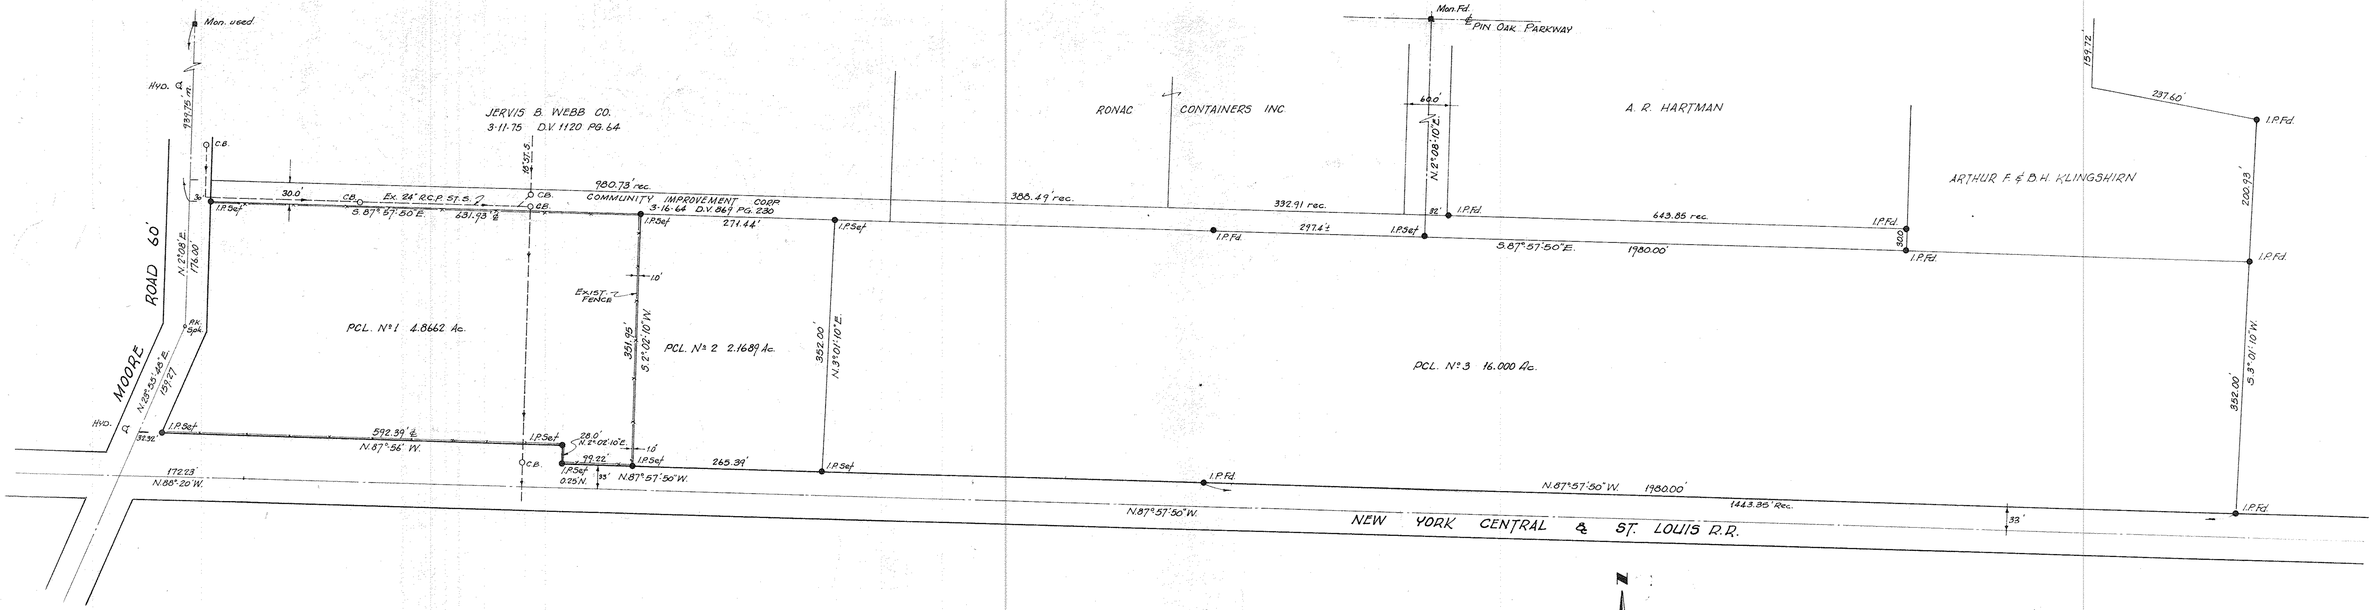

SURVEY FOR THE

WEST SIDE LUMBER AND CONCRETE CORPORATION

PART OF SECTION 8 AVON TWP. CITY OF AVON LAKE
LORAIN COUNTY, OHIO SCALE 1"=100' MAY, 1977
LAUNDON · SIMON · CAHL & ASSOC. ENGINEERS and SURVEYORS

JOB No 77-606
F.B. 65/72-73