


19-A

PECK-WADSWORTH ROAD 60'

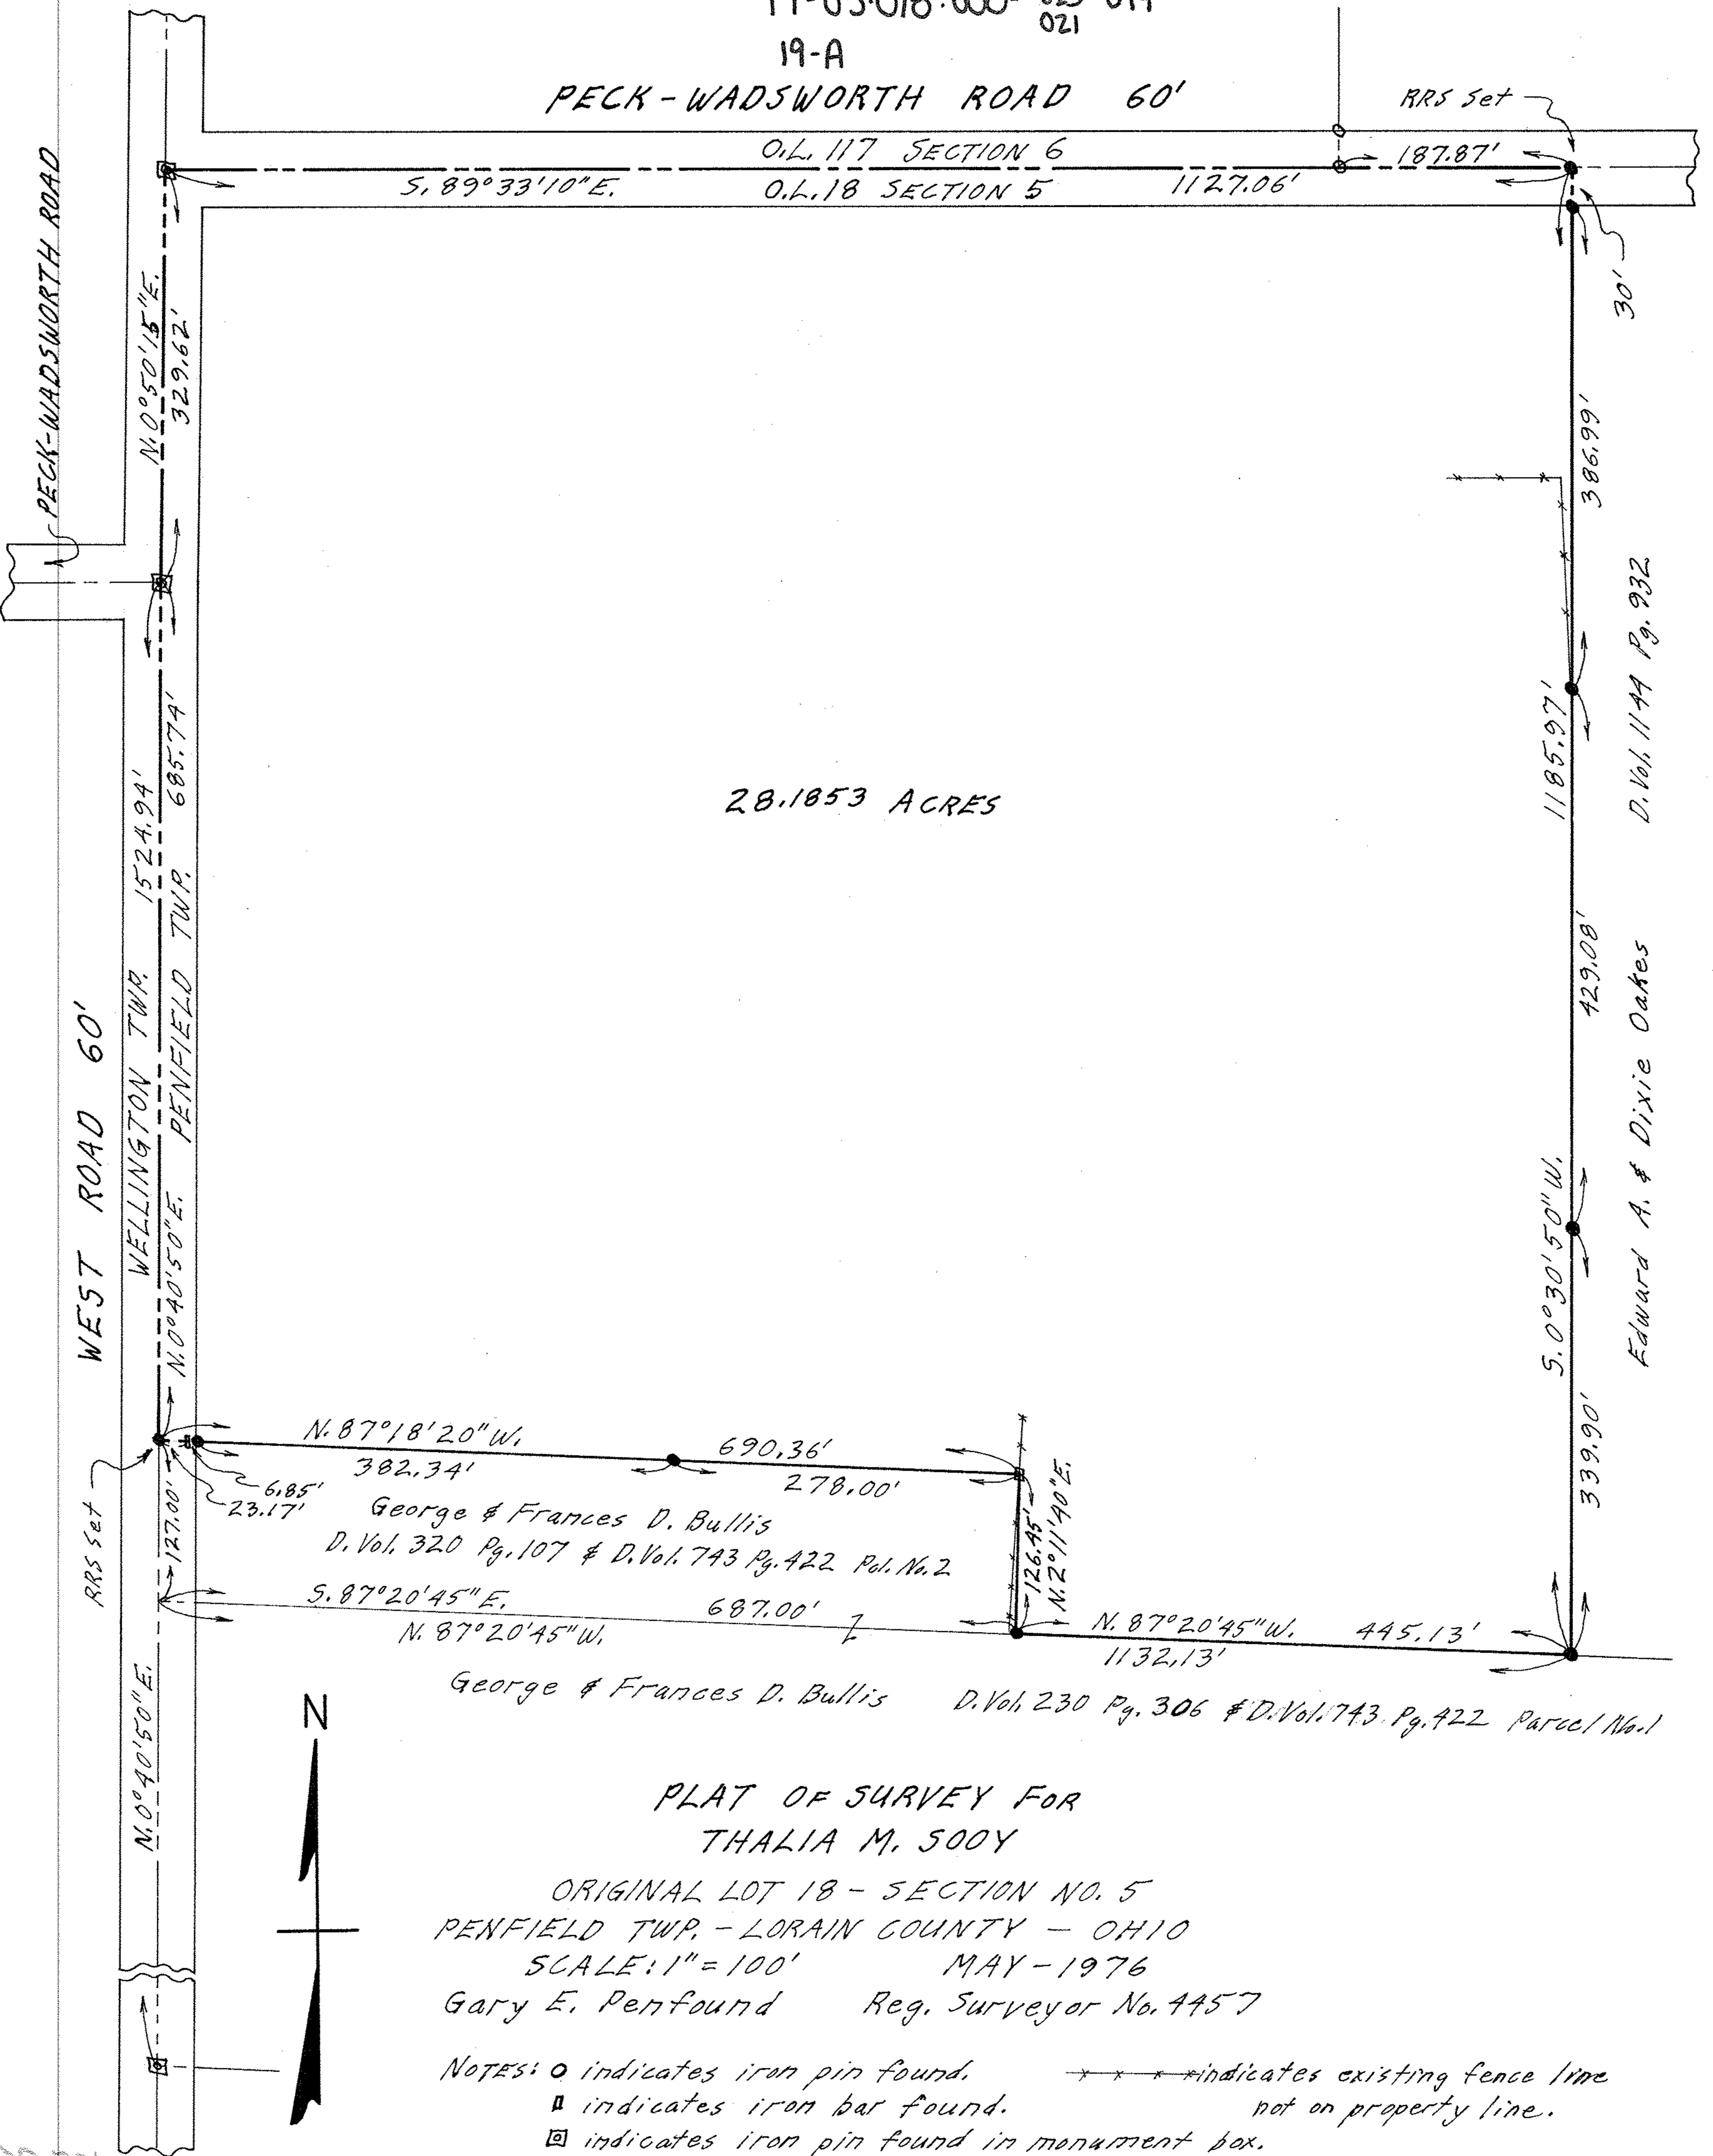

O.L. 117 SECTION 6
O.L. 18 SECTION 5 1127.06'

RRS set

187.87'

30'

386.99'

1185.97'

429.08'

5.0°30'50"W

339.90'

28.1853 ACRES

D. Vol. 1144 Pg. 932

Edward A. & Dixie Oakes

N. 87°18'20"W, 690.36'
382.34' 278.00'
George & Frances D. Bullis
D. Vol. 320 Pg. 107 & D. Vol. 743 Pg. 422 Parcel No. 2

S. 87°20'45"E, 687.00'
N. 87°20'45"W, 1132.13'
445.13'
George & Frances D. Bullis D. Vol. 230 Pg. 306 & D. Vol. 743 Pg. 422 Parcel No. 1

PLAT OF SURVEY FOR
THALIA M. SOOY

ORIGINAL LOT 18 - SECTION NO. 5
PENFIELD TWP. - LORAIN COUNTY - OHIO
SCALE: 1" = 100' MAY - 1976
Gary E. Penfound Reg. Surveyor No. 4457

- NOTES:
- indicates iron pin found.
 - indicates iron bar found.
 - ⊠ indicates iron pin found in monument box.
 - indicates iron pin set in 1976 unless otherwise designated.
 - indicates existing fence line not on property line.