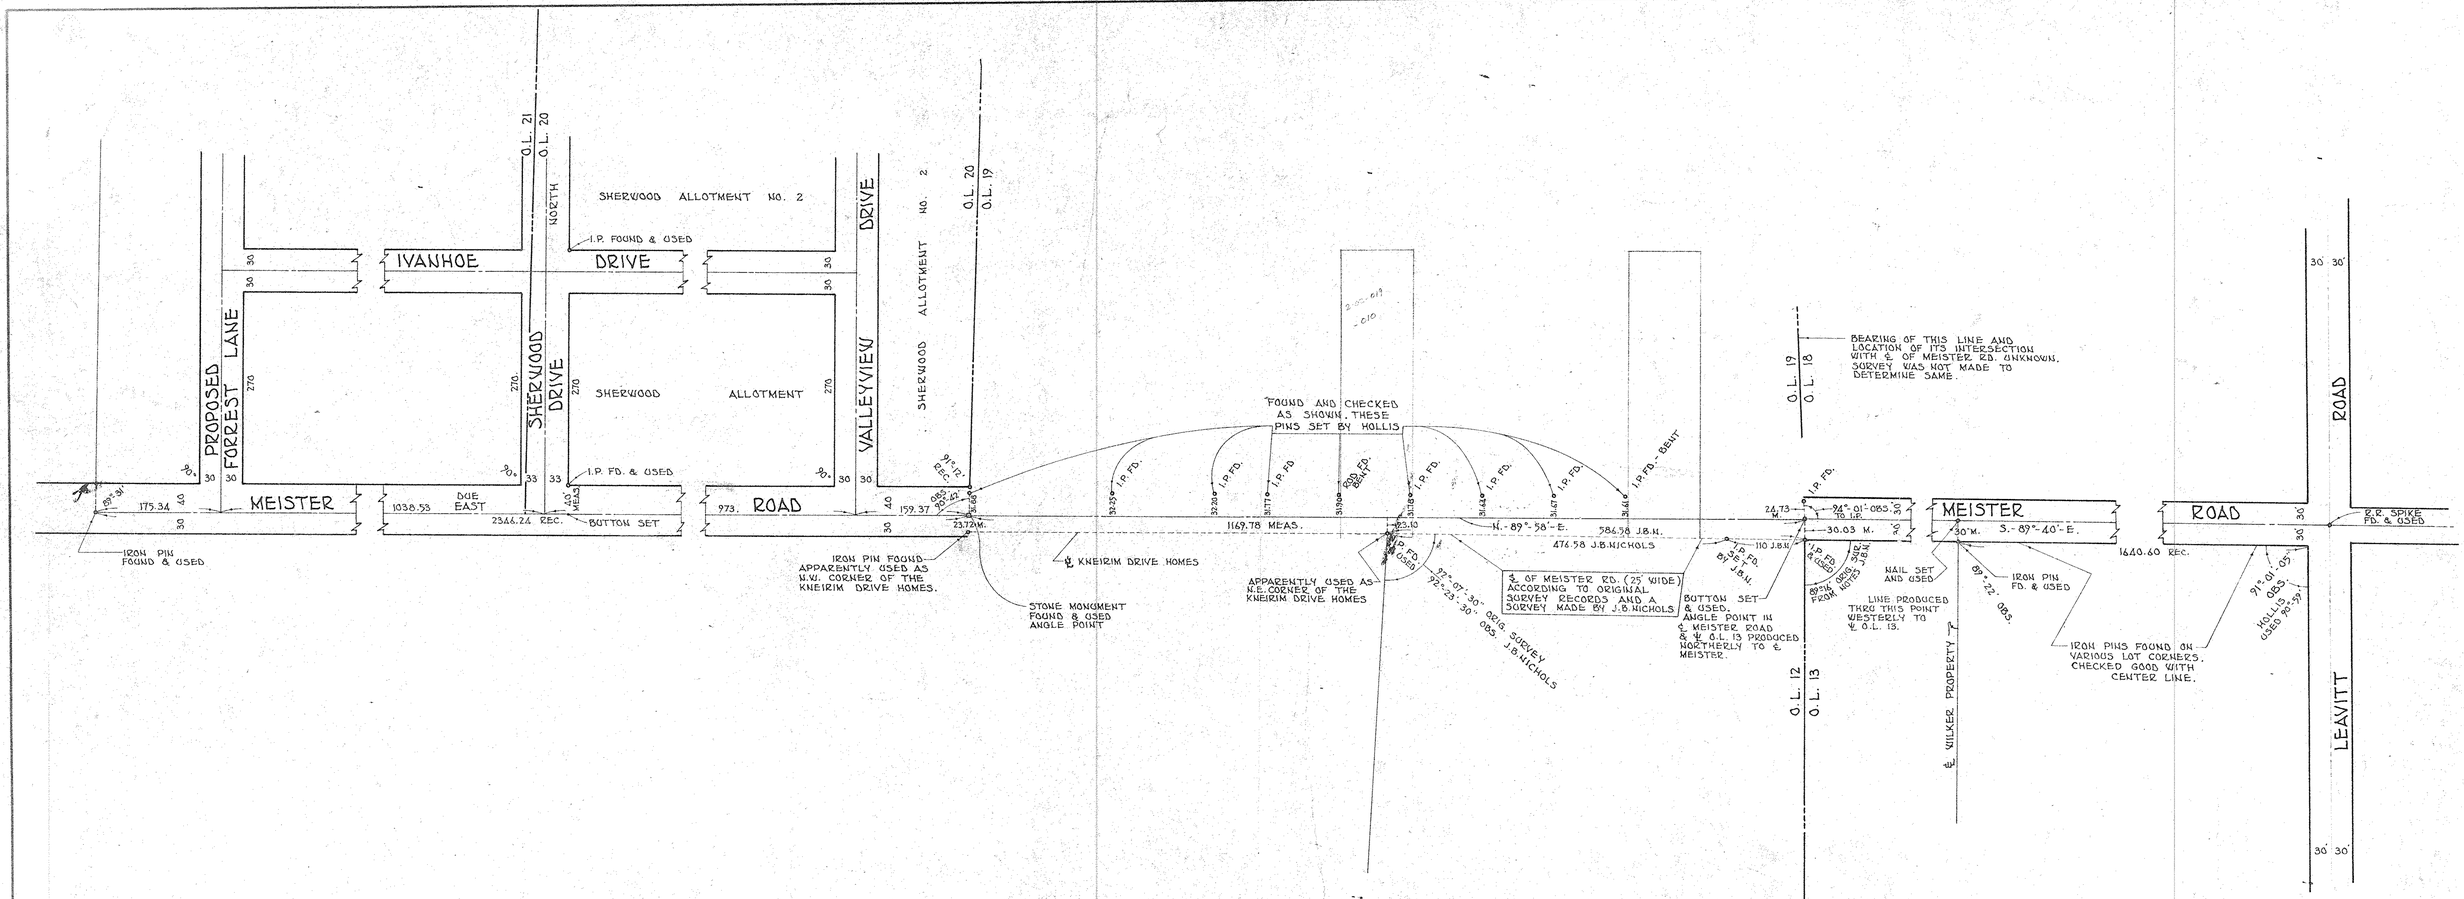

02-02-018-B
2-G
02-02-019-B
02-02-020-B
02-02-021-B

MEISTER ROAD & SURVEY

LEAVITT RD. TO VALLEYVIEW DR.

SCALE 1" = 100'

G-62