



POST

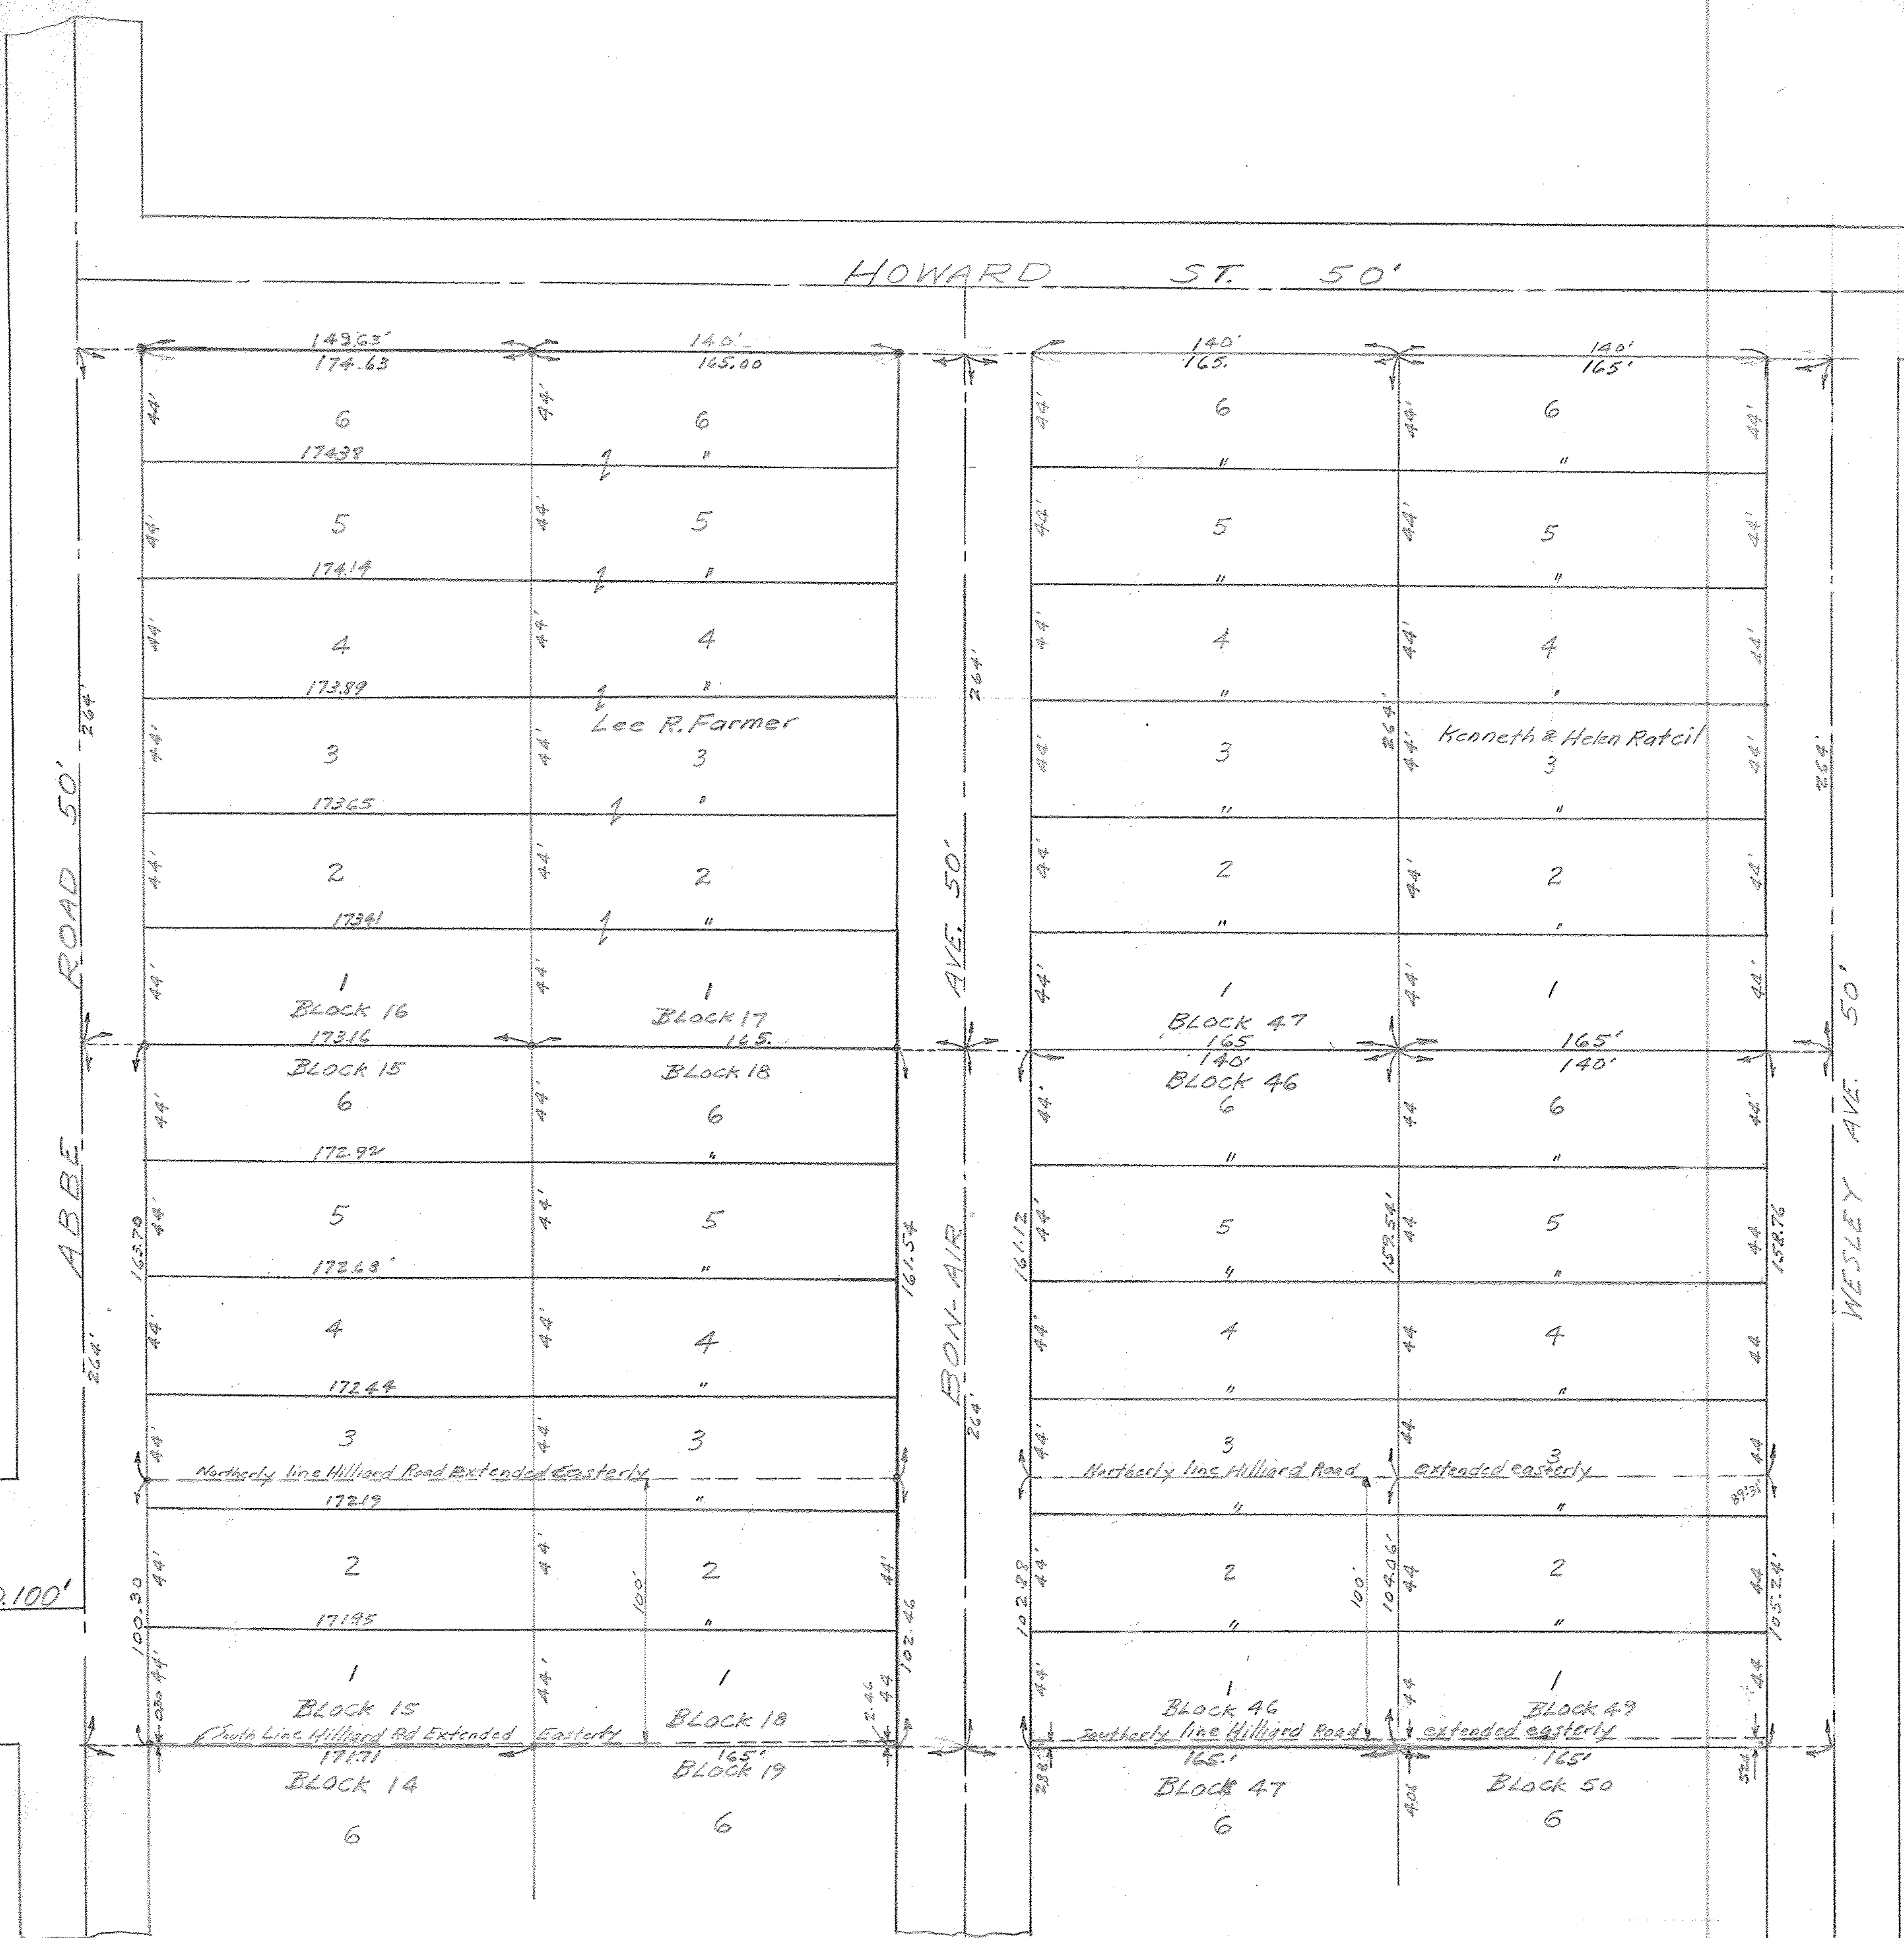

06-25-026-102-014  
 015  
 055  
 062  
 008 thd - 012  
 -018 thd - 021  
 065  
 063

PROPERTY PLAT FOR  
 MANUEL J. and NELLIE DODSLEY.  
 SUB-LOTS 1-2-3-4-5-6 BLOCK NO. 15  
 SUB-LOTS 1-2-3-4-5-6 BLOCK NO. 16  
 SUB-LOTS 1-2-3-4-5-6 BLOCK NO. 18  
 SUB-LOTS 1-2-3-4-5-6 BLOCK NO. 46  
 SUB-LOTS 1-2-3-4-5-6 BLOCK NO. 47  
 SUB-LOTS 1-2-3-4-5-6 BLOCK NO. 49  
 CITY FARMS ALLOTMENT VOLUME 9P6.3  
 O.L. 22-23-24 ELYRIA TOWNSHIP-EAST OF RIVER  
 SCALE 1" = 50' MAY-4-1954  
 C.E. Penfound Registered Surveyor.

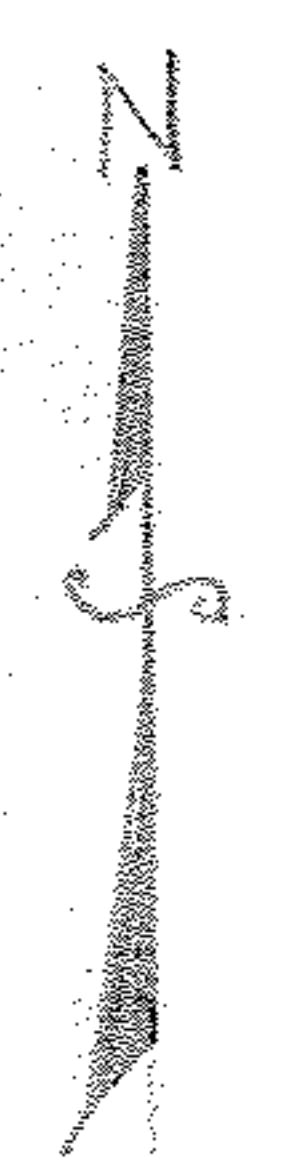