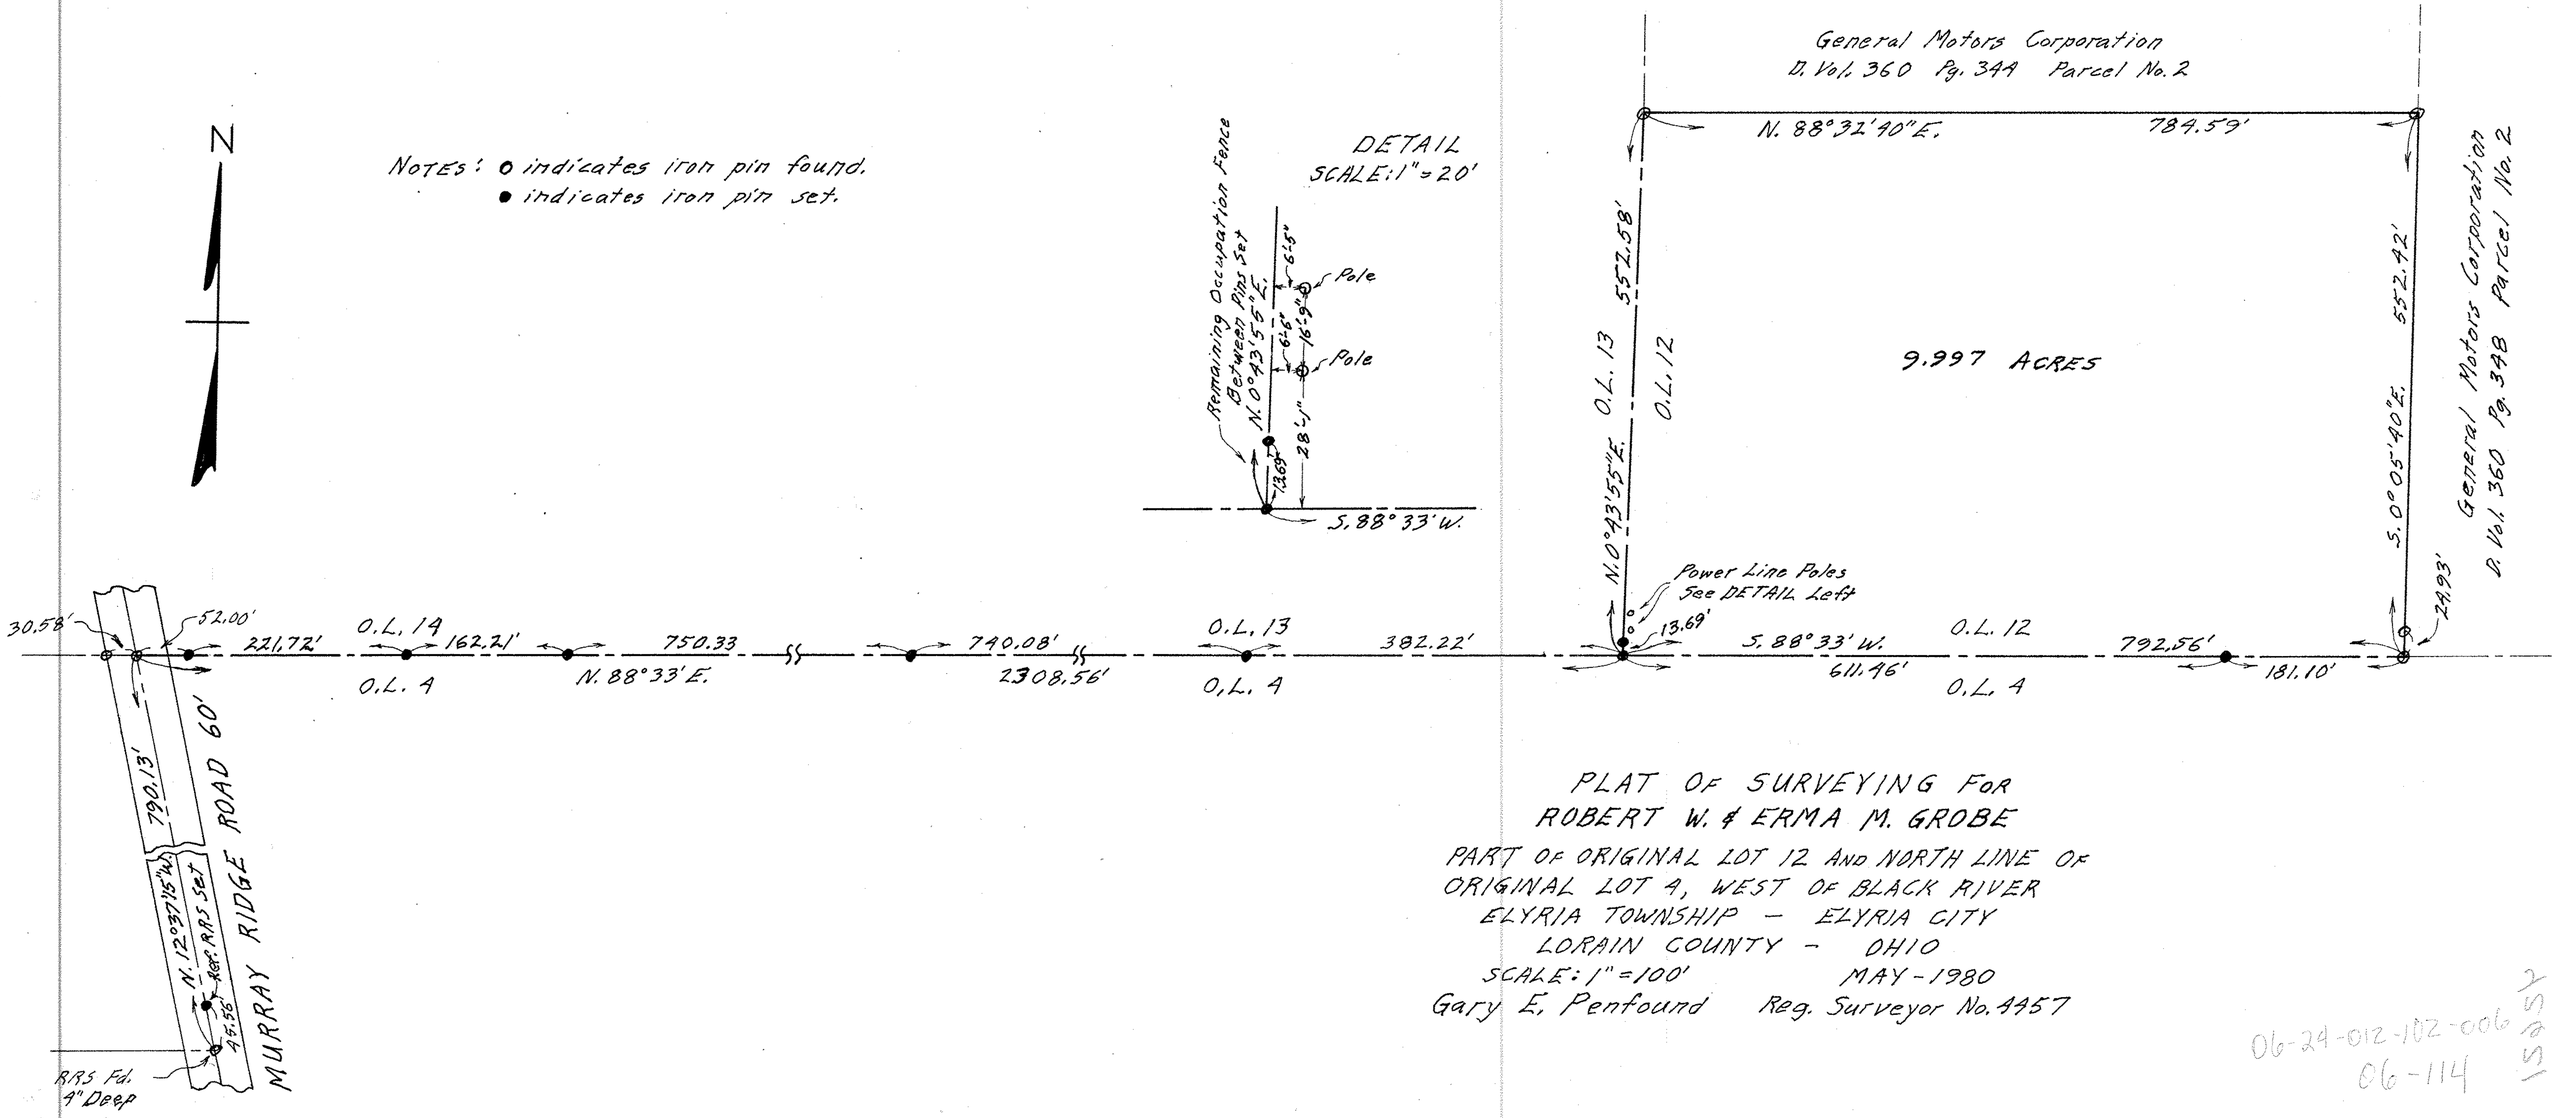

PLAT OF SURVEYING FOR
ROBERT W. & ERMA M. GROBE

PART OF ORIGINAL LOT 12 AND NORTH LINE OF
ORIGINAL LOT 4, WEST OF BLACK RIVER
ELYRIA TOWNSHIP — ELYRIA CITY
LORAIN COUNTY — OHIO
SCALE: 1" = 100' MAY - 1980
Gary E. Penfound Reg. Surveyor No. 4457

06-24-012-102-006
06-114

06-24-004