S-C-109

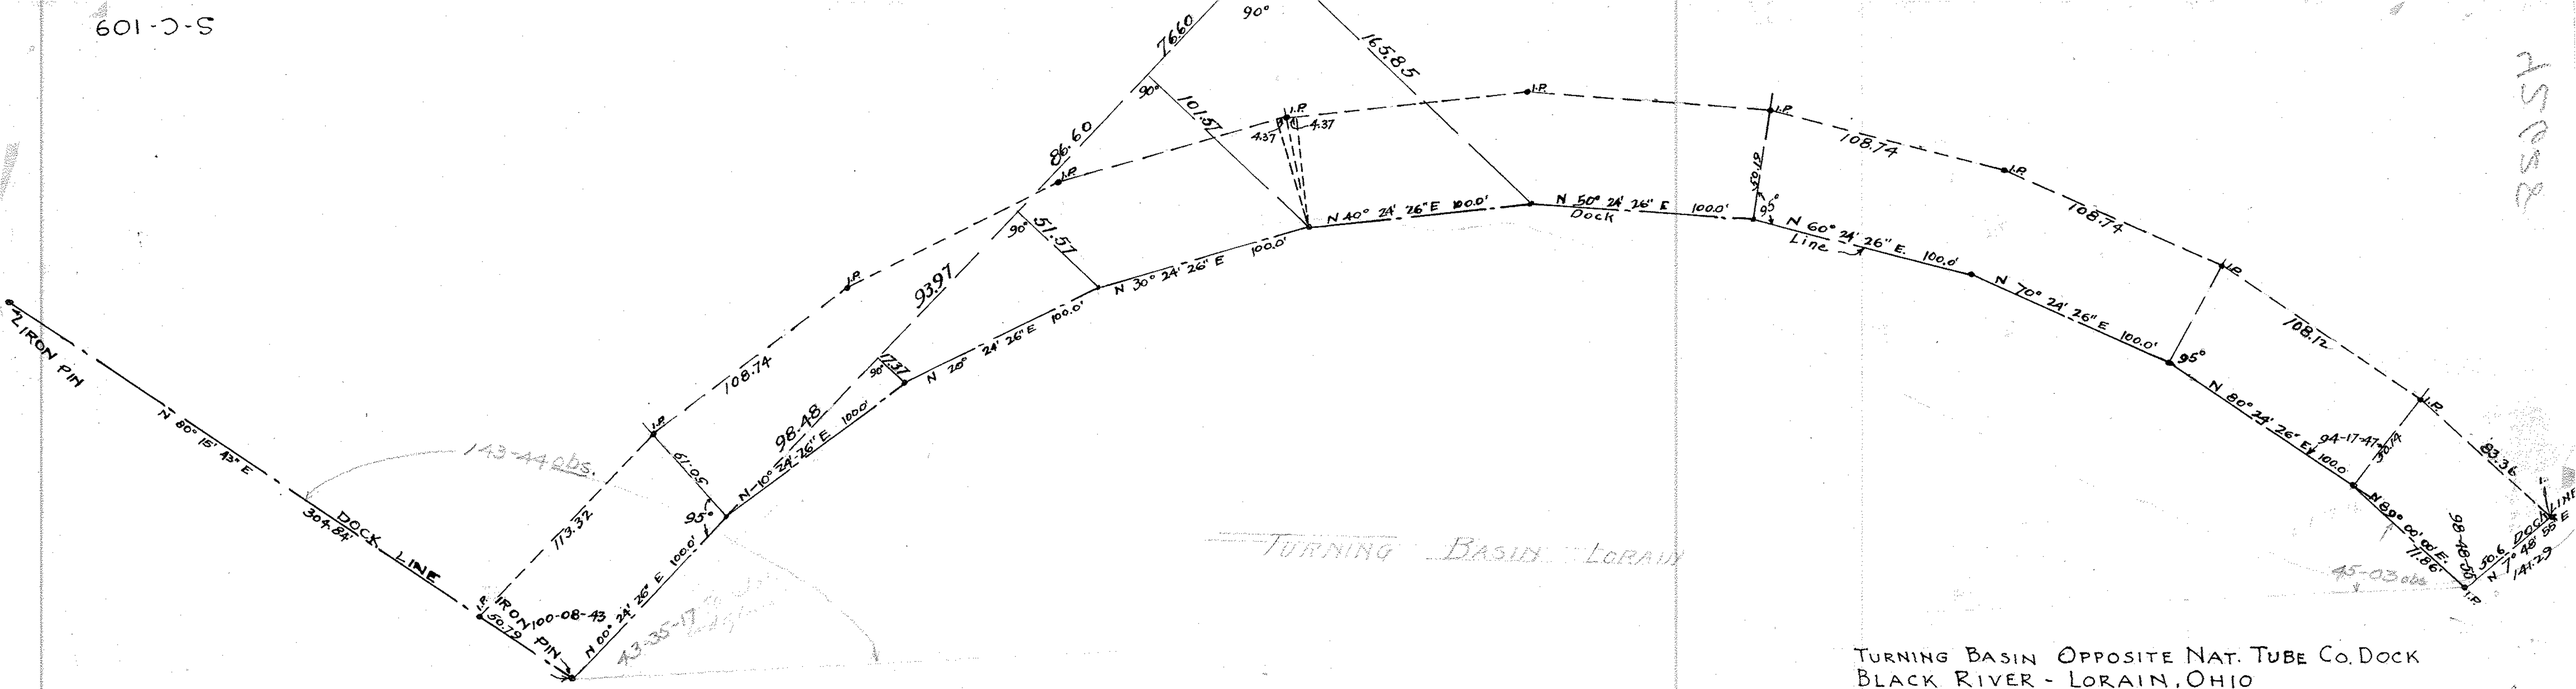

TURNING BASIN OPPOSITE NAT. TUBE CO. DOCK
BLACK RIVER - LORAIN, OHIO
SCALE 1"=50'

03-A

03-00-054-102-008

S-C-109