02-01-003-127-004, 002
02-01-003-E

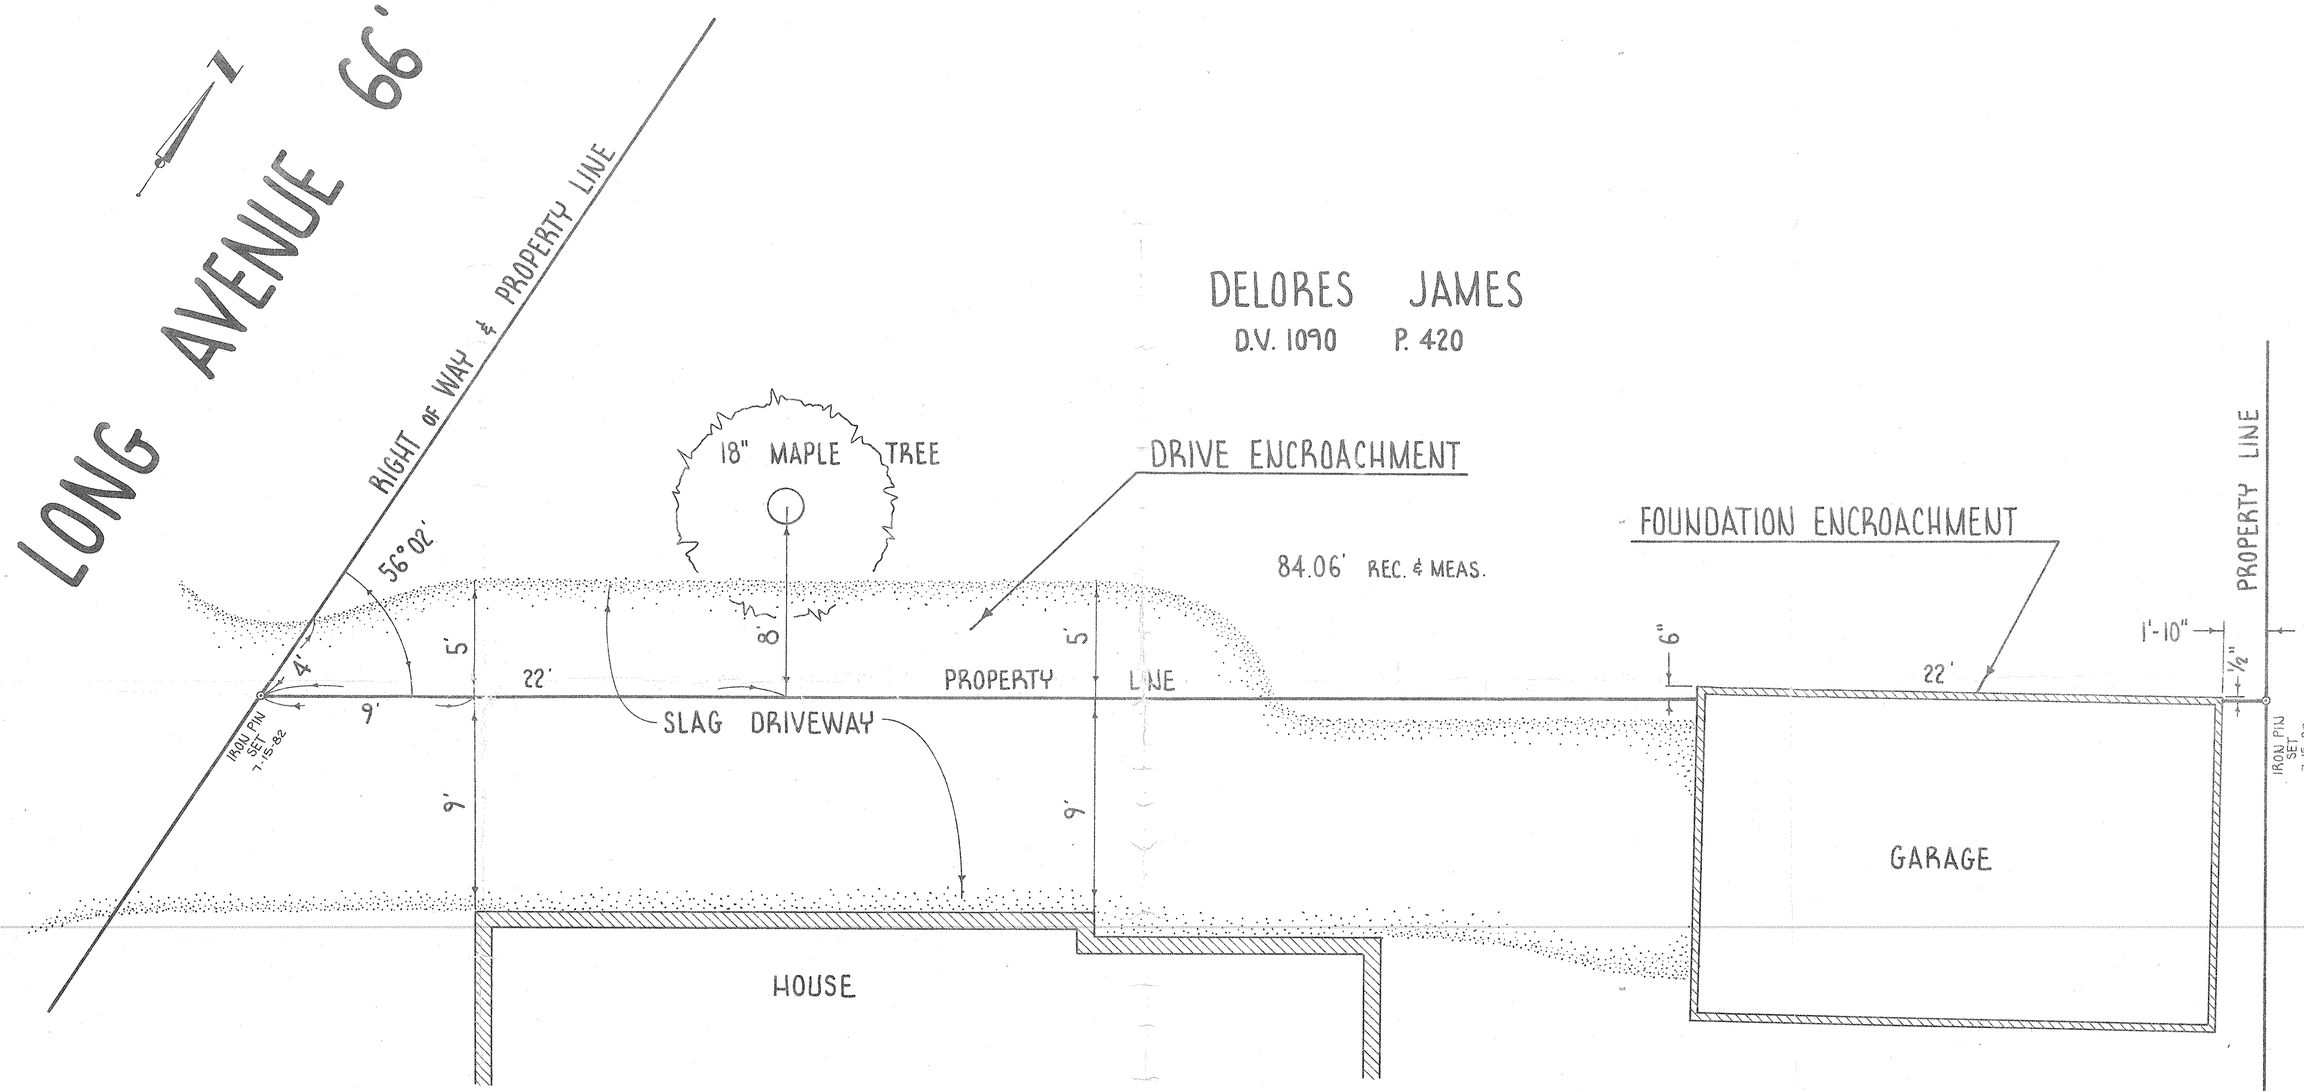

RAYMOND C. DUTRO
D.V. 1229 P. 379

SCALE: 1" = 3'

GRAPHIC SCALE IN FEET:
0 1 2 3 4 5 10

SURVEY OF DUTRO-JAMES PROPERTY LINE

PART OF SUBLOTS 7 & 9 IN BLOCK 19 IN THE PLAT OF THE SELAH CHAMBERLAIN ALLOT. - REC. P.V. 2 P. 11

CITY OF LORAIN COUNTY OF LORAIN STATE OF OHIO

PREPARED BY
KLEINOEDER - SCHMIDT & ASSOC.
CONSULTING ENGINEERS & SURVEYORS

82-71