18-00-027-B

18-00-027-106-089 034
078 031
077 030
029

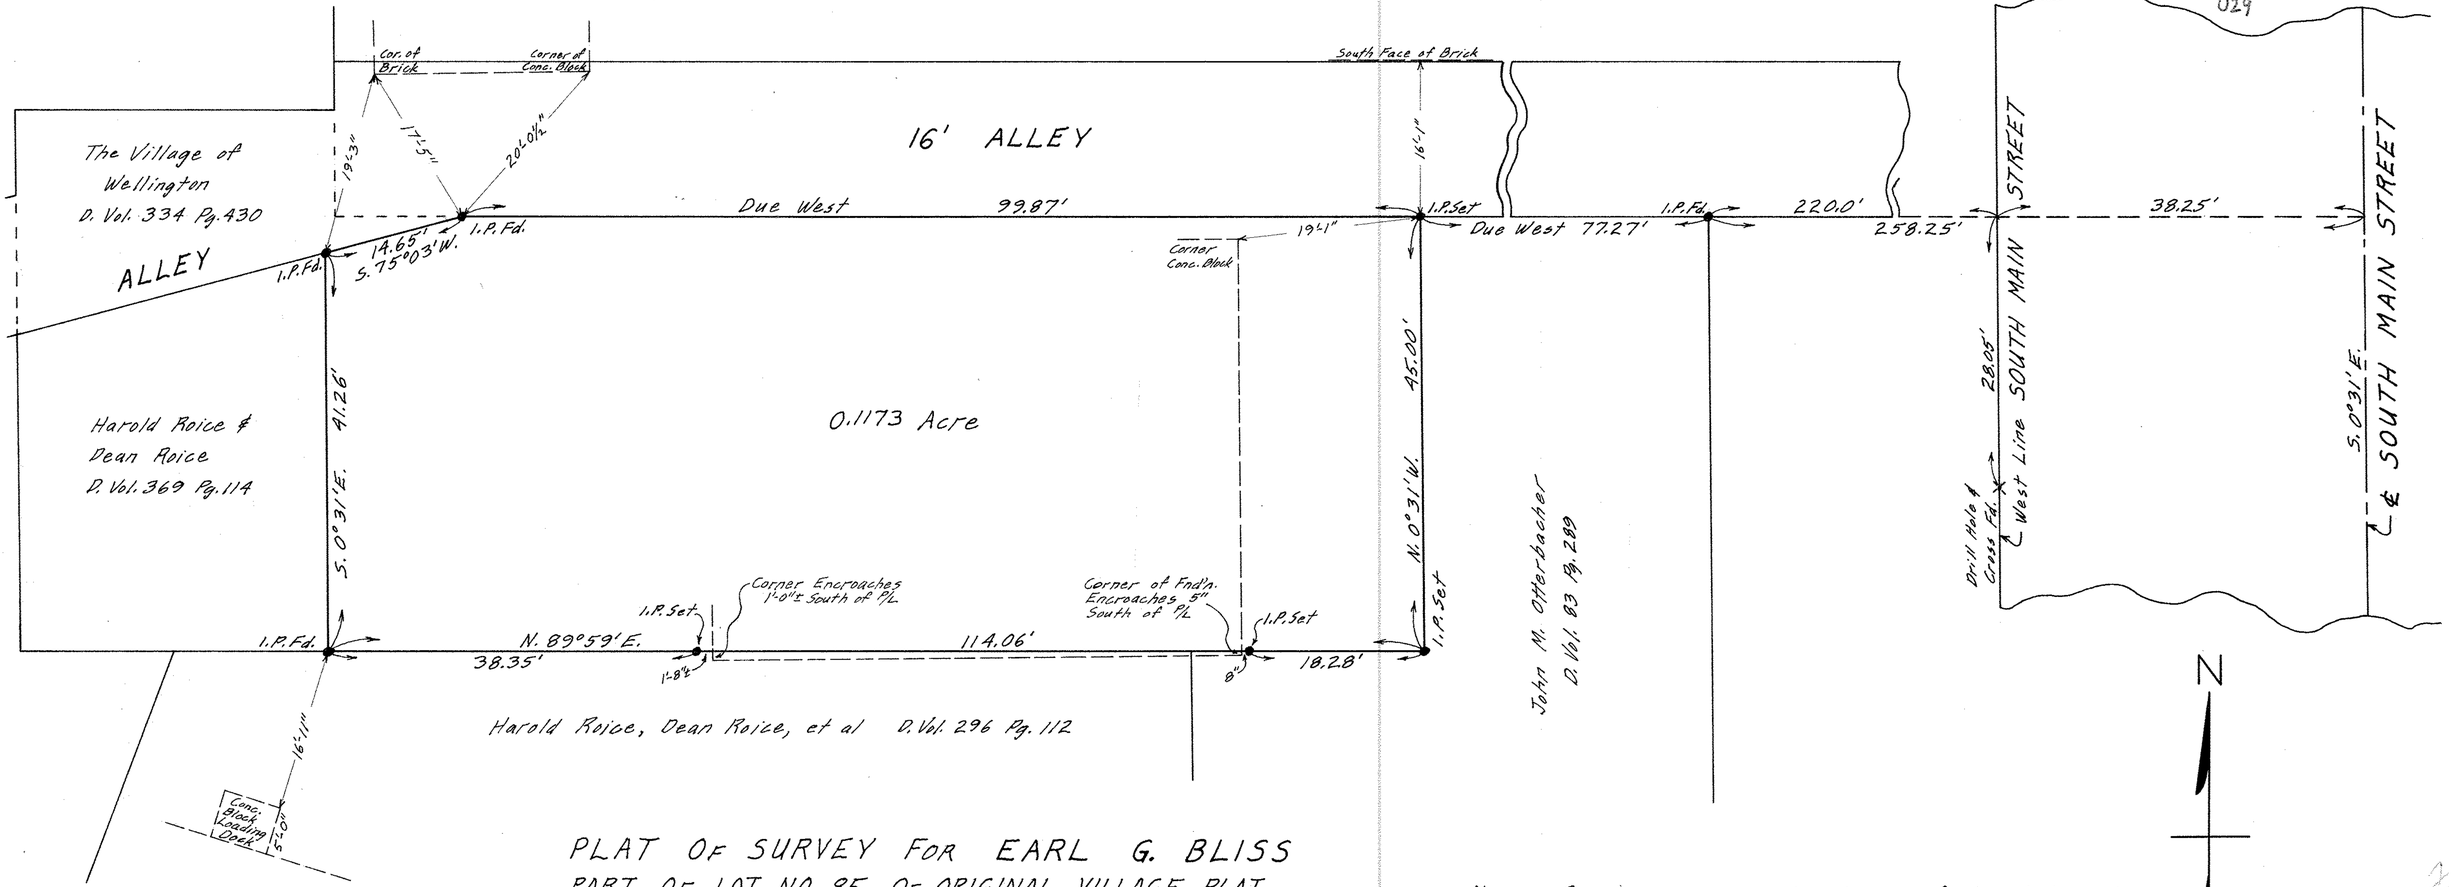

PLAT OF SURVEY FOR EARL G. BLISS
PART OF LOT NO. 85 OF ORIGINAL VILLAGE PLAT
ORIGINAL LOT NO. 27 WELLINGTON TOWNSHIP
WELLINGTON VILLAGE - LORAIN COUNTY - OHIO
SCALE: 1" = 10' SEPTEMBER 1965
Gary E. Penfound Registered Surveyor No. 4457

NOTES: Survey measurements given in feet and decimals.
Reference measurements given in feet and inches.

18-00-027