02-01-006-104-001 thru-014
018 thru-027
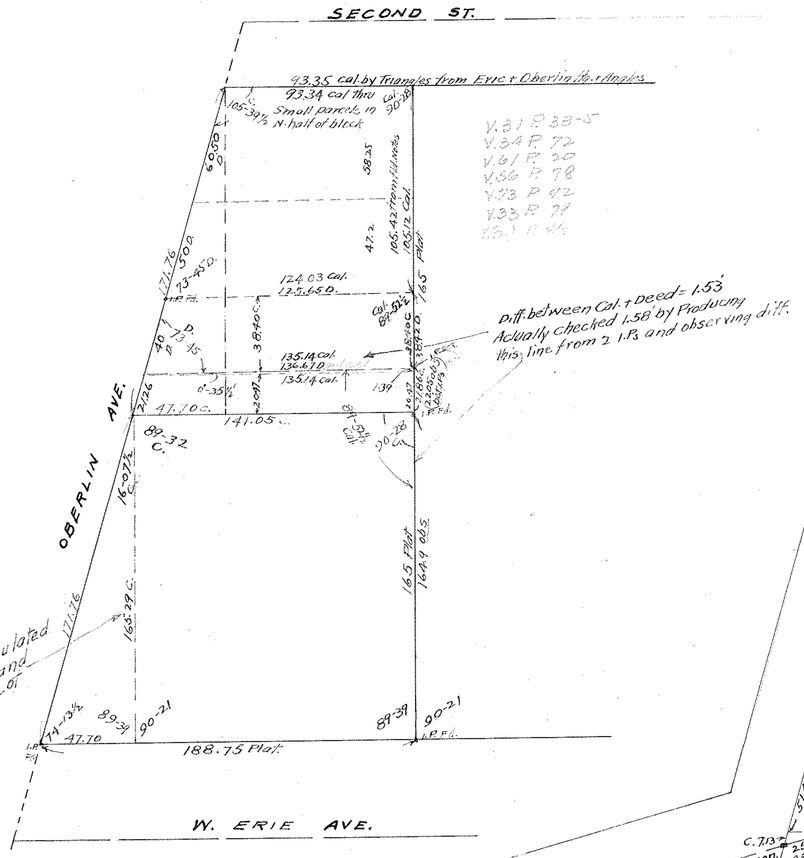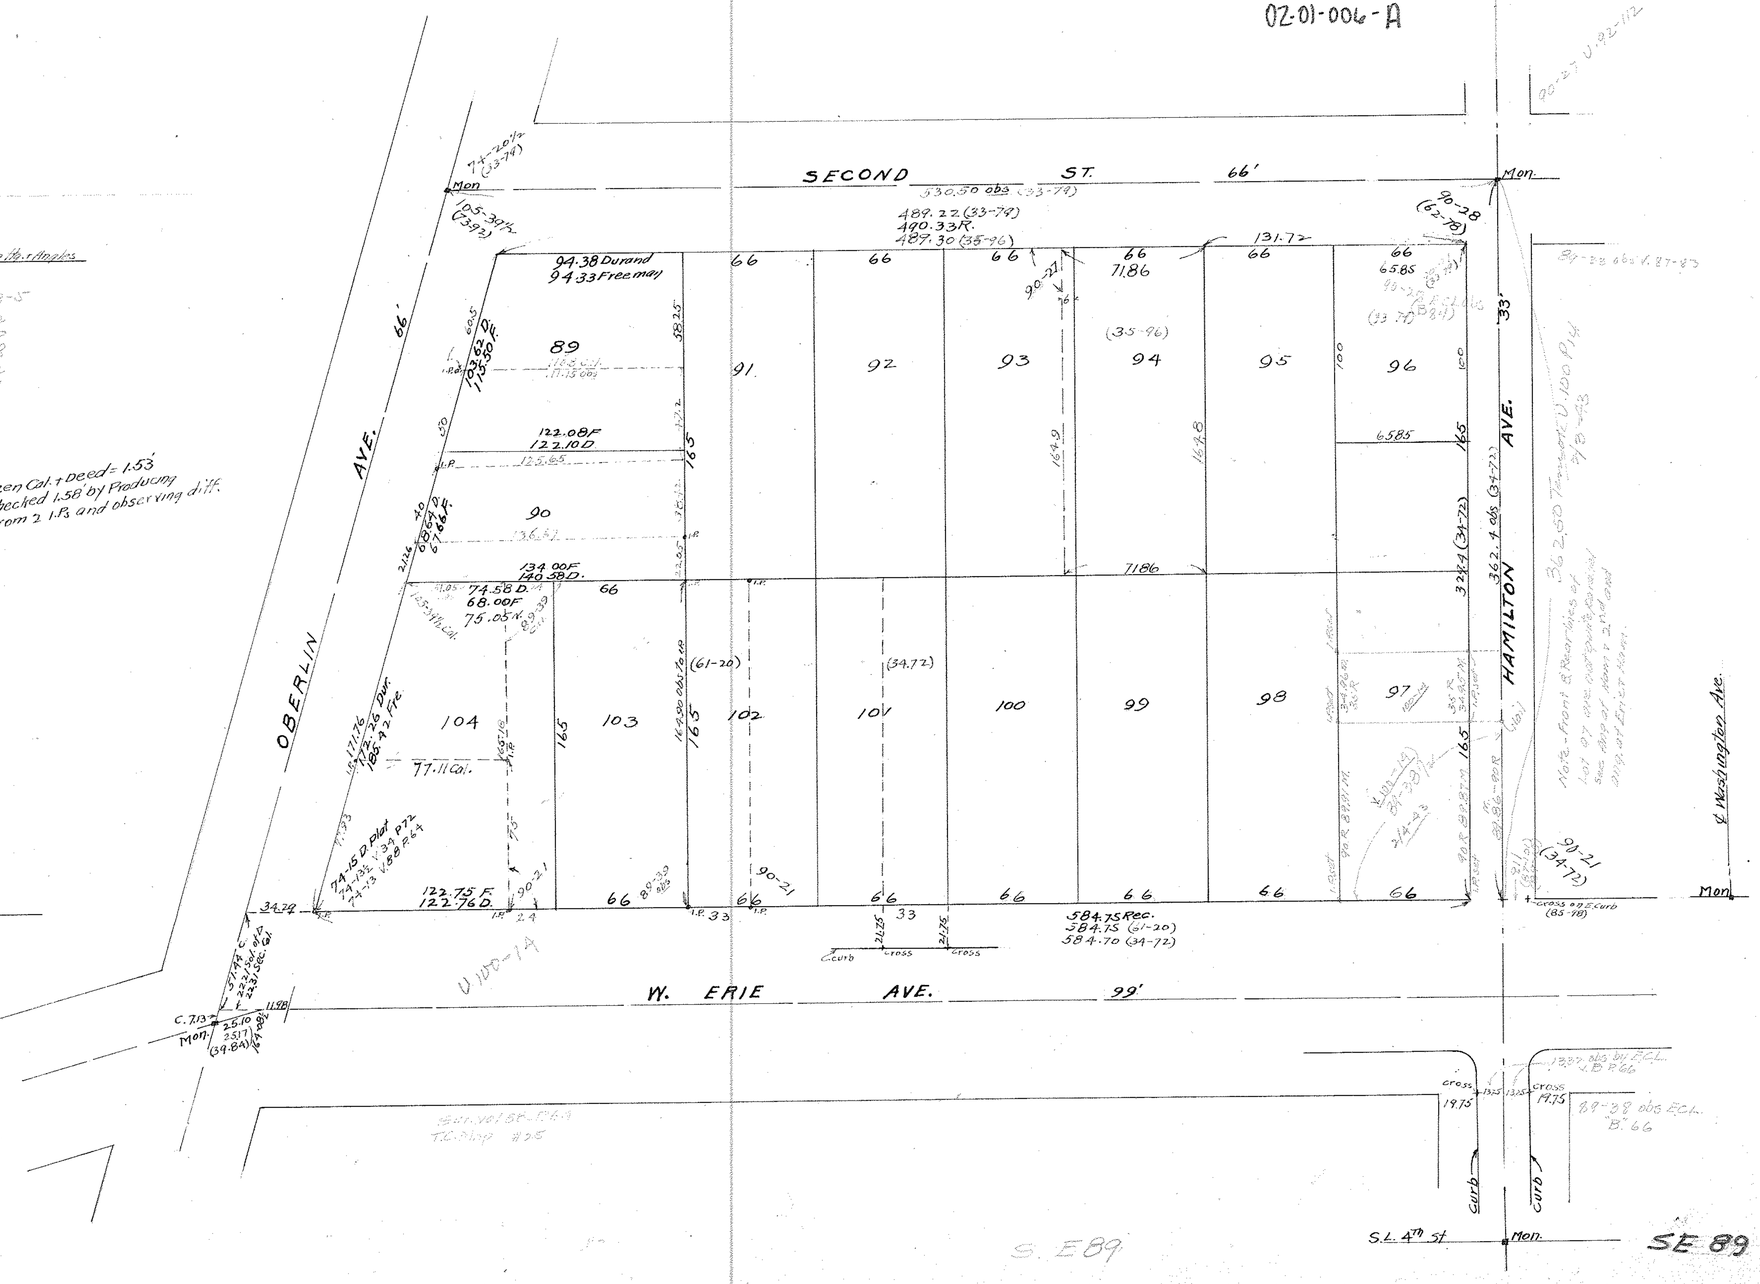
02-01-006-A