


MAPLE ST. 50'

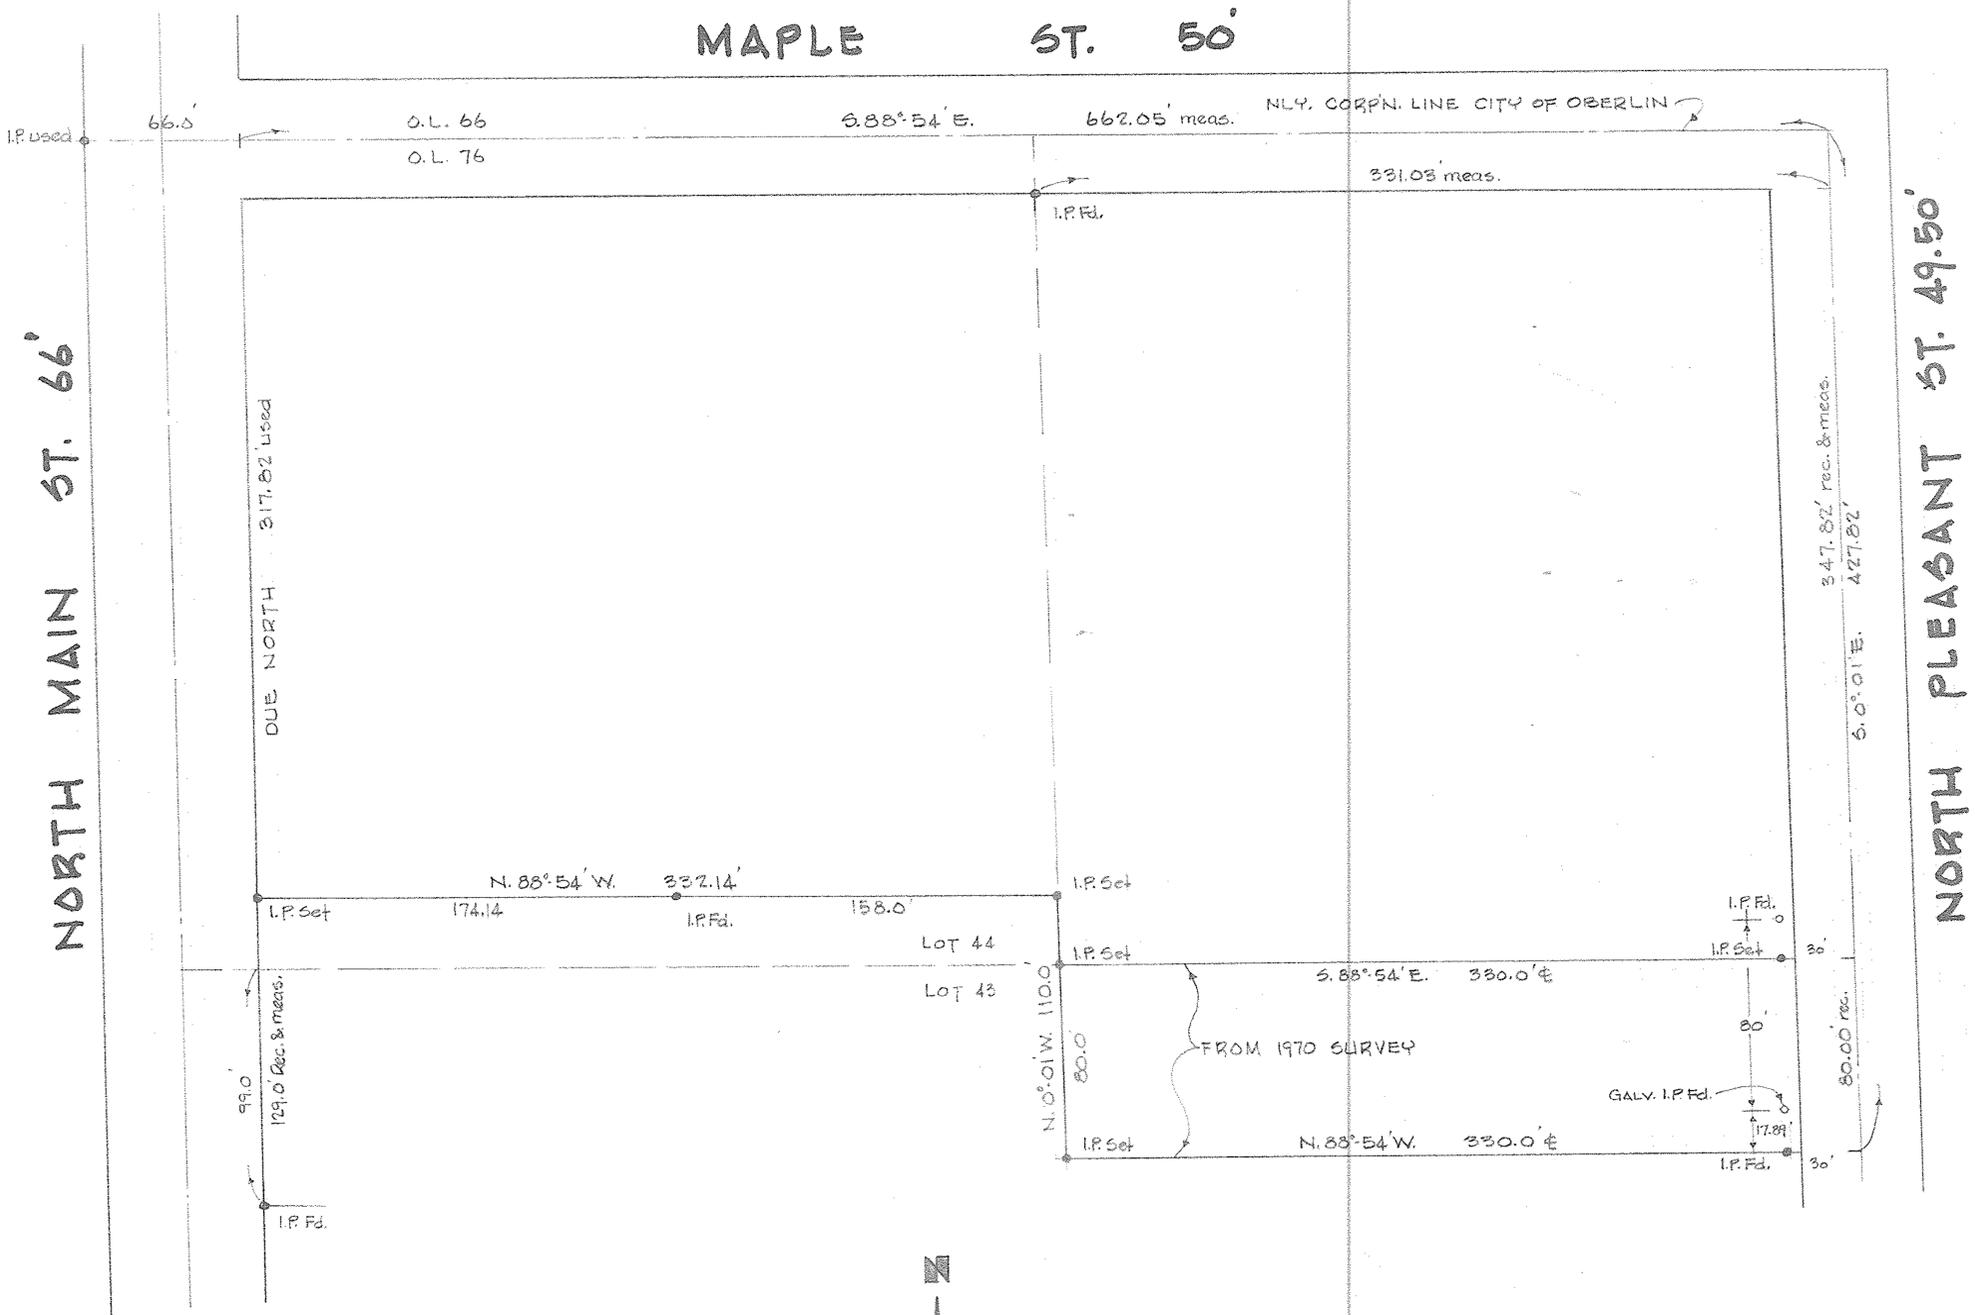

NORTH MAIN ST. 66'

NORTH PLEASANT ST. 49.50'

NOTE:
 BEARINGS SHOWN ARE ASSUMED AND
 USED TO DESCRIBE ANGLES ONLY.



SURVEY SKETCH FOR
 RET. COL. & MRS. NORMAN LONG

PARTS OF ORIG. LOTS 43 & 44 O.V.P. of OBERLIN VILLAGE
 O.L. 76 RUSSIA TWP. CITY OF OBERLIN LORAIN CO., OHIO
 SCALE 1" = 50'
 AUGUST, 1981
 LAUNDON • SIMON • CAHL & ASSOCIATES ENGINEERS - SURVEYORS

451980