SURVEY

OF

50 ACRES IN THE SOUTHERLY PART

OF

LOT 15 SEC. 2

BLACK RIVER TOWNSHIP LORAIN CO., O.
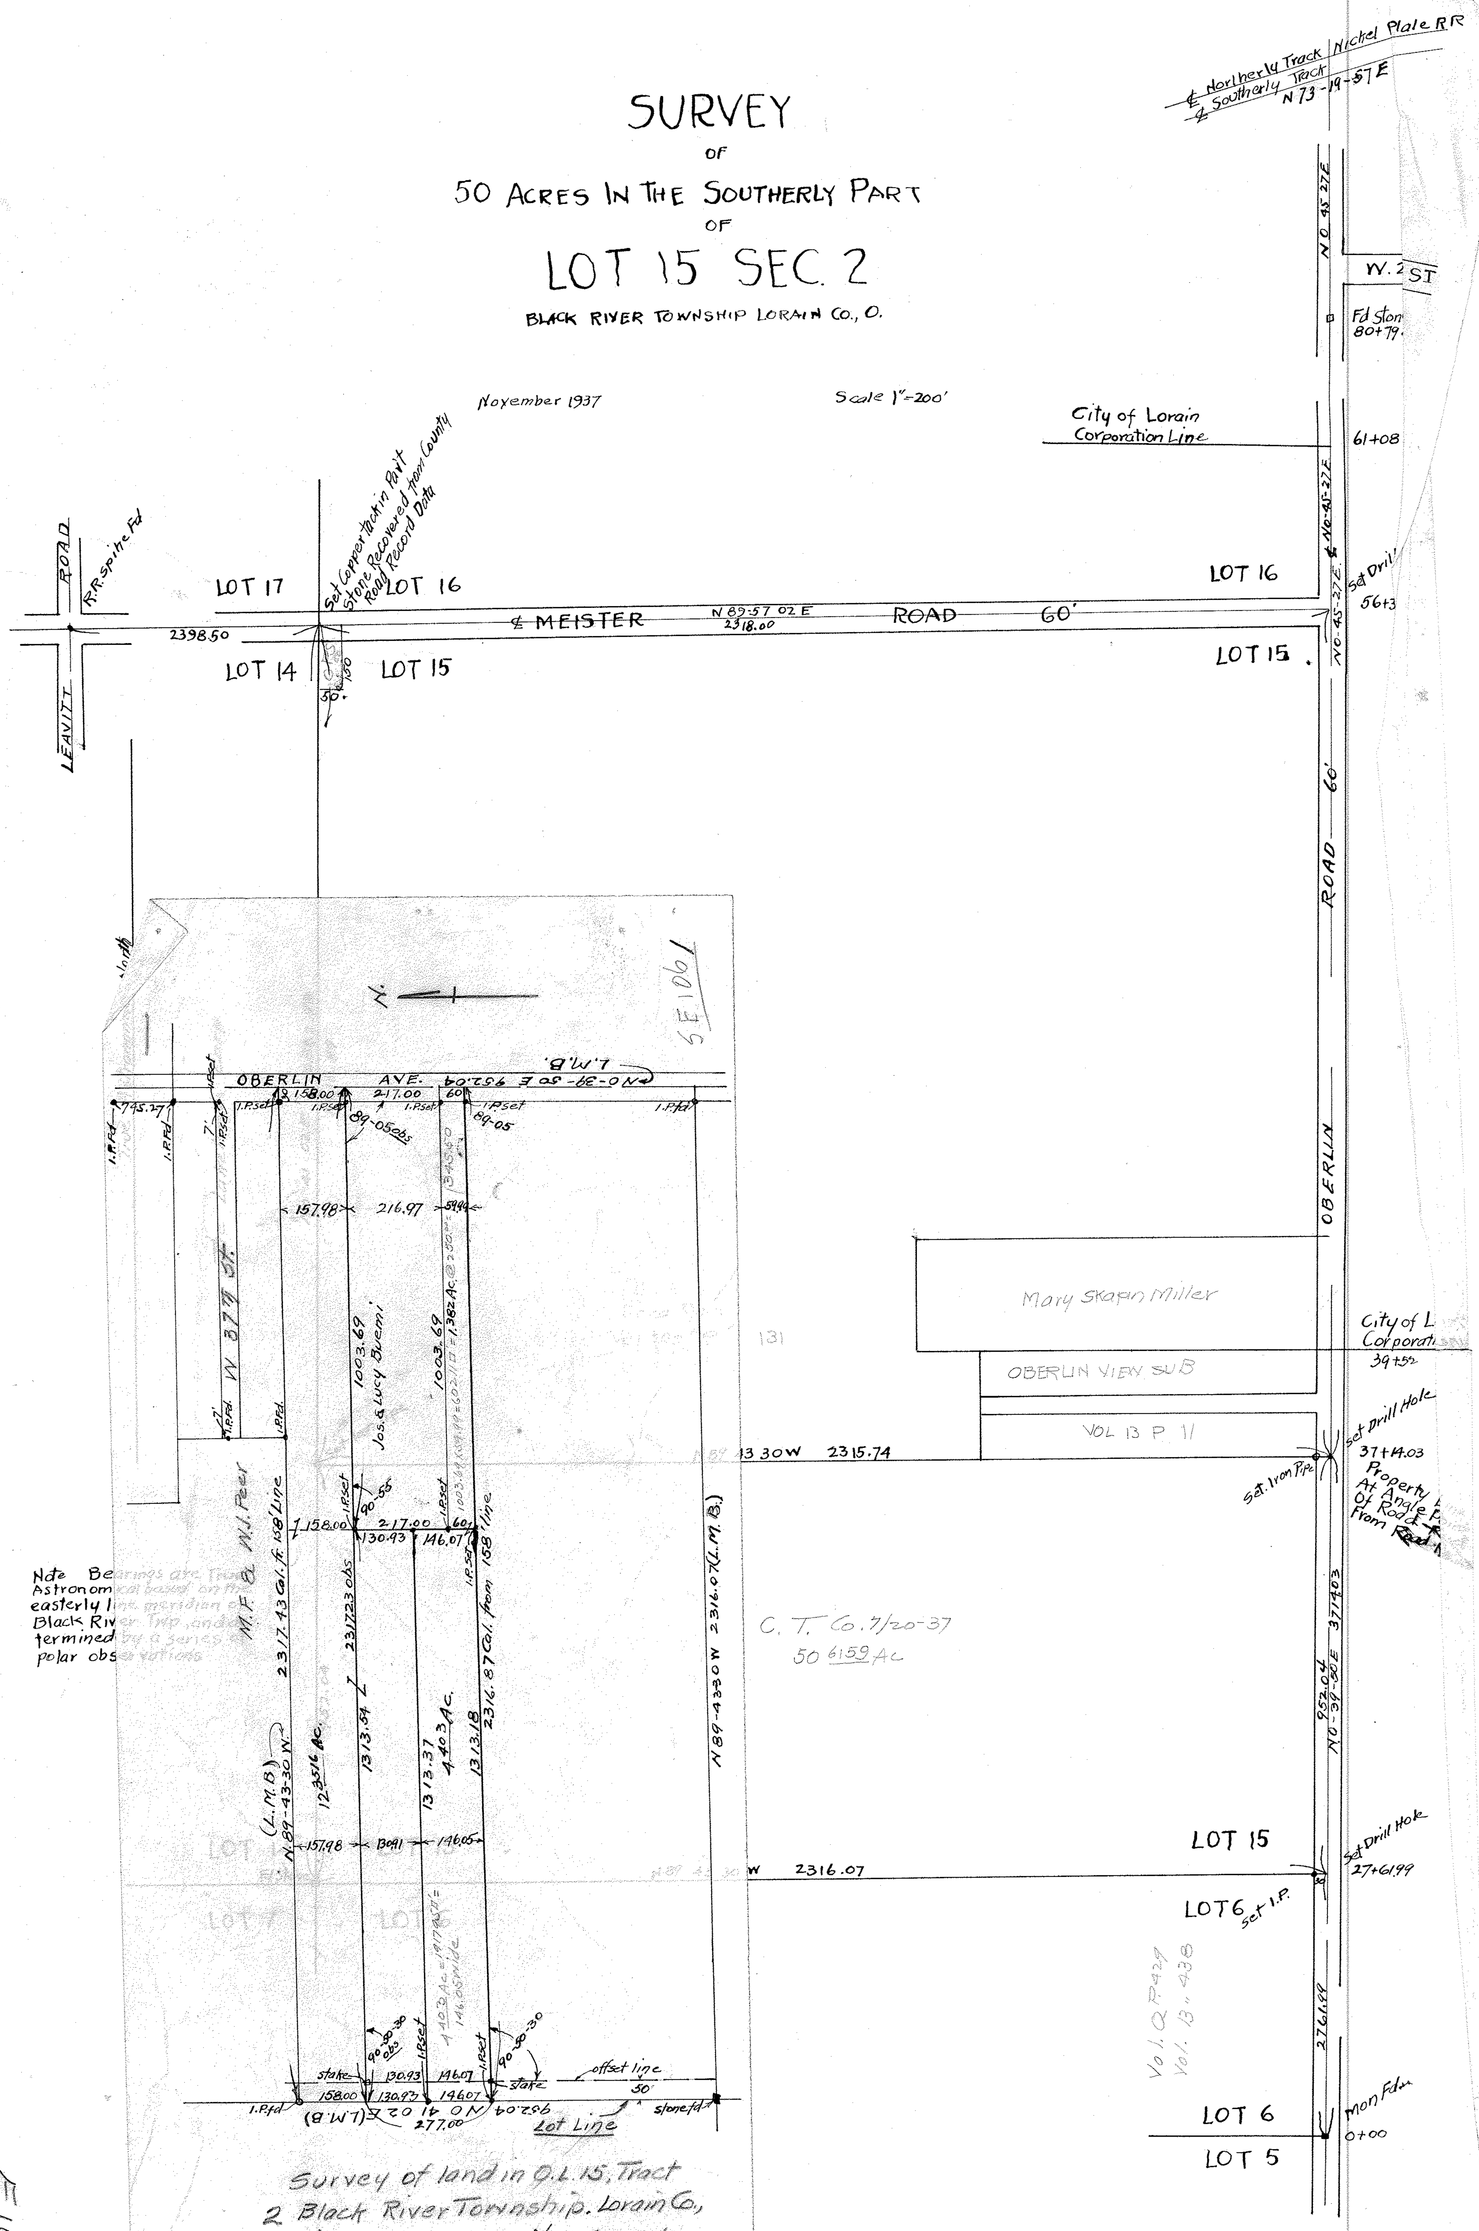
November 1937 — Scale 1" = 200'