02-01-004-B
02-01-003-C
02-01-004-101

"Exhibit-A"

MAP

SHOWING PROPERTY IN THE CITY OF LORAIN, OHIO.

ABUTTING on what was formerly the old ELYRIA ROAD (sometimes called the PLANK ROAD) lying between the north line of Eighth Street and said north line extended easterly, and the south line of a lot deeded to Minnie Dorn by deed recorded in Vol. 133, P. 235, Lorain Co. Deed Records.
Iron pins were found or set at all points so indicated on the map. All measurements are given in feet and decimals thereof. All of which I hereby certify to be correct.

LORAIN. O. Sept. 8, 1916.

E. C. Loeffbauer
Surveyor.
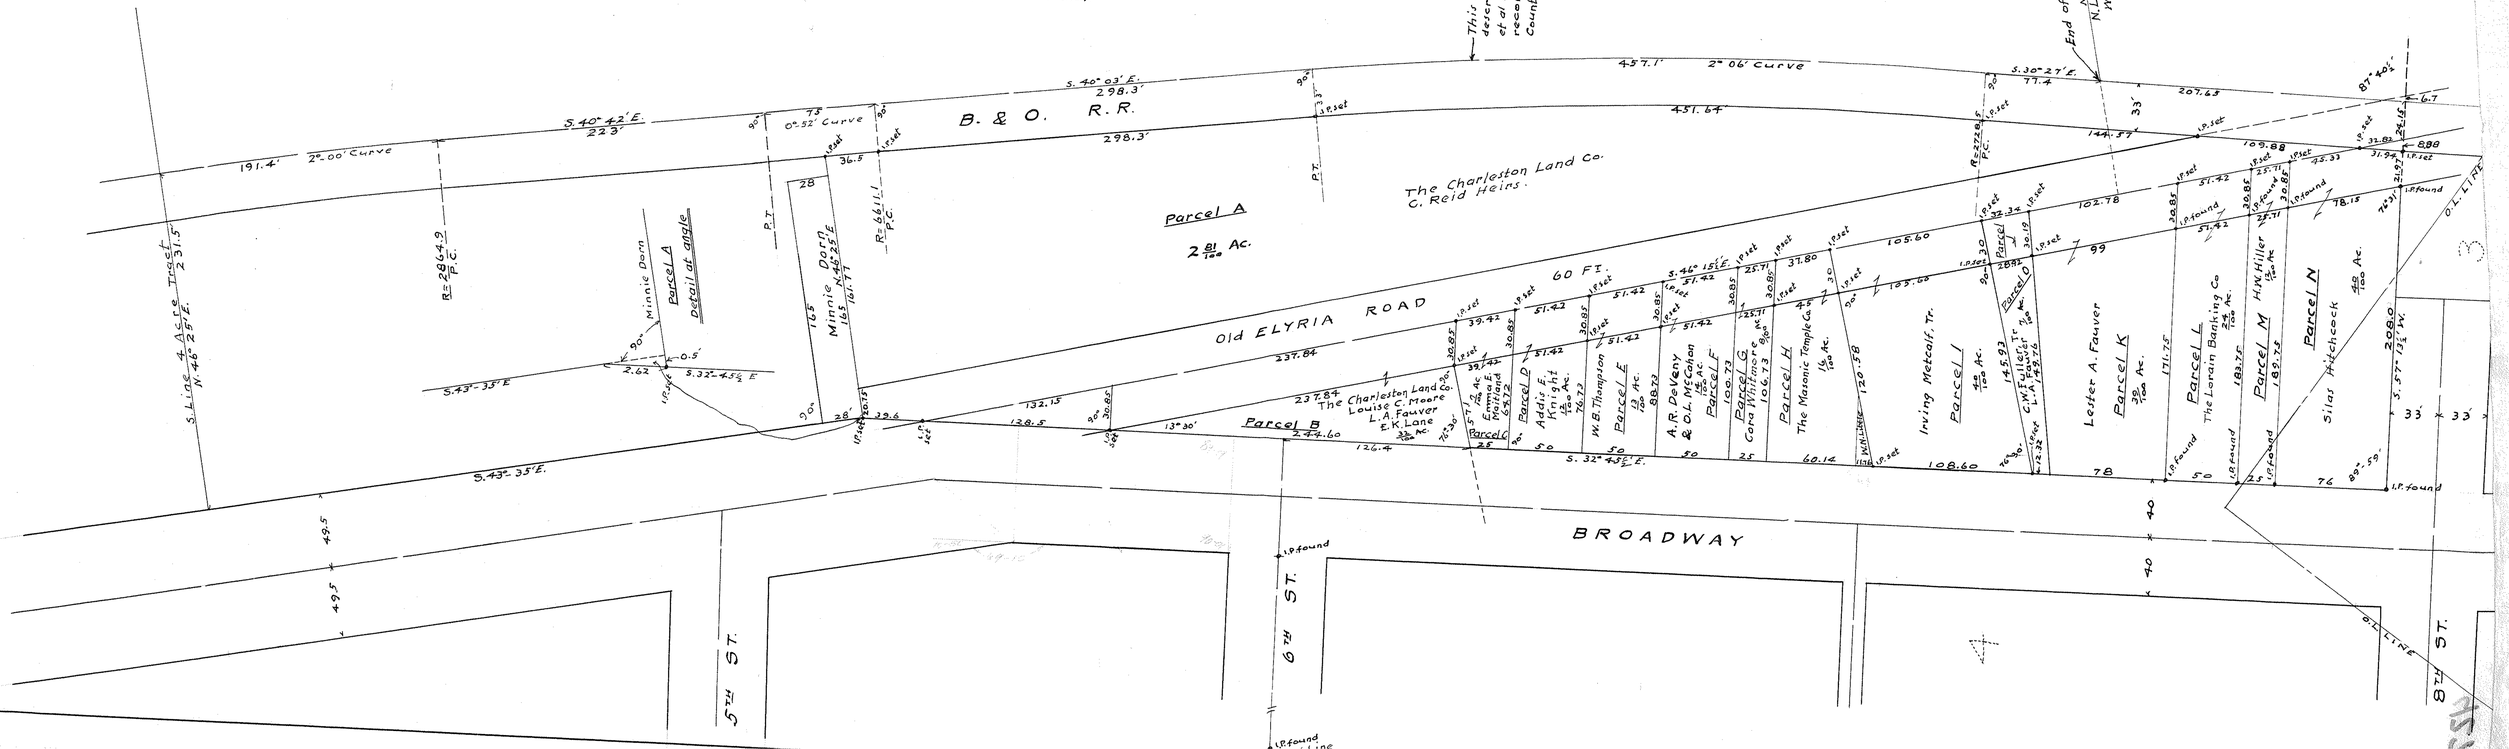
SCALE 50 Ft = 1 Inch.