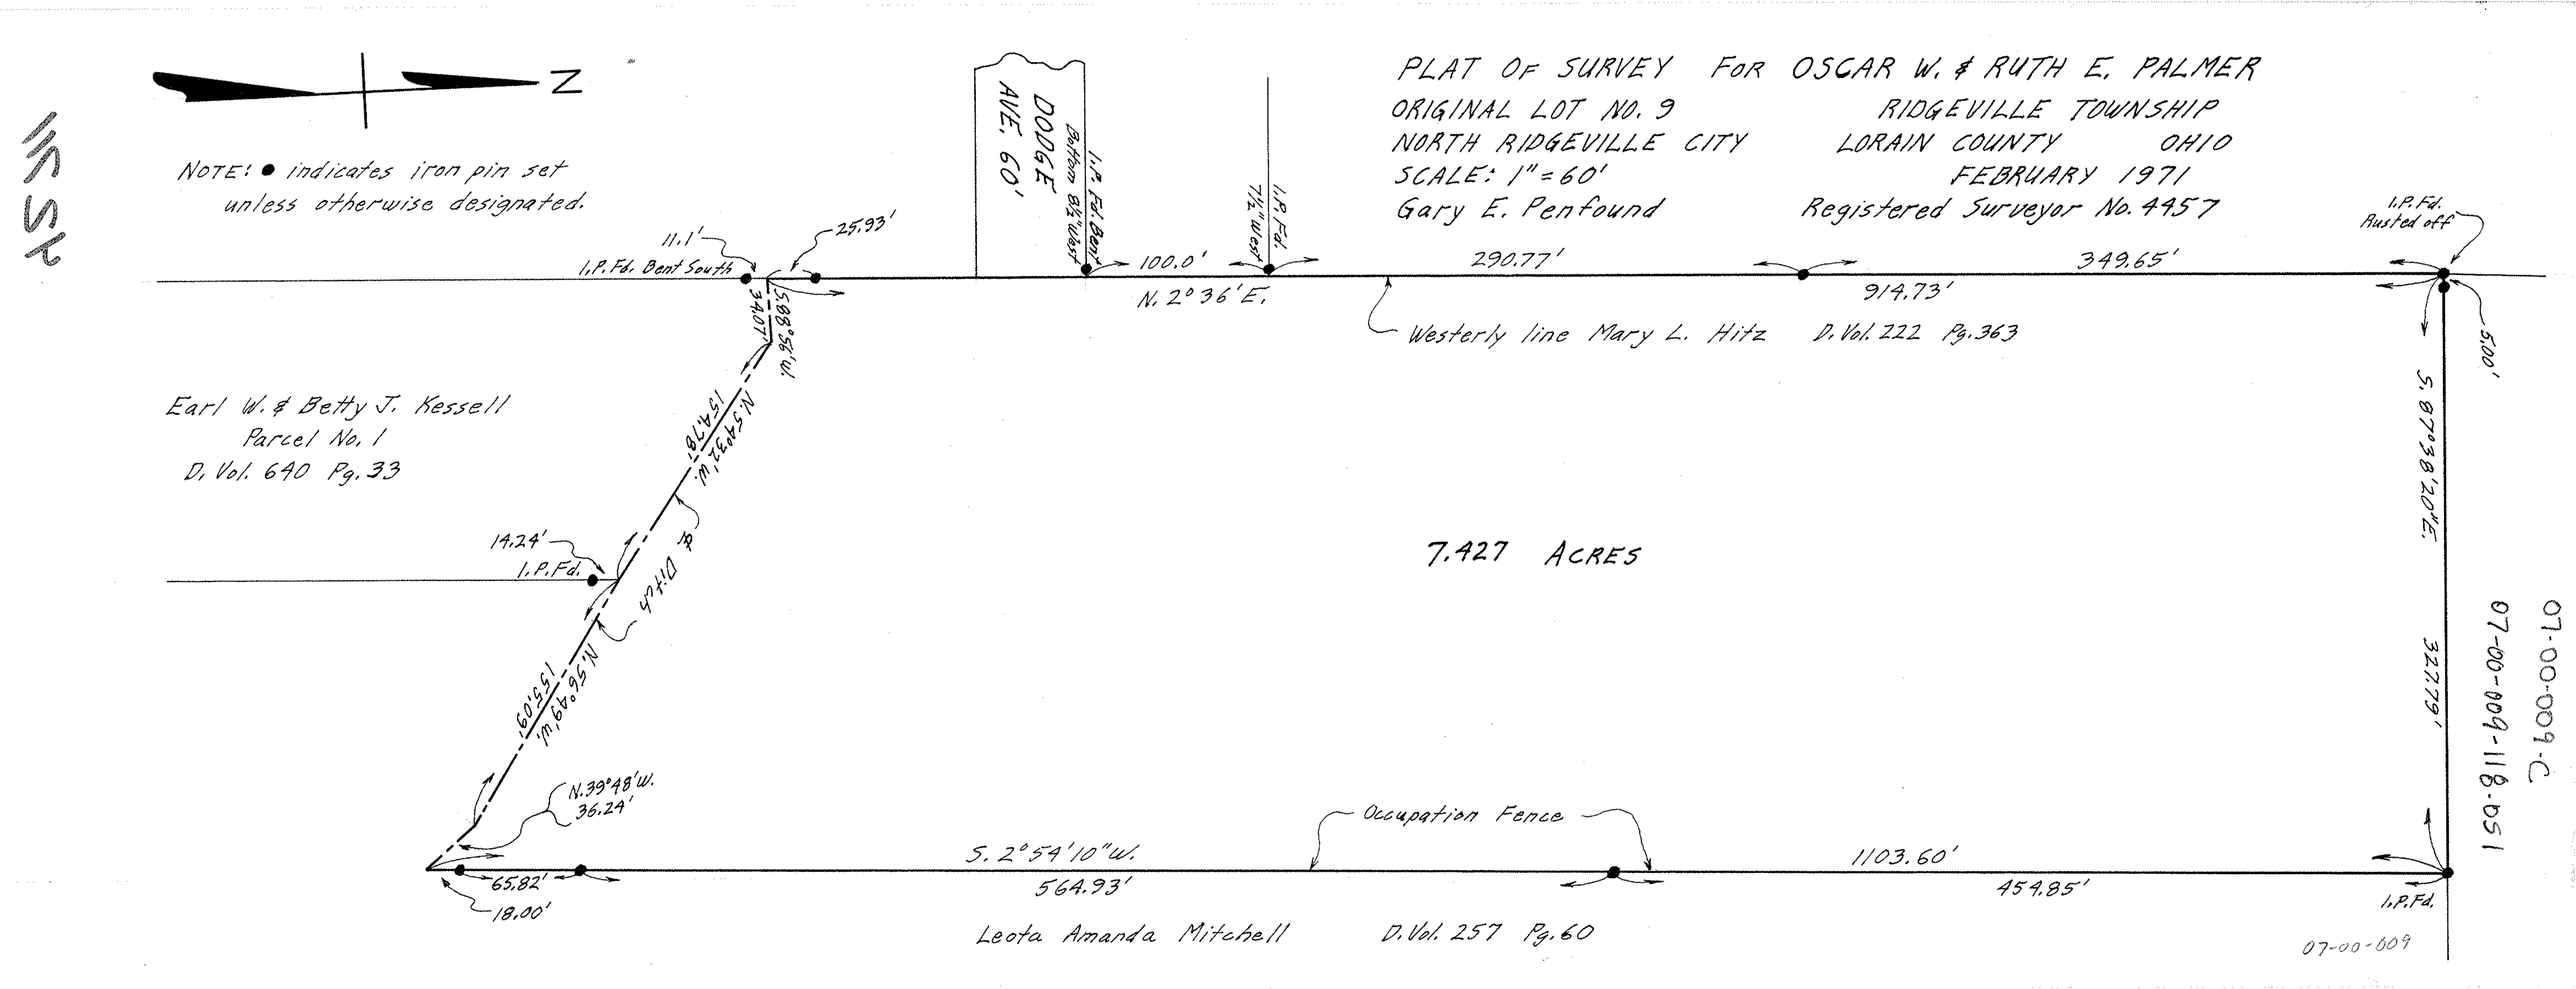
PLAT OF SURVEY FOR OSCAR W. & RUTH E. PALMER
ORIGINAL LOT NO. 9
RIDGEVILLE TOWNSHIP
NORTH RIDGEVILLE CITY
LORAIN COUNTY OHIO
SCALE: 1" = 60'
FEBRUARY 1971
Gary E. Penfound
Registered Surveyor No. 4457
N
NOTE: ● indicates iron pin set unless otherwise designated.
DODGE AVE. 60'
I.P. Fd. Bent Bottom 8½" West
I.P. Fd. 7½" West
I.P. Fd. Rusted off
I.P. Fd. Bent South
11.1'
25.93'
100.0'
N. 2° 36' E.
290.77'
349.65'
914.73'
5.00'
S. 87° 38' 20" E.
327.79'
Westerly line Mary L. Hitz D. Vol. 222 Pg. 363
Earl W. & Betty J. Kessell
Parcel No. 1
D. Vol. 640 Pg. 33
S. 88° 56' W.
34.07'
N. 54° 32' W.
154.78'
14.24'
I.P. Fd.
& Ditch
N. 56° 49' W.
155.09'
N. 39° 48' W.
36.24'
7.427 ACRES
Occupation Fence
S. 2° 54' 10" W.
564.93'
1103.60'
454.85'
65.82'
18.00'
I.P. Fd.
Leota Amanda Mitchell D. Vol. 257 Pg. 60
07-00-009-C
07-00-009-118.051
07-00-009