10-00-004-101-126
10-00-004-A 127

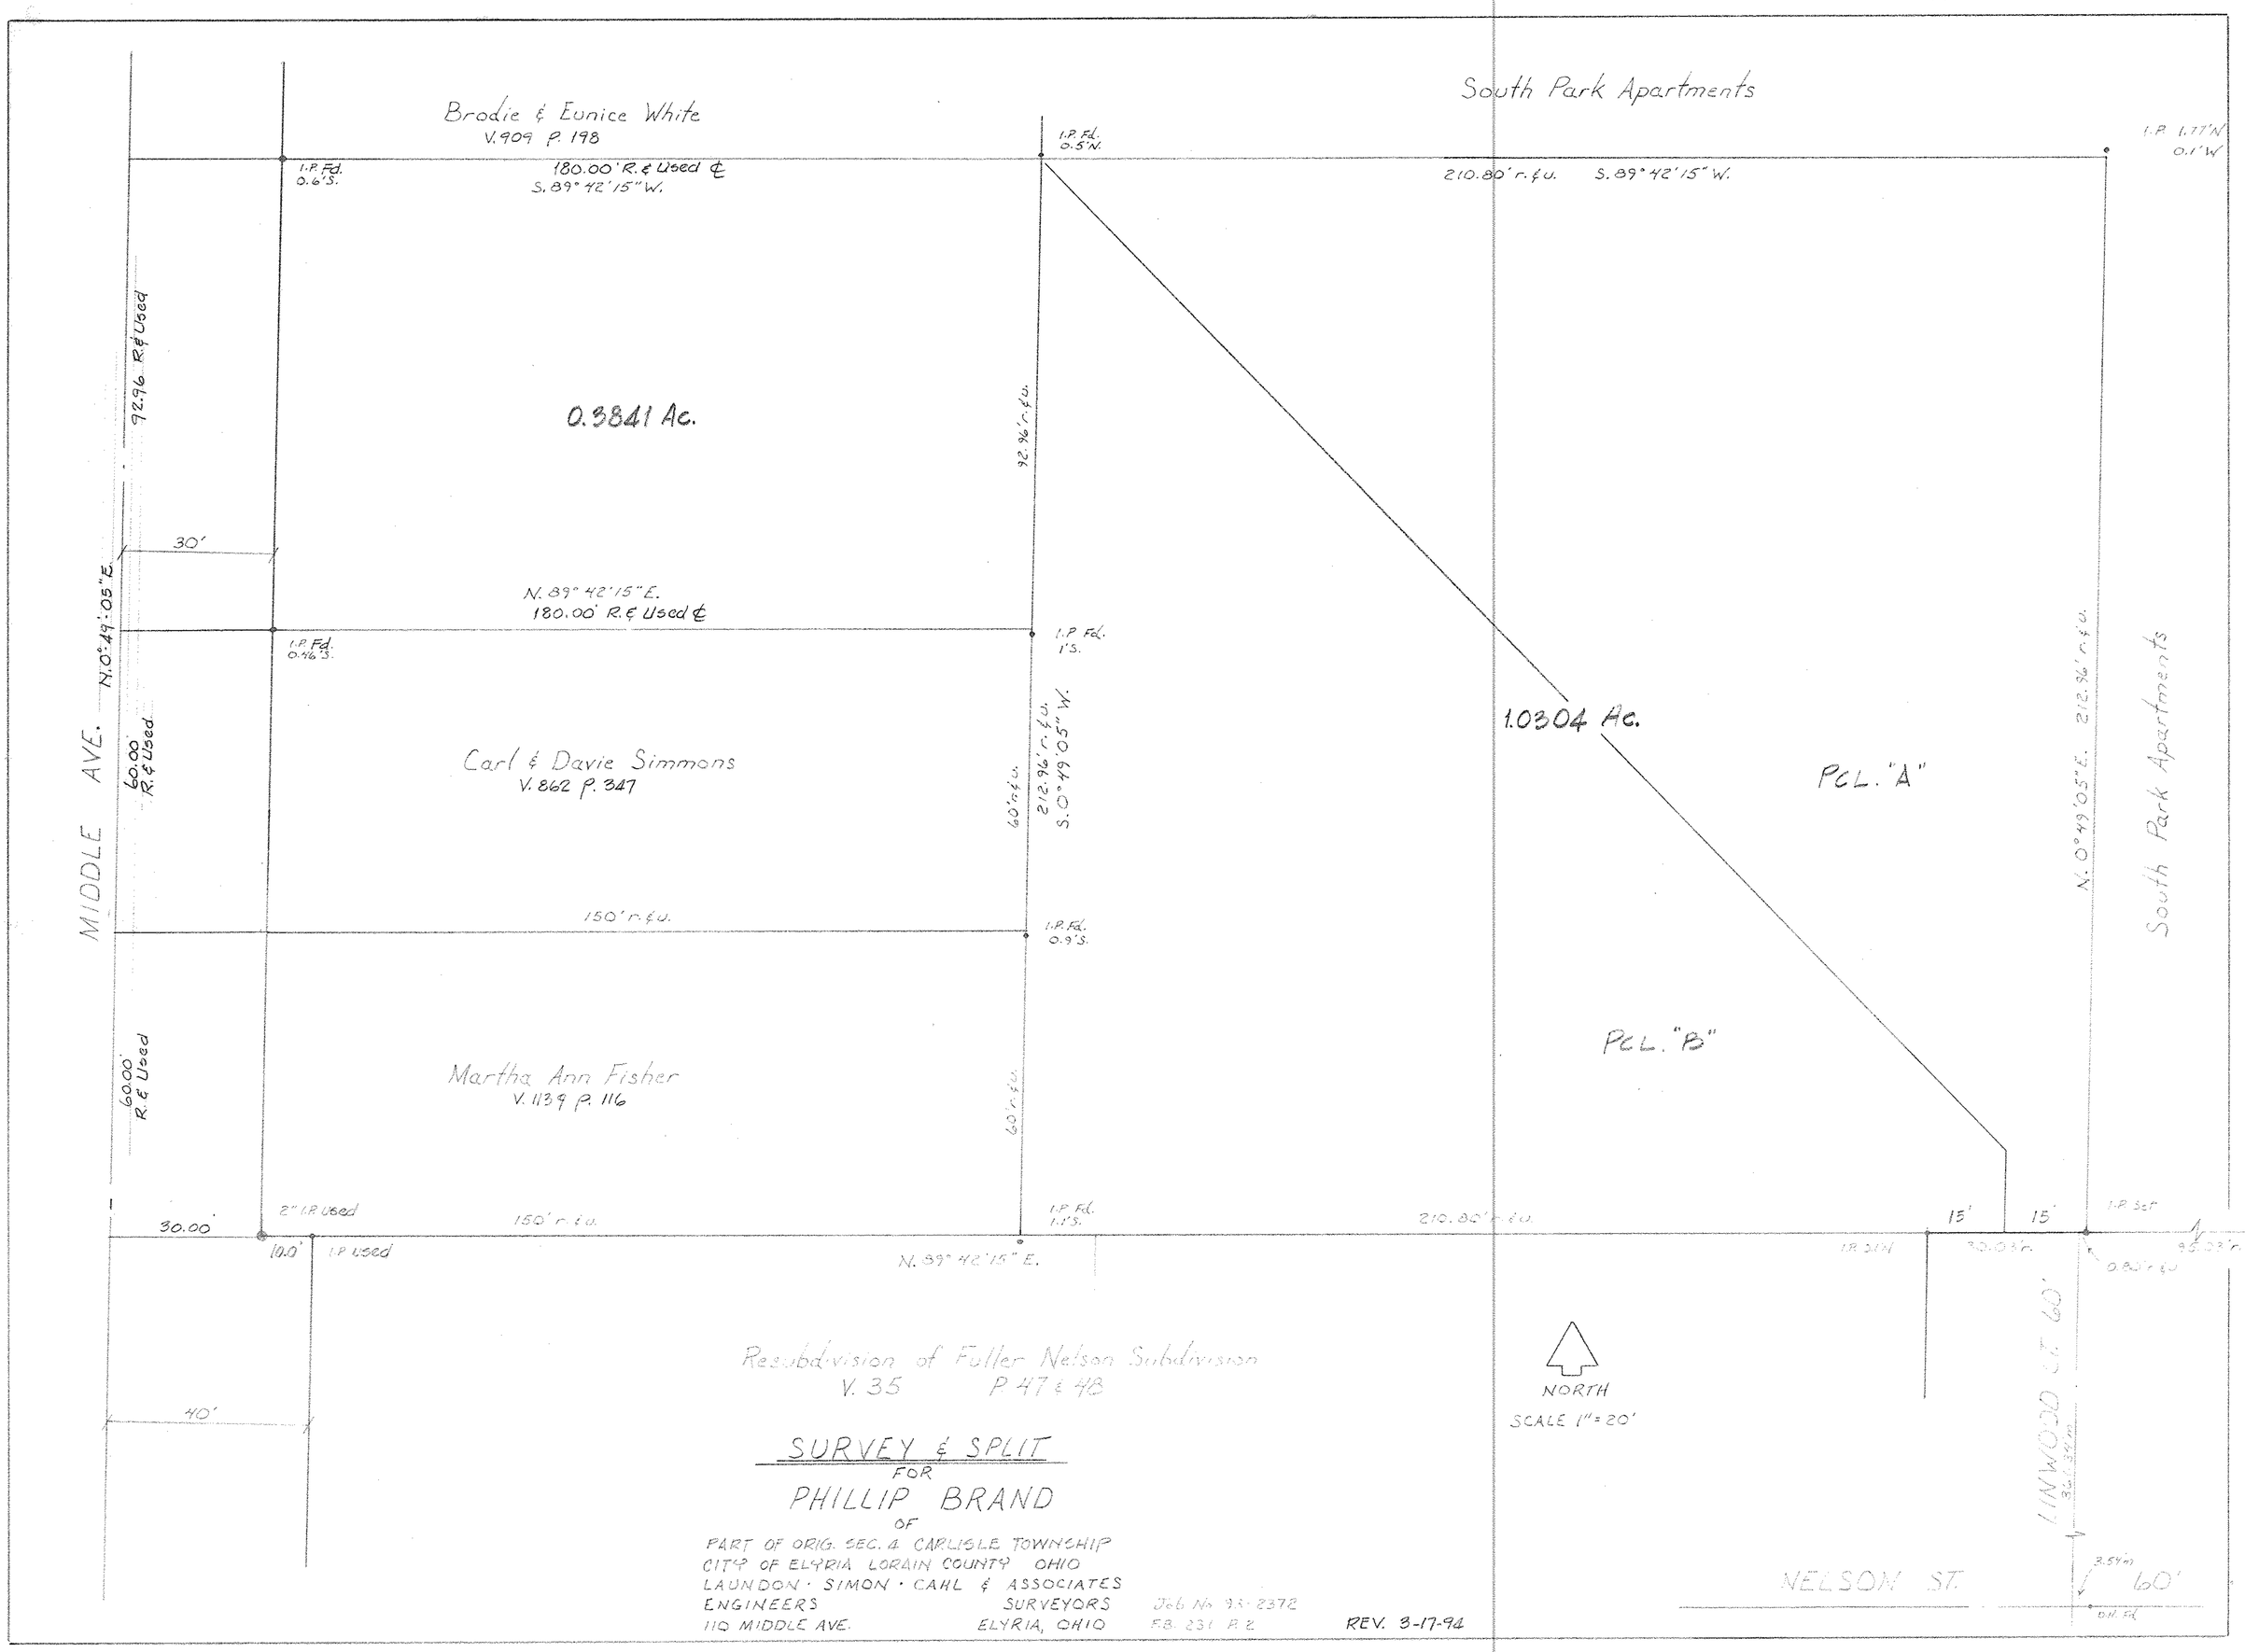

SURVEY & SPLIT
FOR
PHILLIP BRAND
OF
PART OF ORIG. SEC. 4 CARLISLE TOWNSHIP
CITY OF ELYRIA LORAIN COUNTY OHIO
LAUNDON · SIMON · CAHL & ASSOCIATES
ENGINEERS SURVEYORS
110 MIDDLE AVE. ELYRIA, OHIO
Job No. 93-2372
F.B. 231 P. 2
REV. 3-17-94

283