
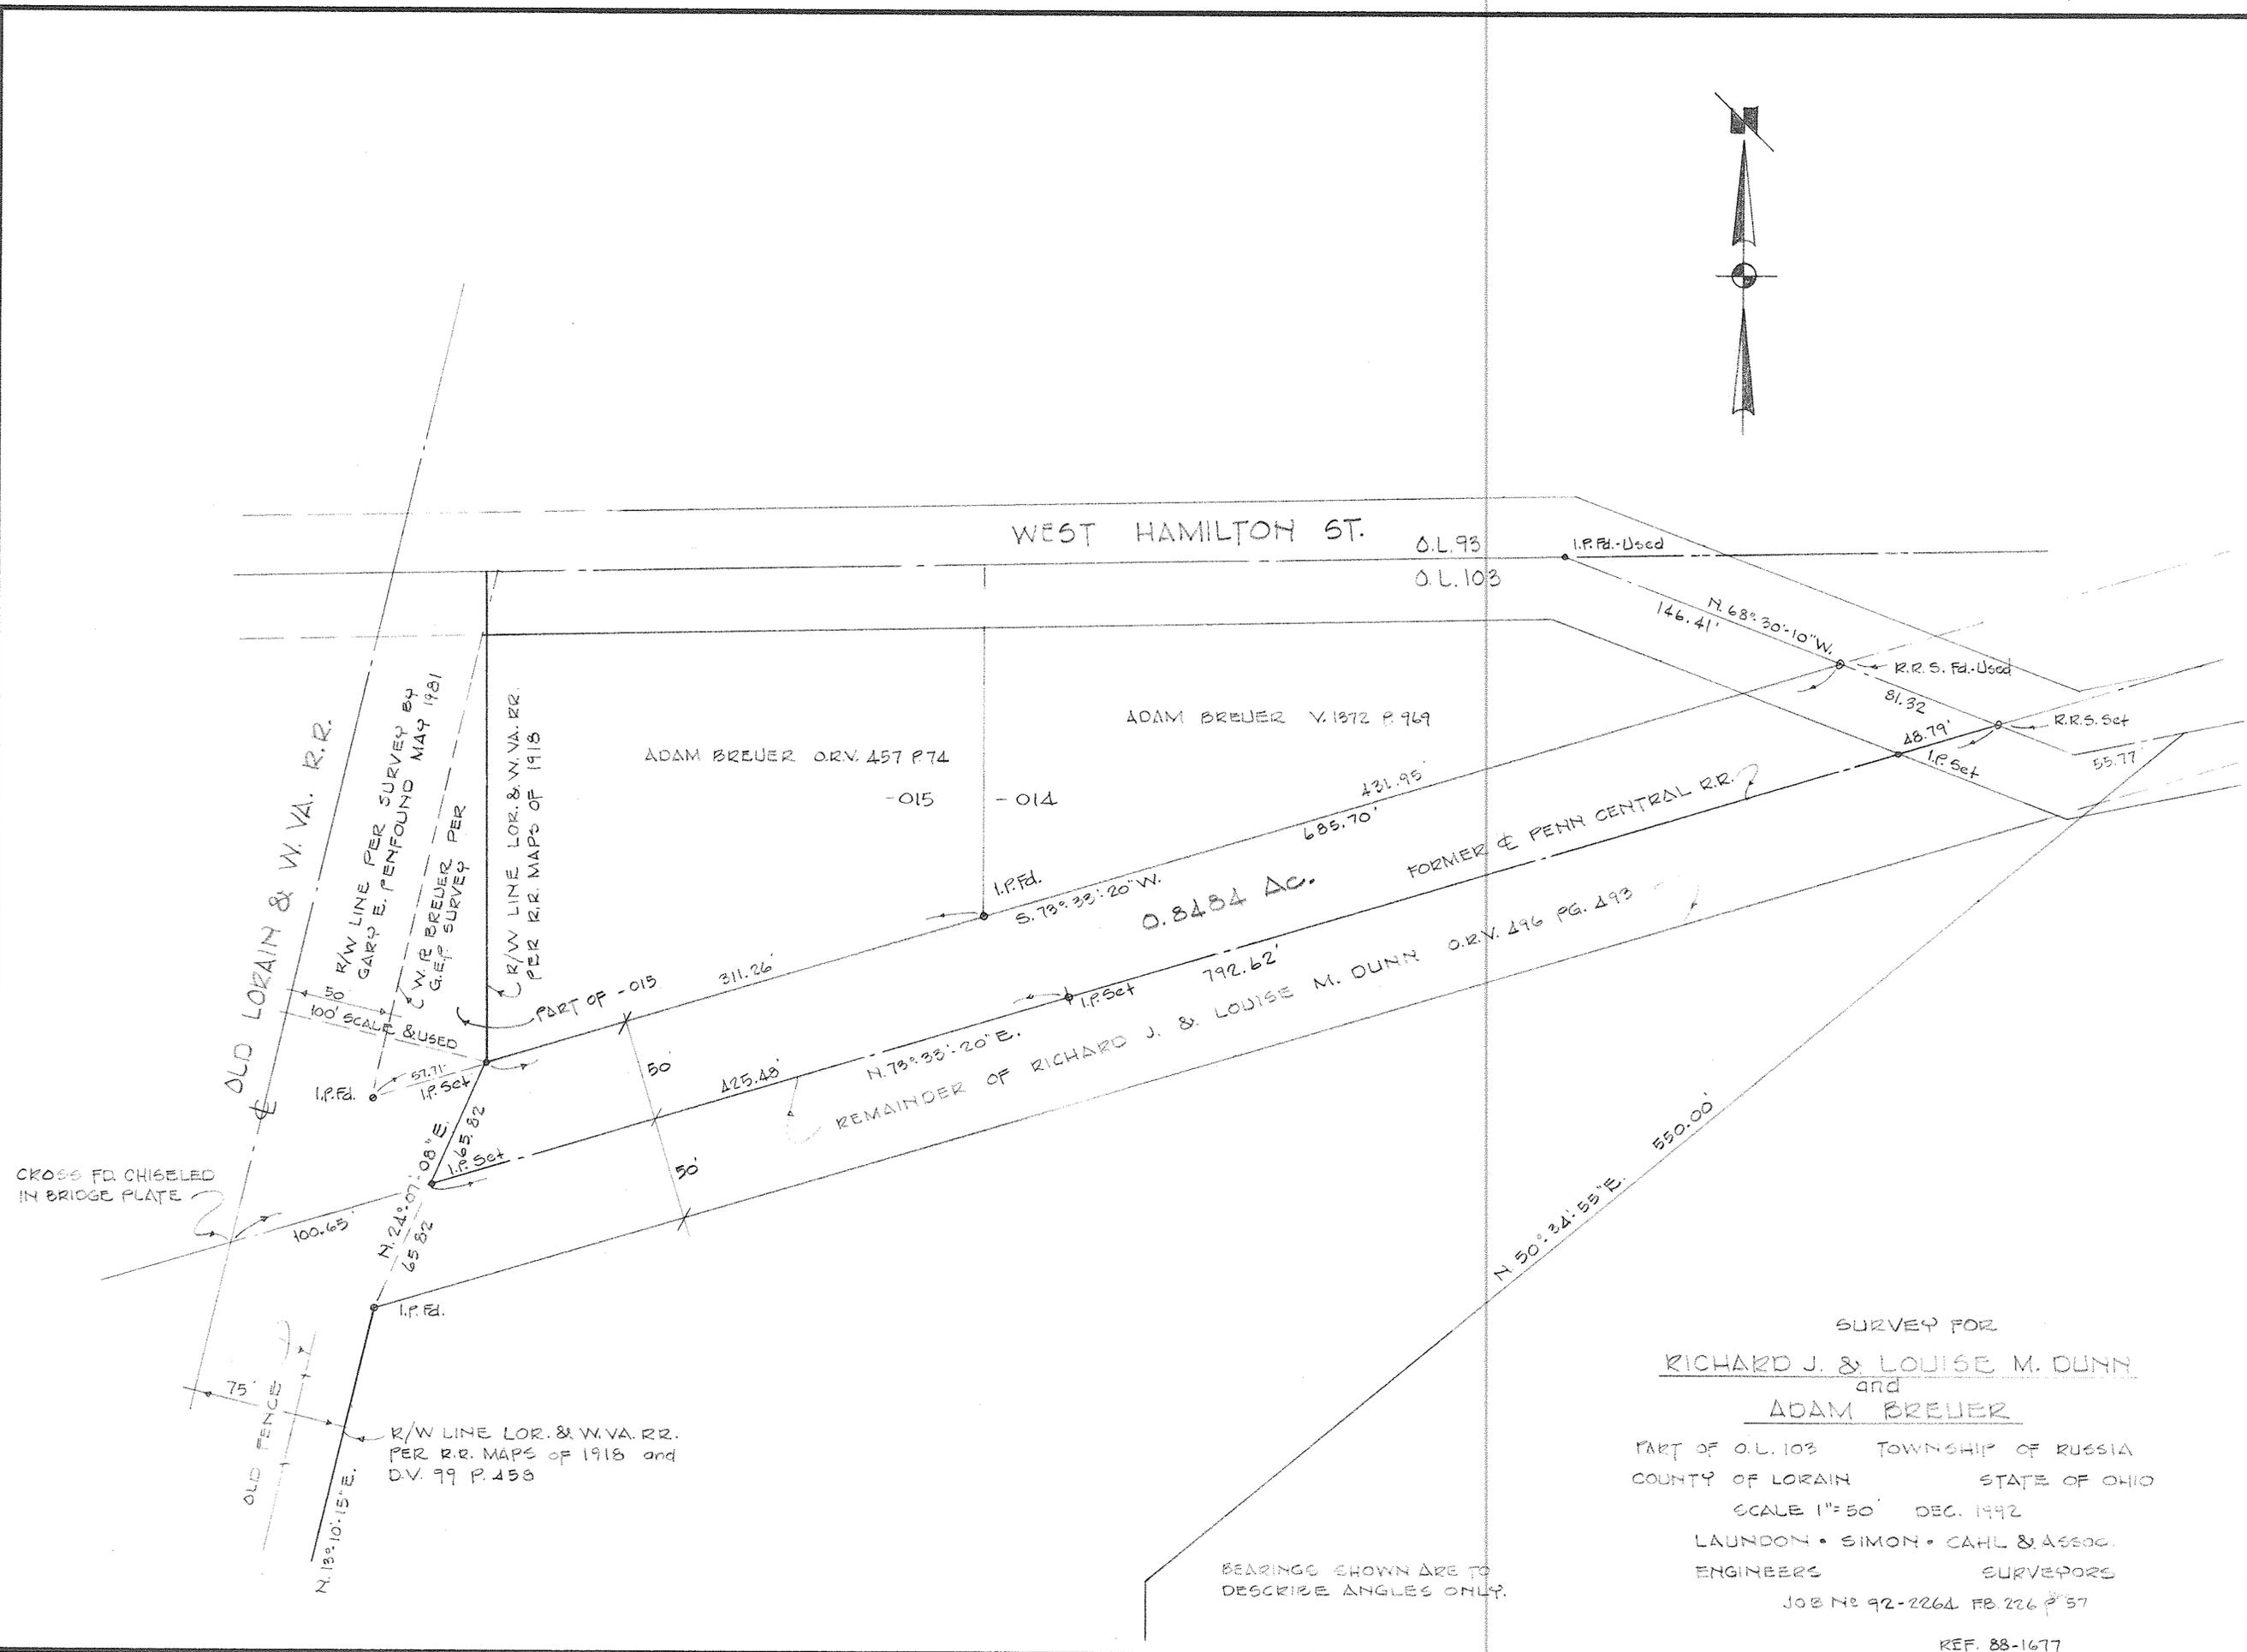


PLATE 2

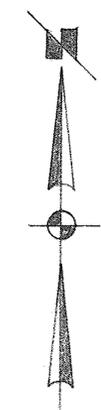

SURVEY FOR
RICHARD J. & LOUISE M. DUNN
 and
ADAM BREUER
 PART OF O.L. 103 TOWNSHIP OF RUSSIA
 COUNTY OF LORAIN STATE OF OHIO
 SCALE 1"=50' DEC. 1992
 LAUNDON • SIMON • CAHL & ASSOC.
 ENGINEERS SURVEYORS
 JOB NO 92-2264 FB. 226 P 57
 REF. 88-1677

BEARINGS SHOWN ARE TO DESCRIBE ANGLES ONLY.