03-00-046-120-005
016
03-00-046-B 015

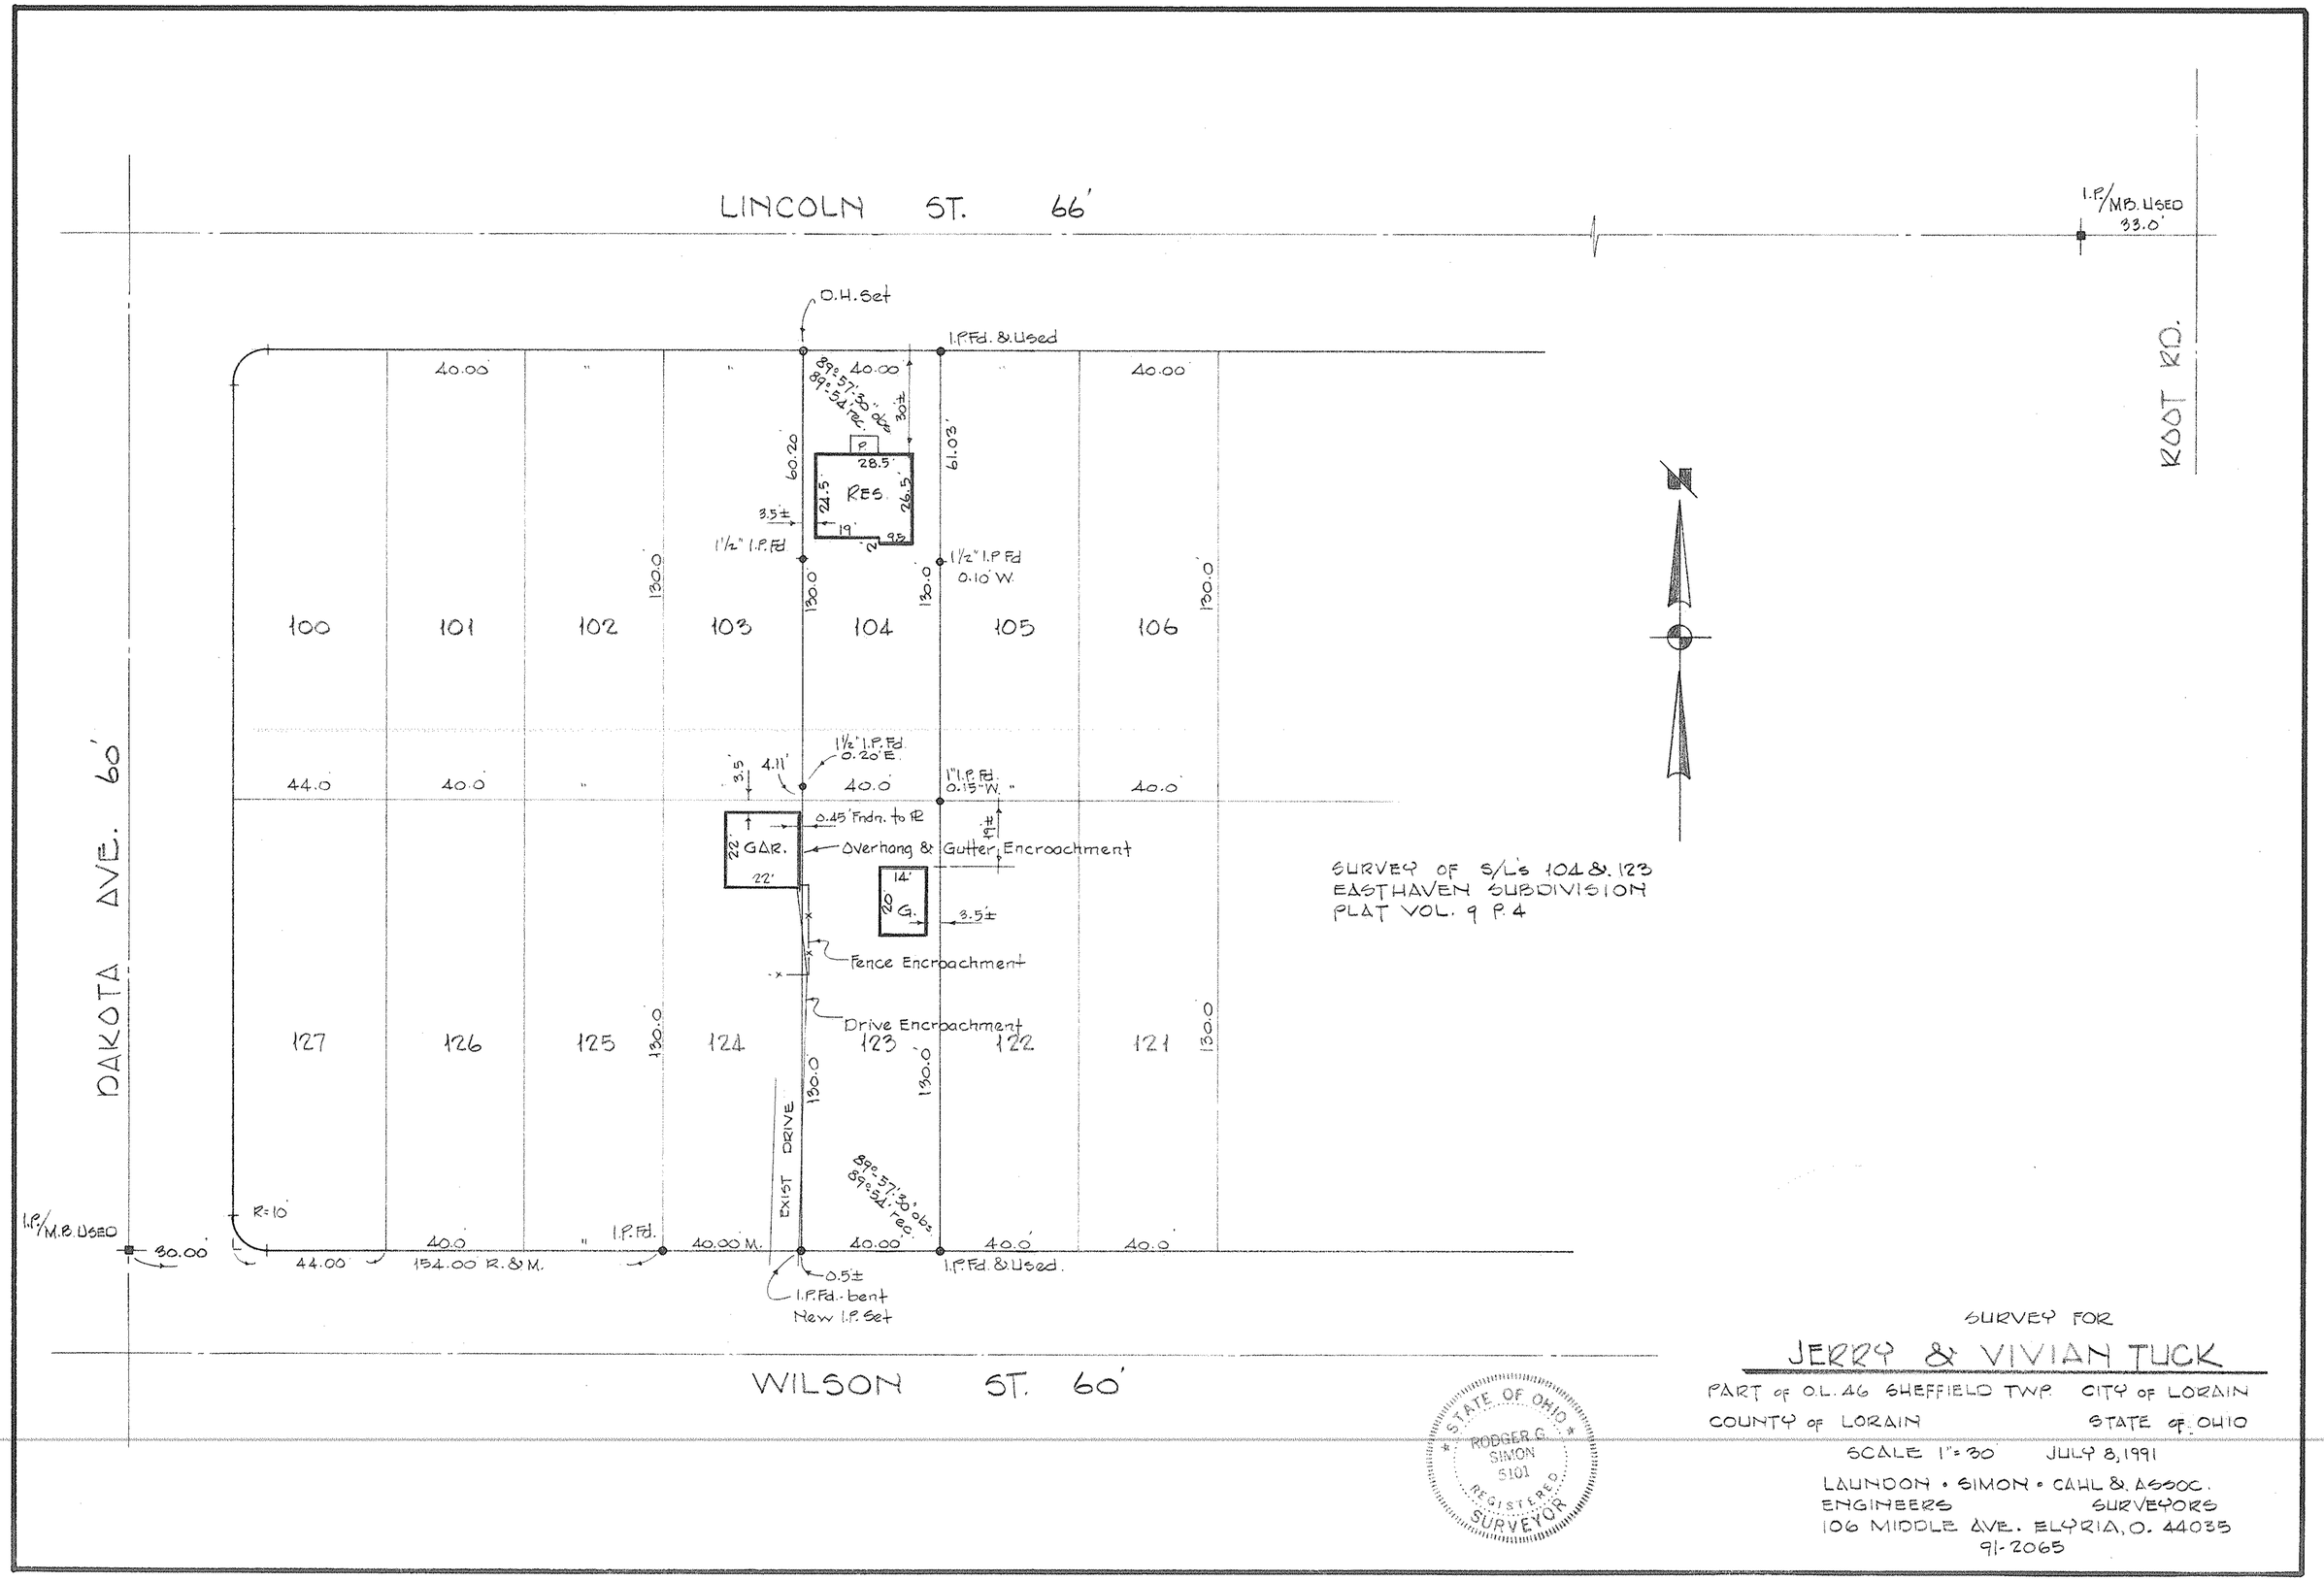

SURVEY FOR

JERRY & VIVIAN TUCK

PART OF O.L. 46 SHEFFIELD TWP. CITY OF LORAIN

COUNTY OF LORAIN STATE OF OHIO

SCALE 1" = 30 JULY 8, 1991

LAUNDON • SIMON • CAHL & ASSOC.
ENGINEERS SURVEYORS
106 MIDDLE AVE. ELYRIA, O. 44035
91-2065

259