Plat of Survey
State of Ohio
County of Lorain
Township of Eaton
Original Lot No. 75
Consolidation of
PP # 11-00-075-000-025 w/
PP # 11-00-075-000-012
in the name of
Charles E. Johnson & Grace A. Johnson
Written Title - OR Vol. 592 PG 610
0.6313 acres as surveyed

References Used

All recordings listed hereon
Ohio ROW plan sheets 134 & 135
from Project No. LOR-82-(4.79 -12.47)
PLAT VOL 17 PG 17A
Lorain County Tax Map sheet 11-00-075-B

Rafter A. LTD
Land Surveying & Engineering
10980 Lagrange Road
Elyria, OH 44035
440-309-5275

Field Survey Performed by Rafter A., LTD on Nov. 13, Nov. 20, Nov. 23, Nov. 25 in 2009 under the direct supervision of Richard A. Fredrickson, P.S.

Basis of Bearing is from control points established from on-site GPS observations on the NAD 83 datum with a 2007 adjustment

Legend

- 8" conc. mon. found - Centerline reference
- iron pin or pipe found as noted
- 5/8" rebar w/ cap stamped "Rafter A. LTD
- —x— fence line

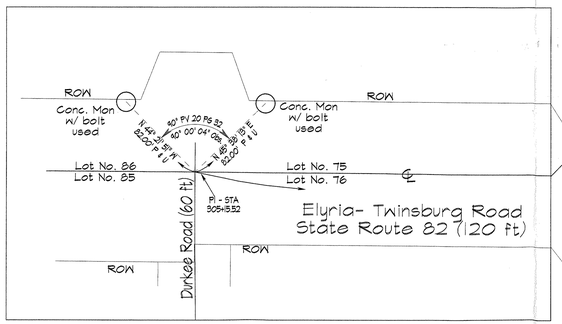

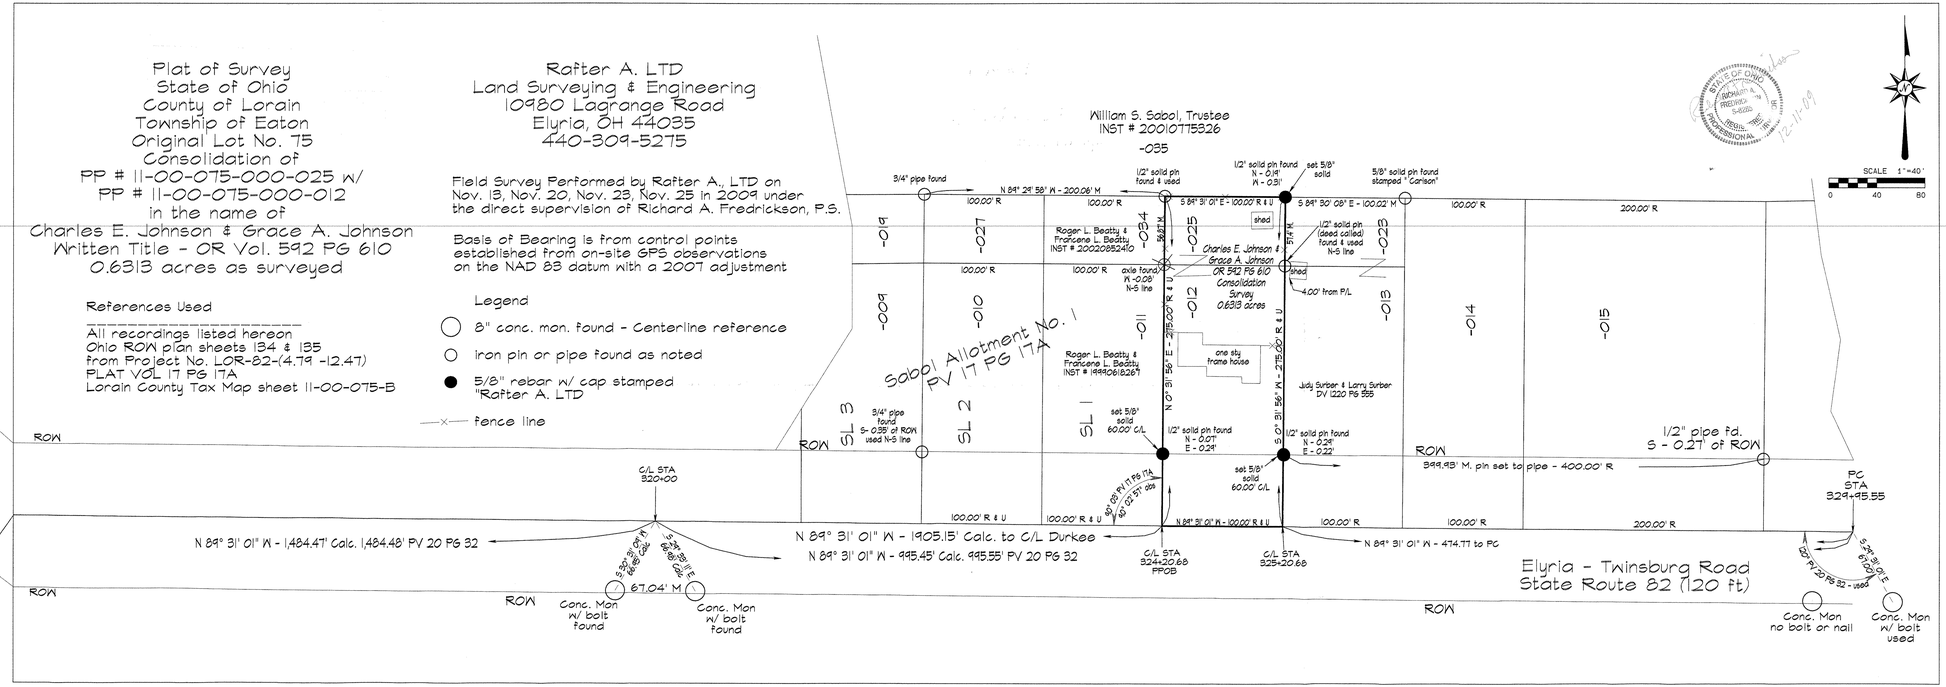

STATE OF OHIO
RICHARD A. FREDRICKSON
7600
REGISTERED
PROFESSIONAL SURVEYOR
12-11-09

APPROVED
LORAIN CO.
ENGINEER
DATE 12/23/09
DATE 11-00-0358
BY T. SULLIVAN