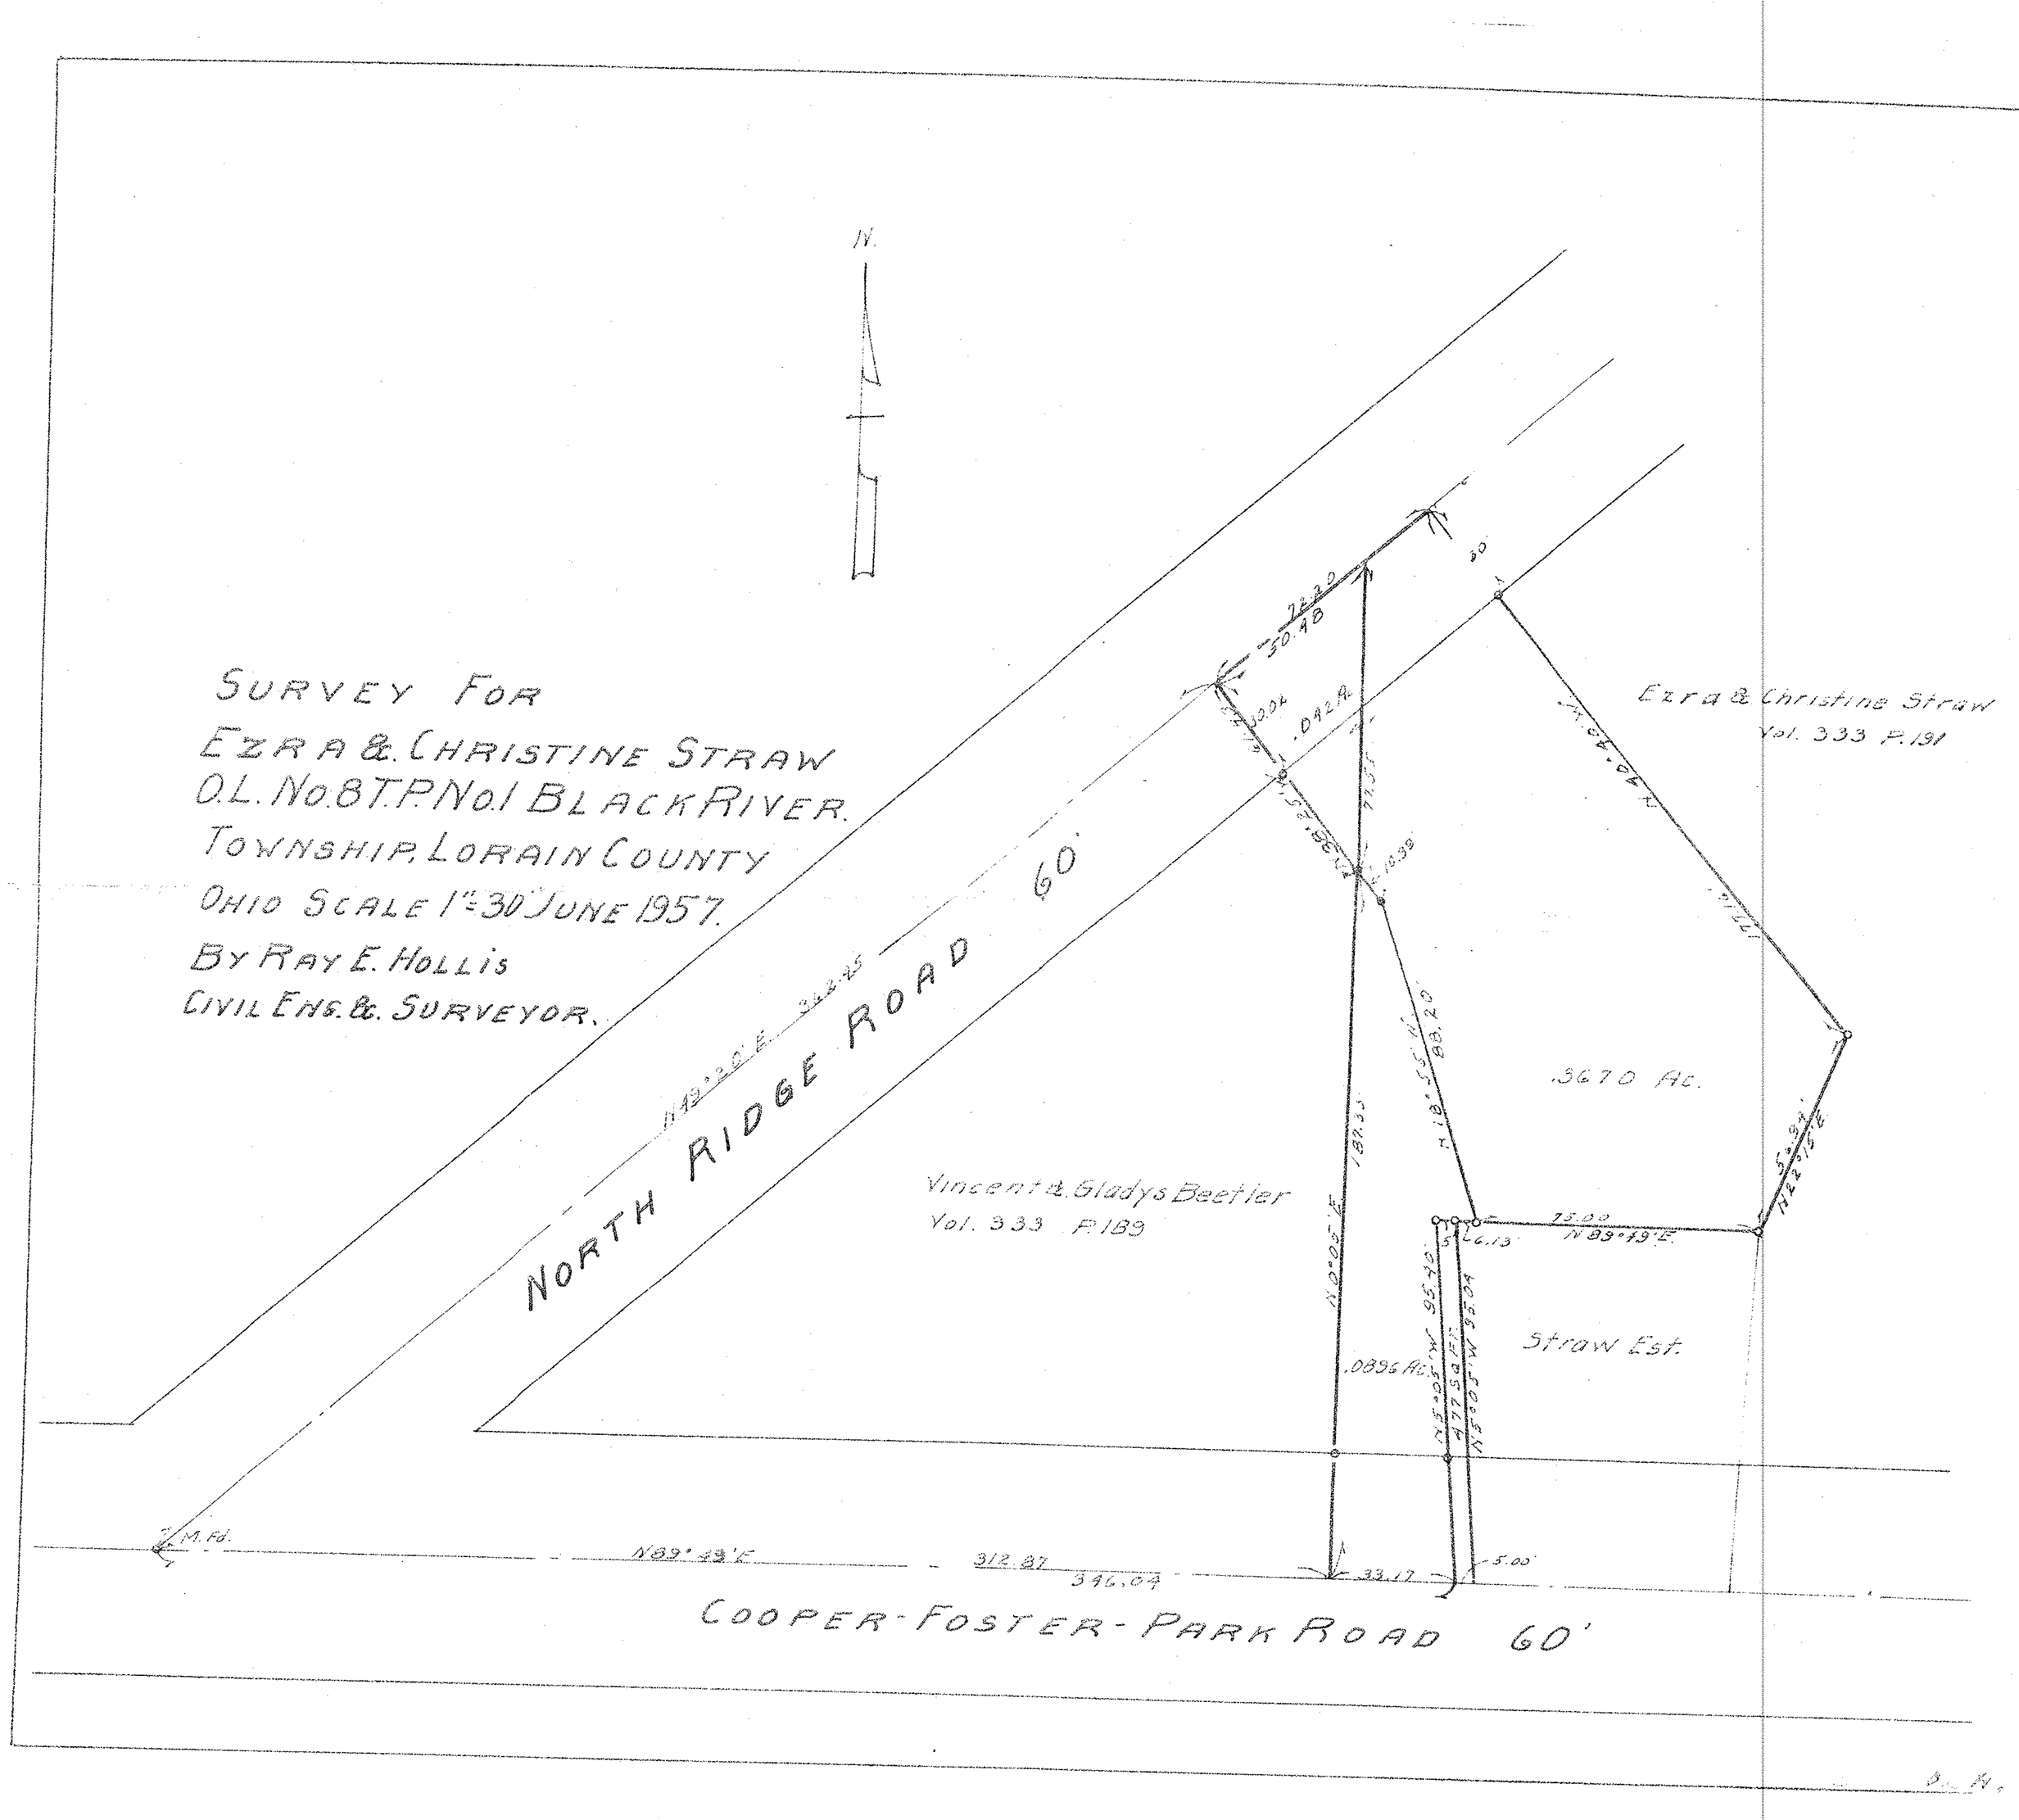SURVEY FOR
EZRA & CHRISTINE STRAW
O.L. NO. 8 T.P. NO. 1 BLACK RIVER.
TOWNSHIP, LORAIN COUNTY
OHIO SCALE 1"=30' JUNE 1957.
BY RAY E. HOLLIS
CIVIL ENG. & SURVEYOR.