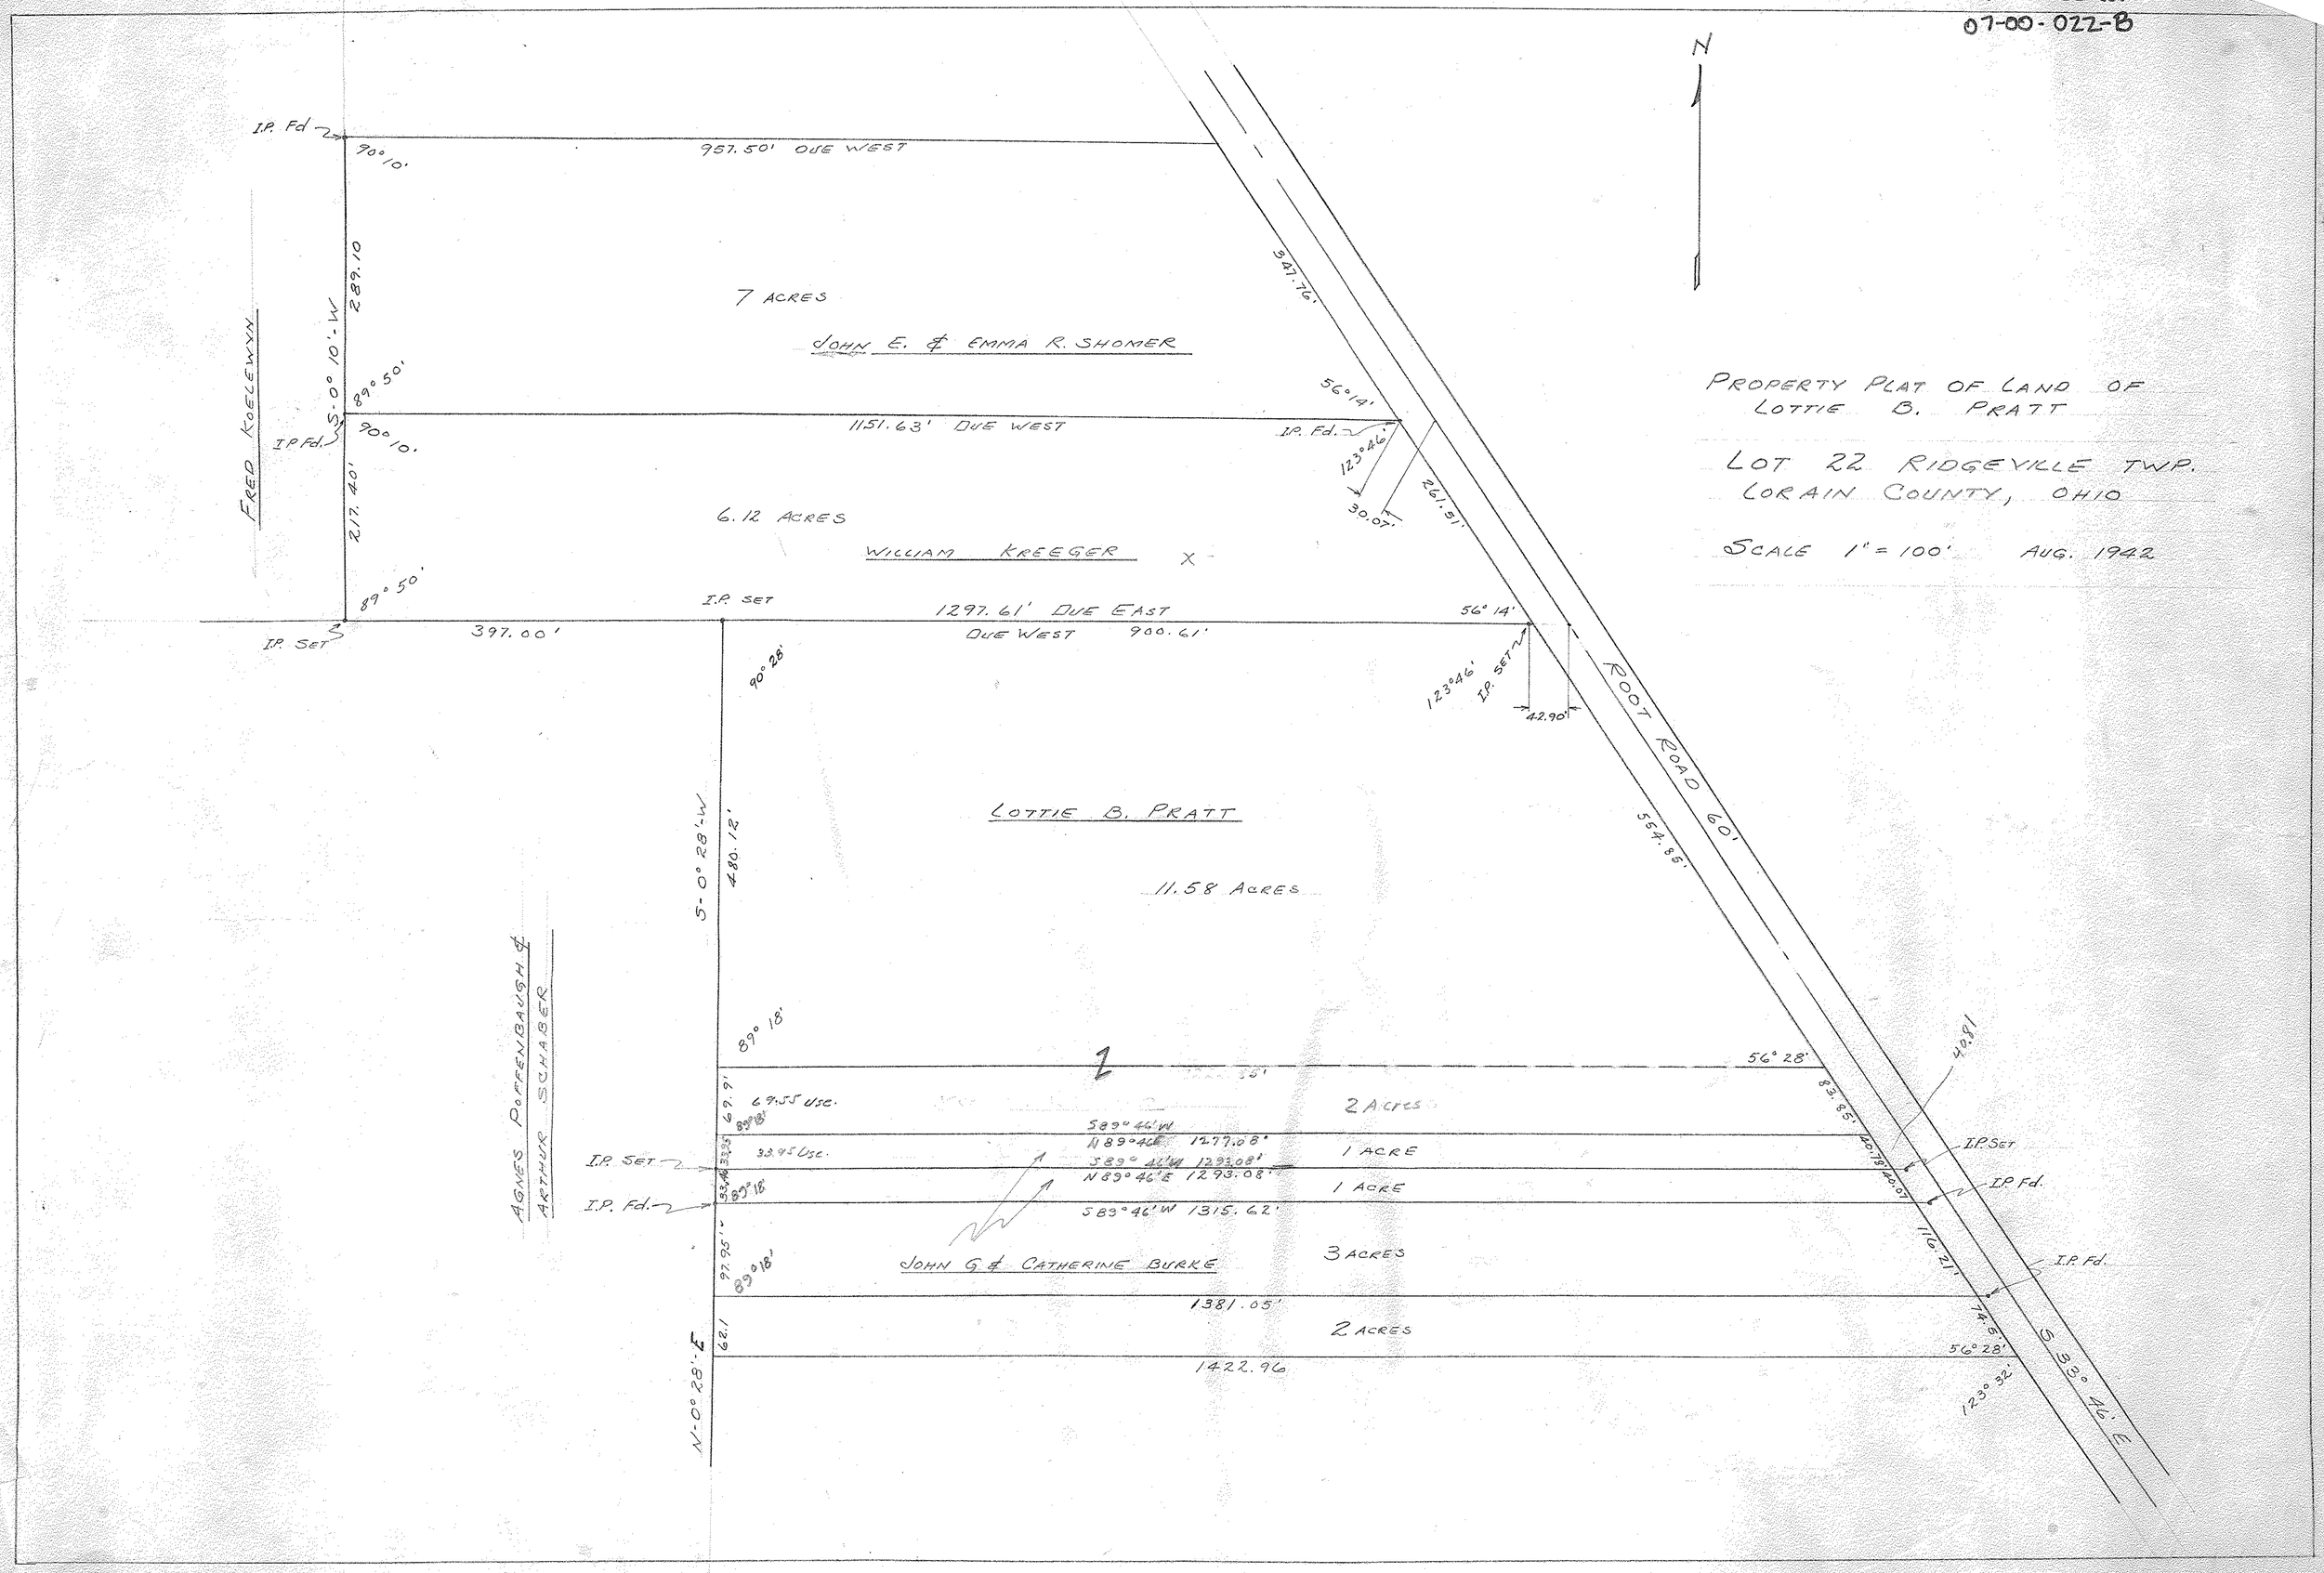07-00-022-101-???
07-00-022-B