07-00-026-101-???
07-00-026-A

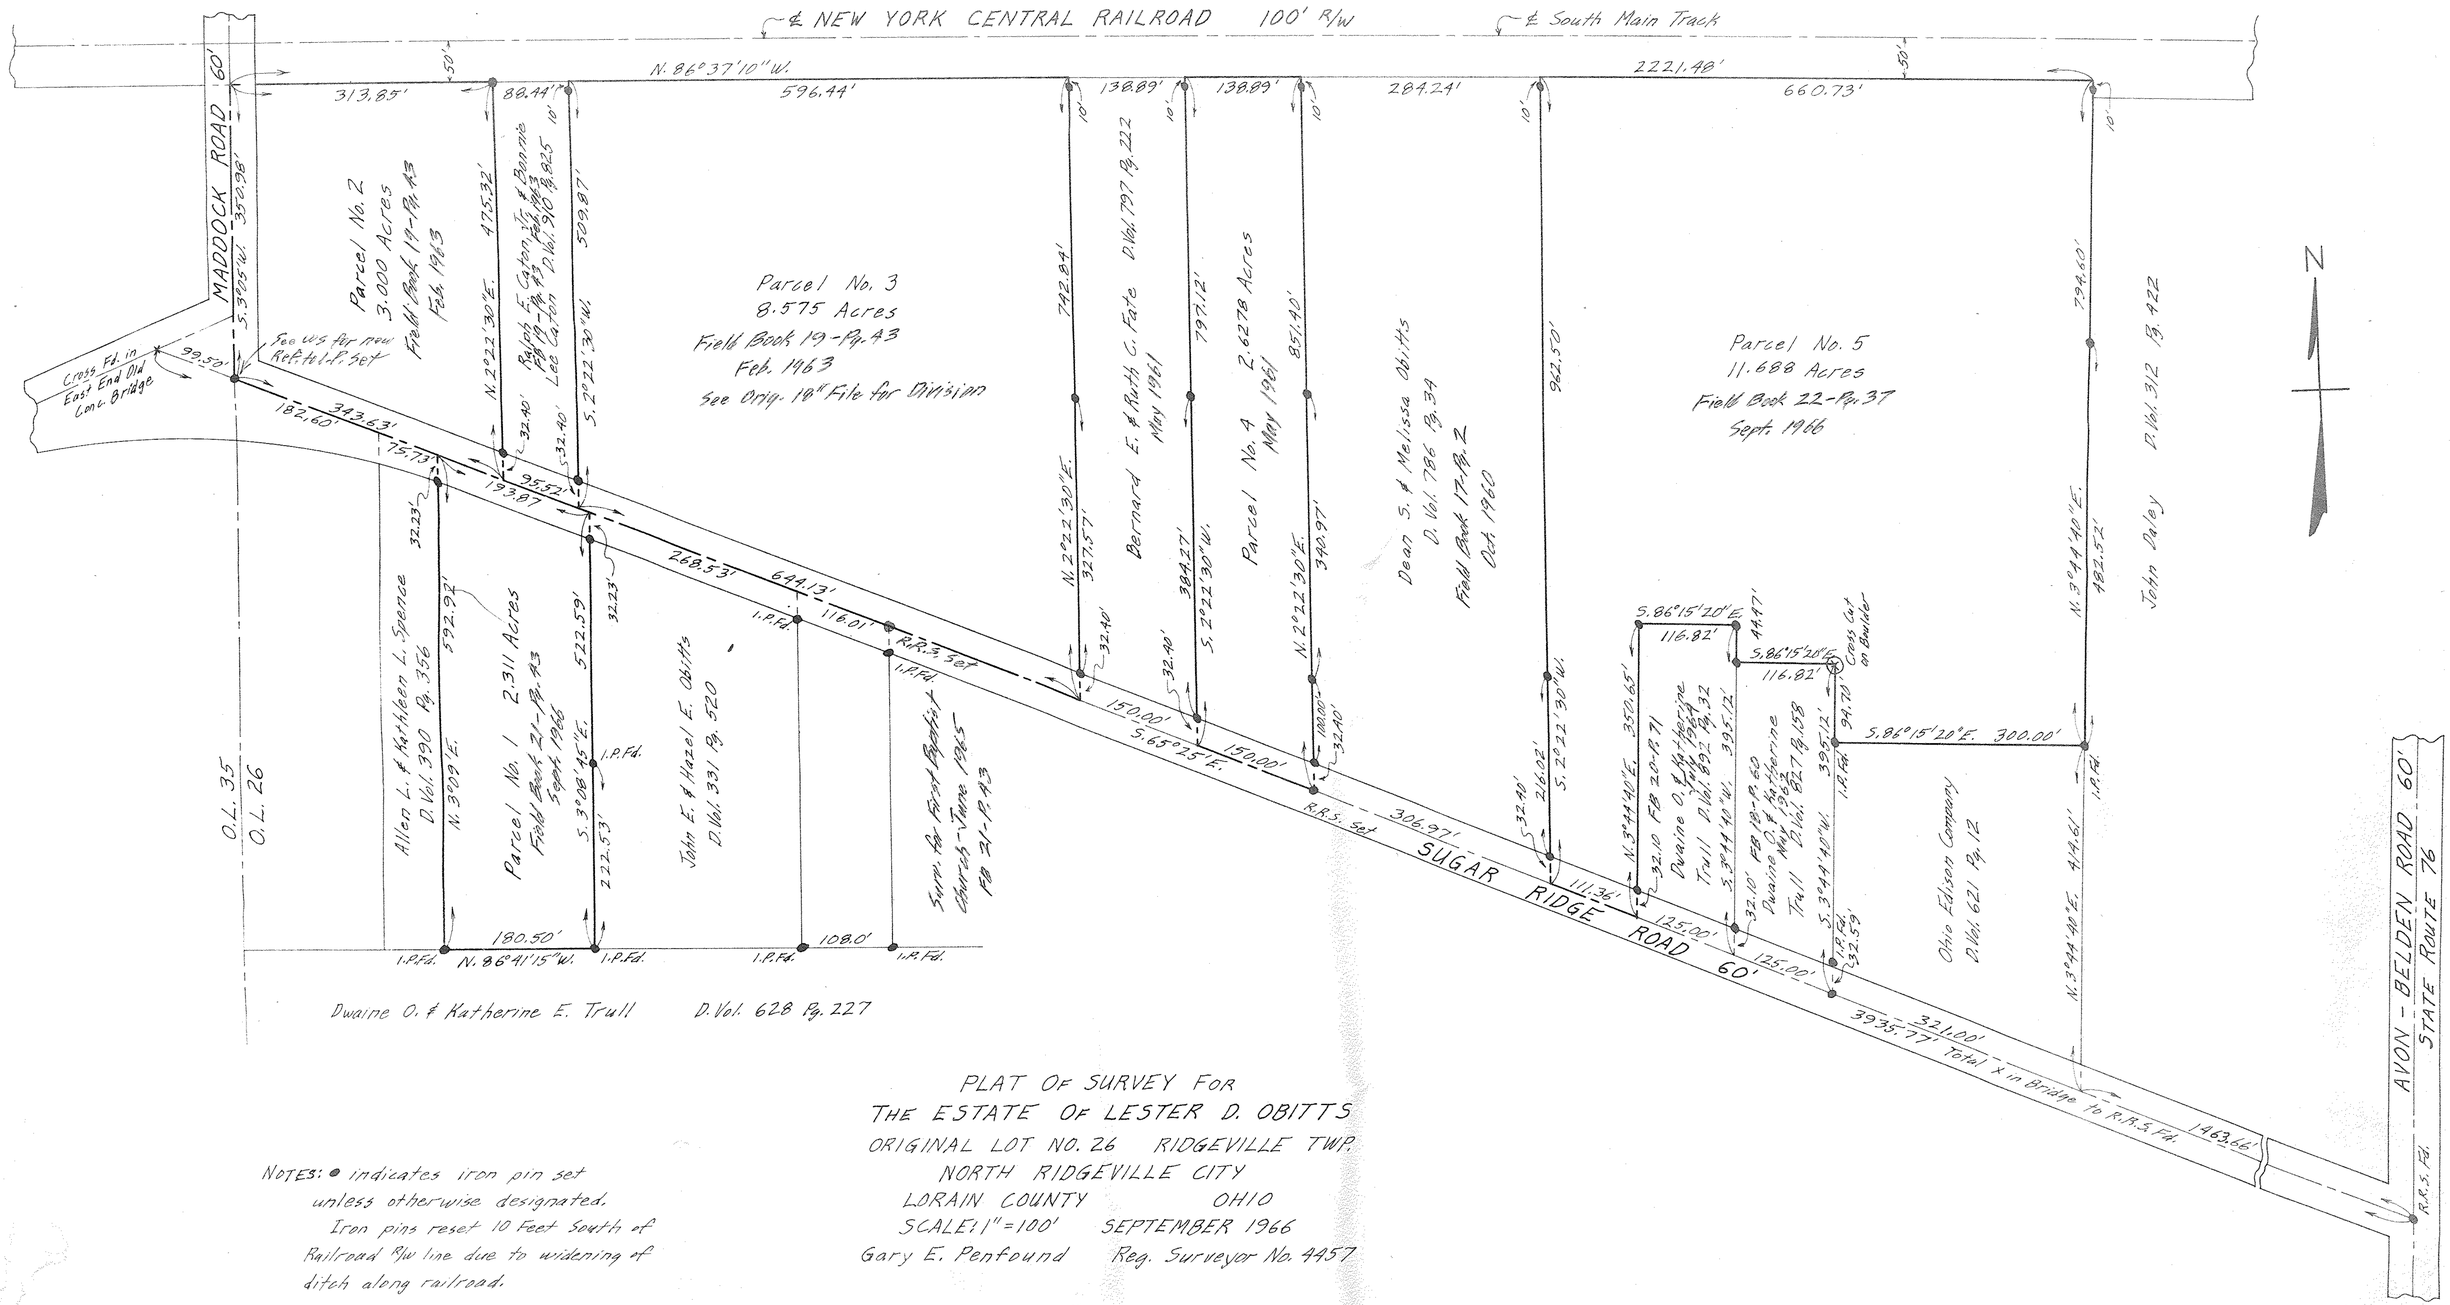

PLAT OF SURVEY FOR
THE ESTATE OF LESTER D. OBITTS
ORIGINAL LOT NO. 26 RIDGEVILLE TWP.
NORTH RIDGEVILLE CITY
LORAIN COUNTY OHIO
SCALE: 1" = 100' SEPTEMBER 1966
Gary E. Penfound Reg. Surveyor No. 4457

NOTES: ● indicates iron pin set unless otherwise designated.
Iron pins reset 10 Feet South of Railroad R/W line due to widening of ditch along railroad.