11-00-054-000-028
036
11-B 037

PLAT OF SURVEY FOR JAMES E. & JEAN V. COBB

ORIGINAL LOT 54 EATON TOWNSHIP (1)
LORAIN COUNTY OHIO
SCALE: 1" = 100' MAY - 1978
Gary E. Penfound Reg. Surveyor No. 4457
See Field Book 32 - Page 20
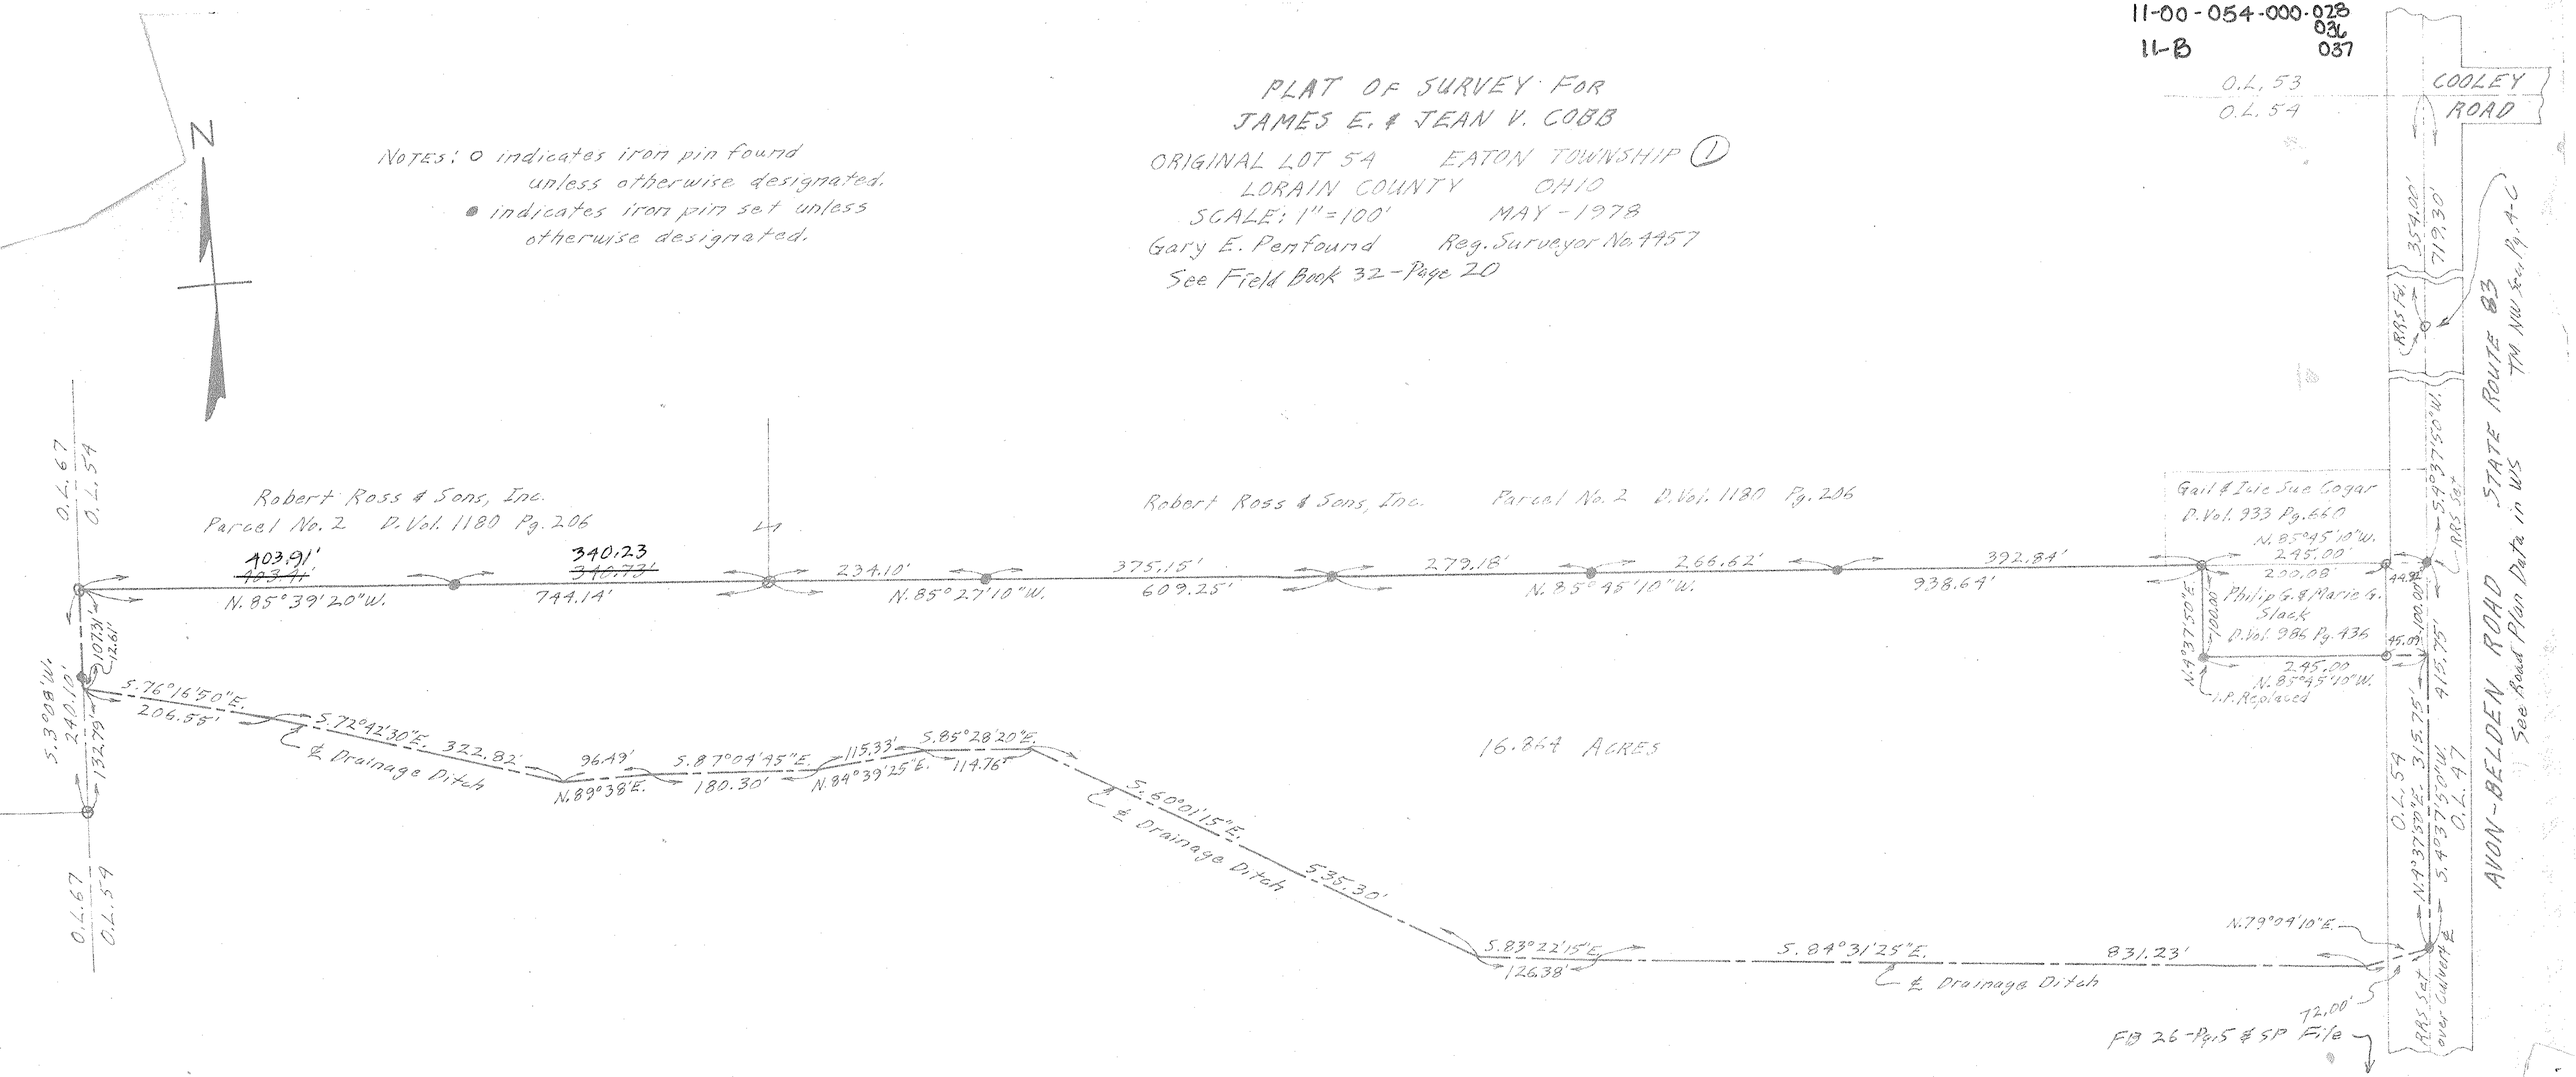
NOTES: O indicates iron pin found unless otherwise designated.
● indicates iron pin set unless otherwise designated.