P.P. NO.	
PAGE	SPLIT NO. / DATE
SURVEYOR	

4-00-002-H
04-00-002-103-041

SURVEY

OF PART OF

ORIGINAL AVON TOWNSHIP

SECTION Nº 2

CITY OF AVON COUNTY OF LORAIN

STATE OF OHIO

PREPARED BY:

HAPONEK AND ASSOCIATES INC.
54100 CENTER RIDGE RD
N RIDGEVILLE, O

STATE OF OHIO
DANE A. HAPONEK
5421
REGISTERED
SURVEYOR

PREPARED FOR:

ALLEN GREENHOUSE
3500 LORAIN RD
AVON, OHIO

SCALE: 1" = 100'
DATE: MARCH, 1988

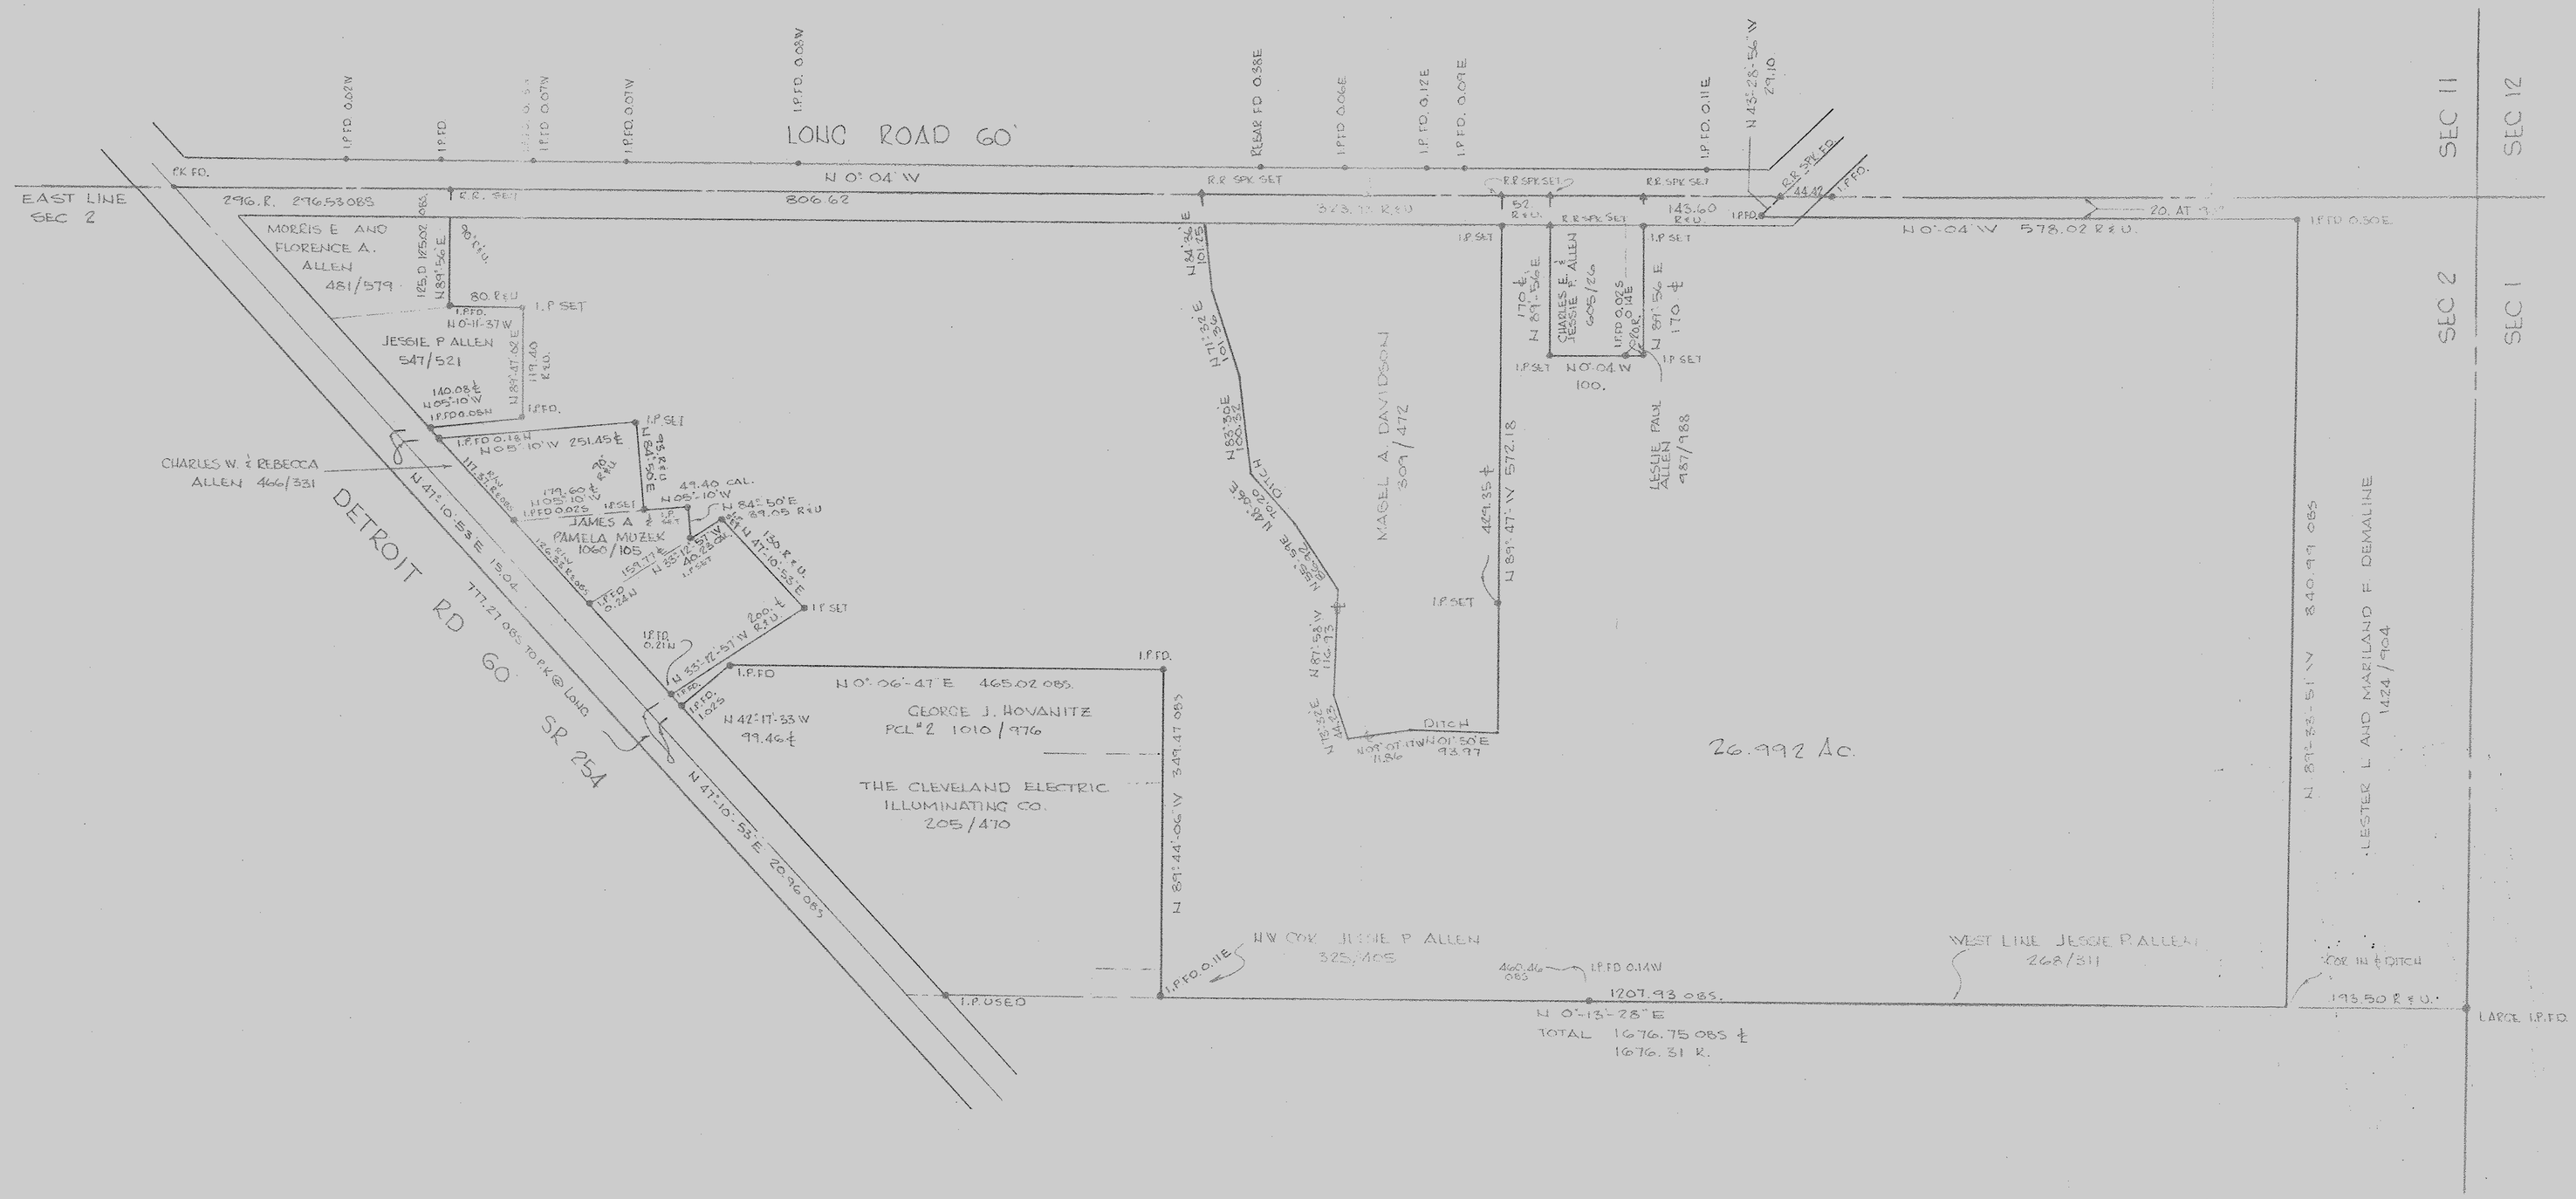

1 of 3
MAP Room