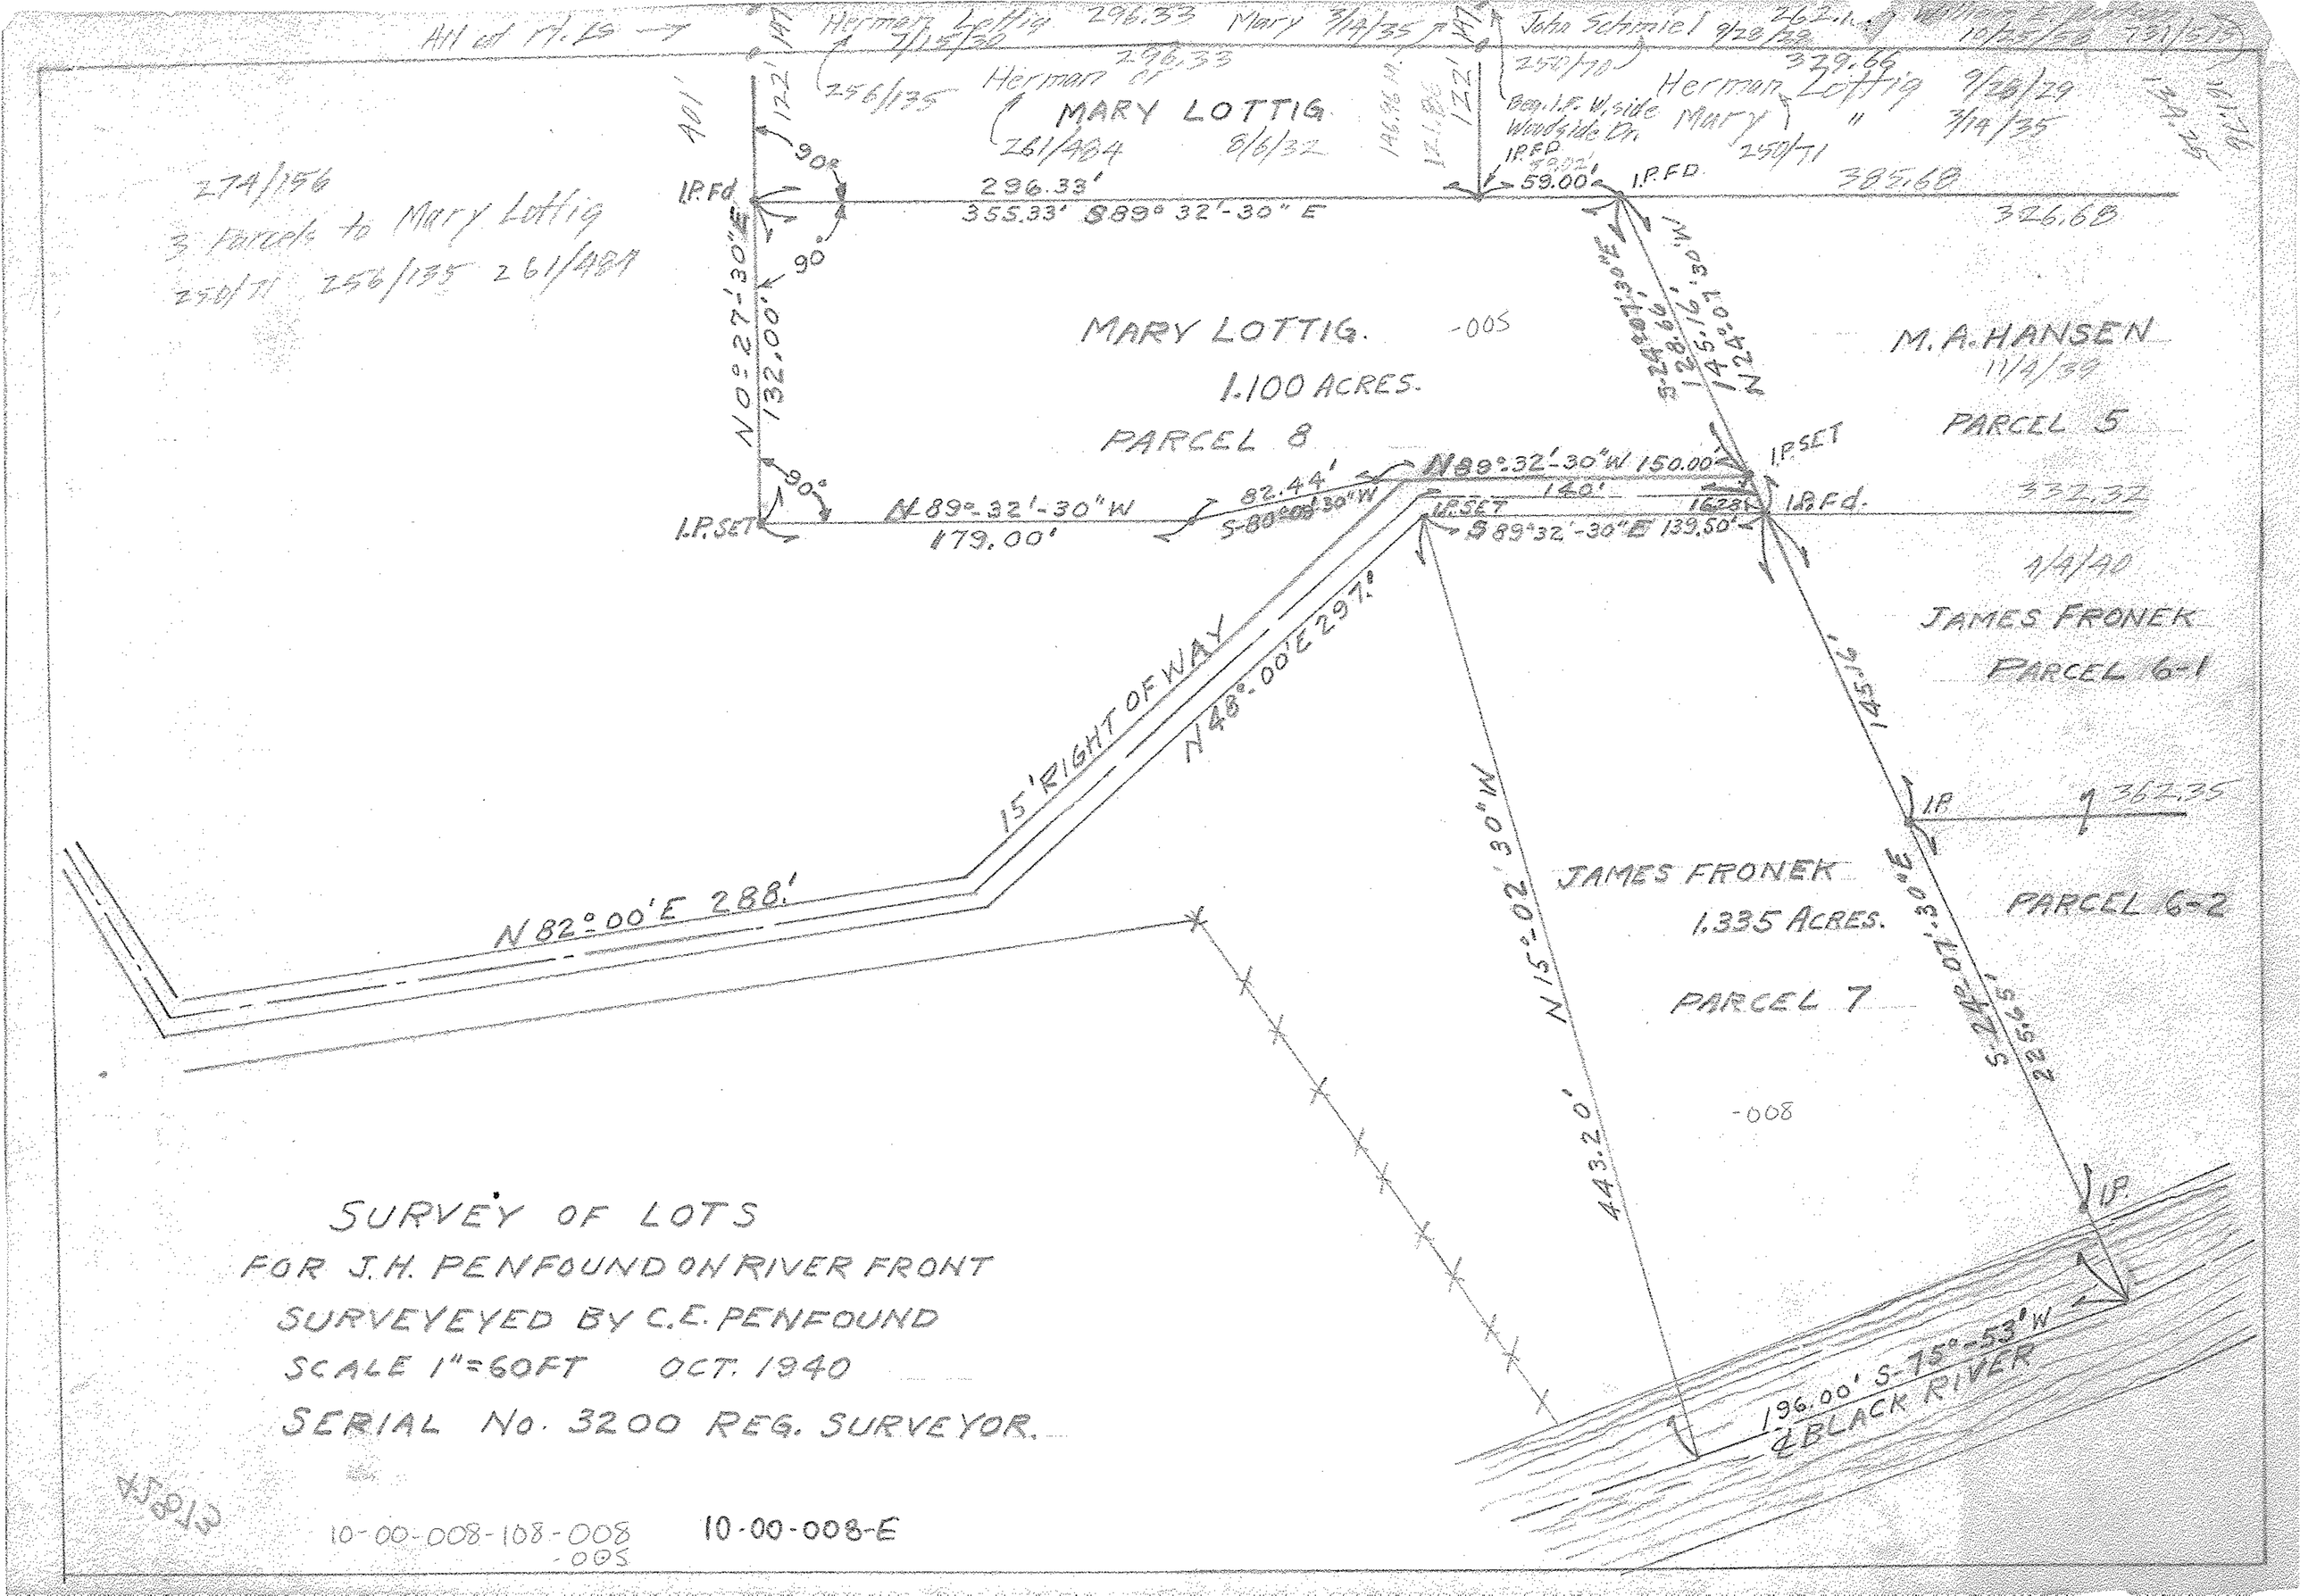

All of Pt. 15 →
Herman Lottig 7/15/30 296.33
Mary 3/14/35
John Schmiel 9/28/29
Herman Lottig 9/28/29
Mary 3/14/35
256/135
Herman Lottig
MARY LOTTIG
261/484 8/6/32
Beg. I.P. W. side Woodside Dr.
250/70
329.66
250/71
274/156
3 Parcels to Mary Lottig
250/71 256/135 261/484
I.P. Fd
296.33'
355.33' S89° 32'-30" E
59.00'
I.P. FD
385.68
326.68
N0°27'-30"E
132.00'
MARY LOTTIG.
-005
1.100 ACRES.
PARCEL 8
M. A. HANSEN
11/4/39
PARCEL 5
N89°-32'-30"W 150.00'
140'
82.44'
S-80°-08'-30"W
N89°-32'-30"W
179.00'
I.P. SET
S89°32'-30"E 139.50'
I.P. Fd.
332.32
4/4/40
JAMES FRONEK
PARCEL 6-1
15' RIGHT OF WAY
N48°-00'E 297.'
N82°-00'E 288.'
145.16'
362.35
JAMES FRONEK
1.335 ACRES.
PARCEL 7
PARCEL 6-2
N15°-02'-30"W
443.20'
S-24°-07'-30"E
225.65'
-008
196.00' S-75°-53'W
℄ BLACK RIVER
SURVEY OF LOTS
FOR J.H. PENFOUND ON RIVER FRONT
SURVEYEYED BY C.E. PENFOUND
SCALE 1"=60FT OCT. 1940
SERIAL No. 3200 REG. SURVEYOR.
10-00-008-108-008
-005
10-00-008-E