04-00-026-103-???
04-00-026-A

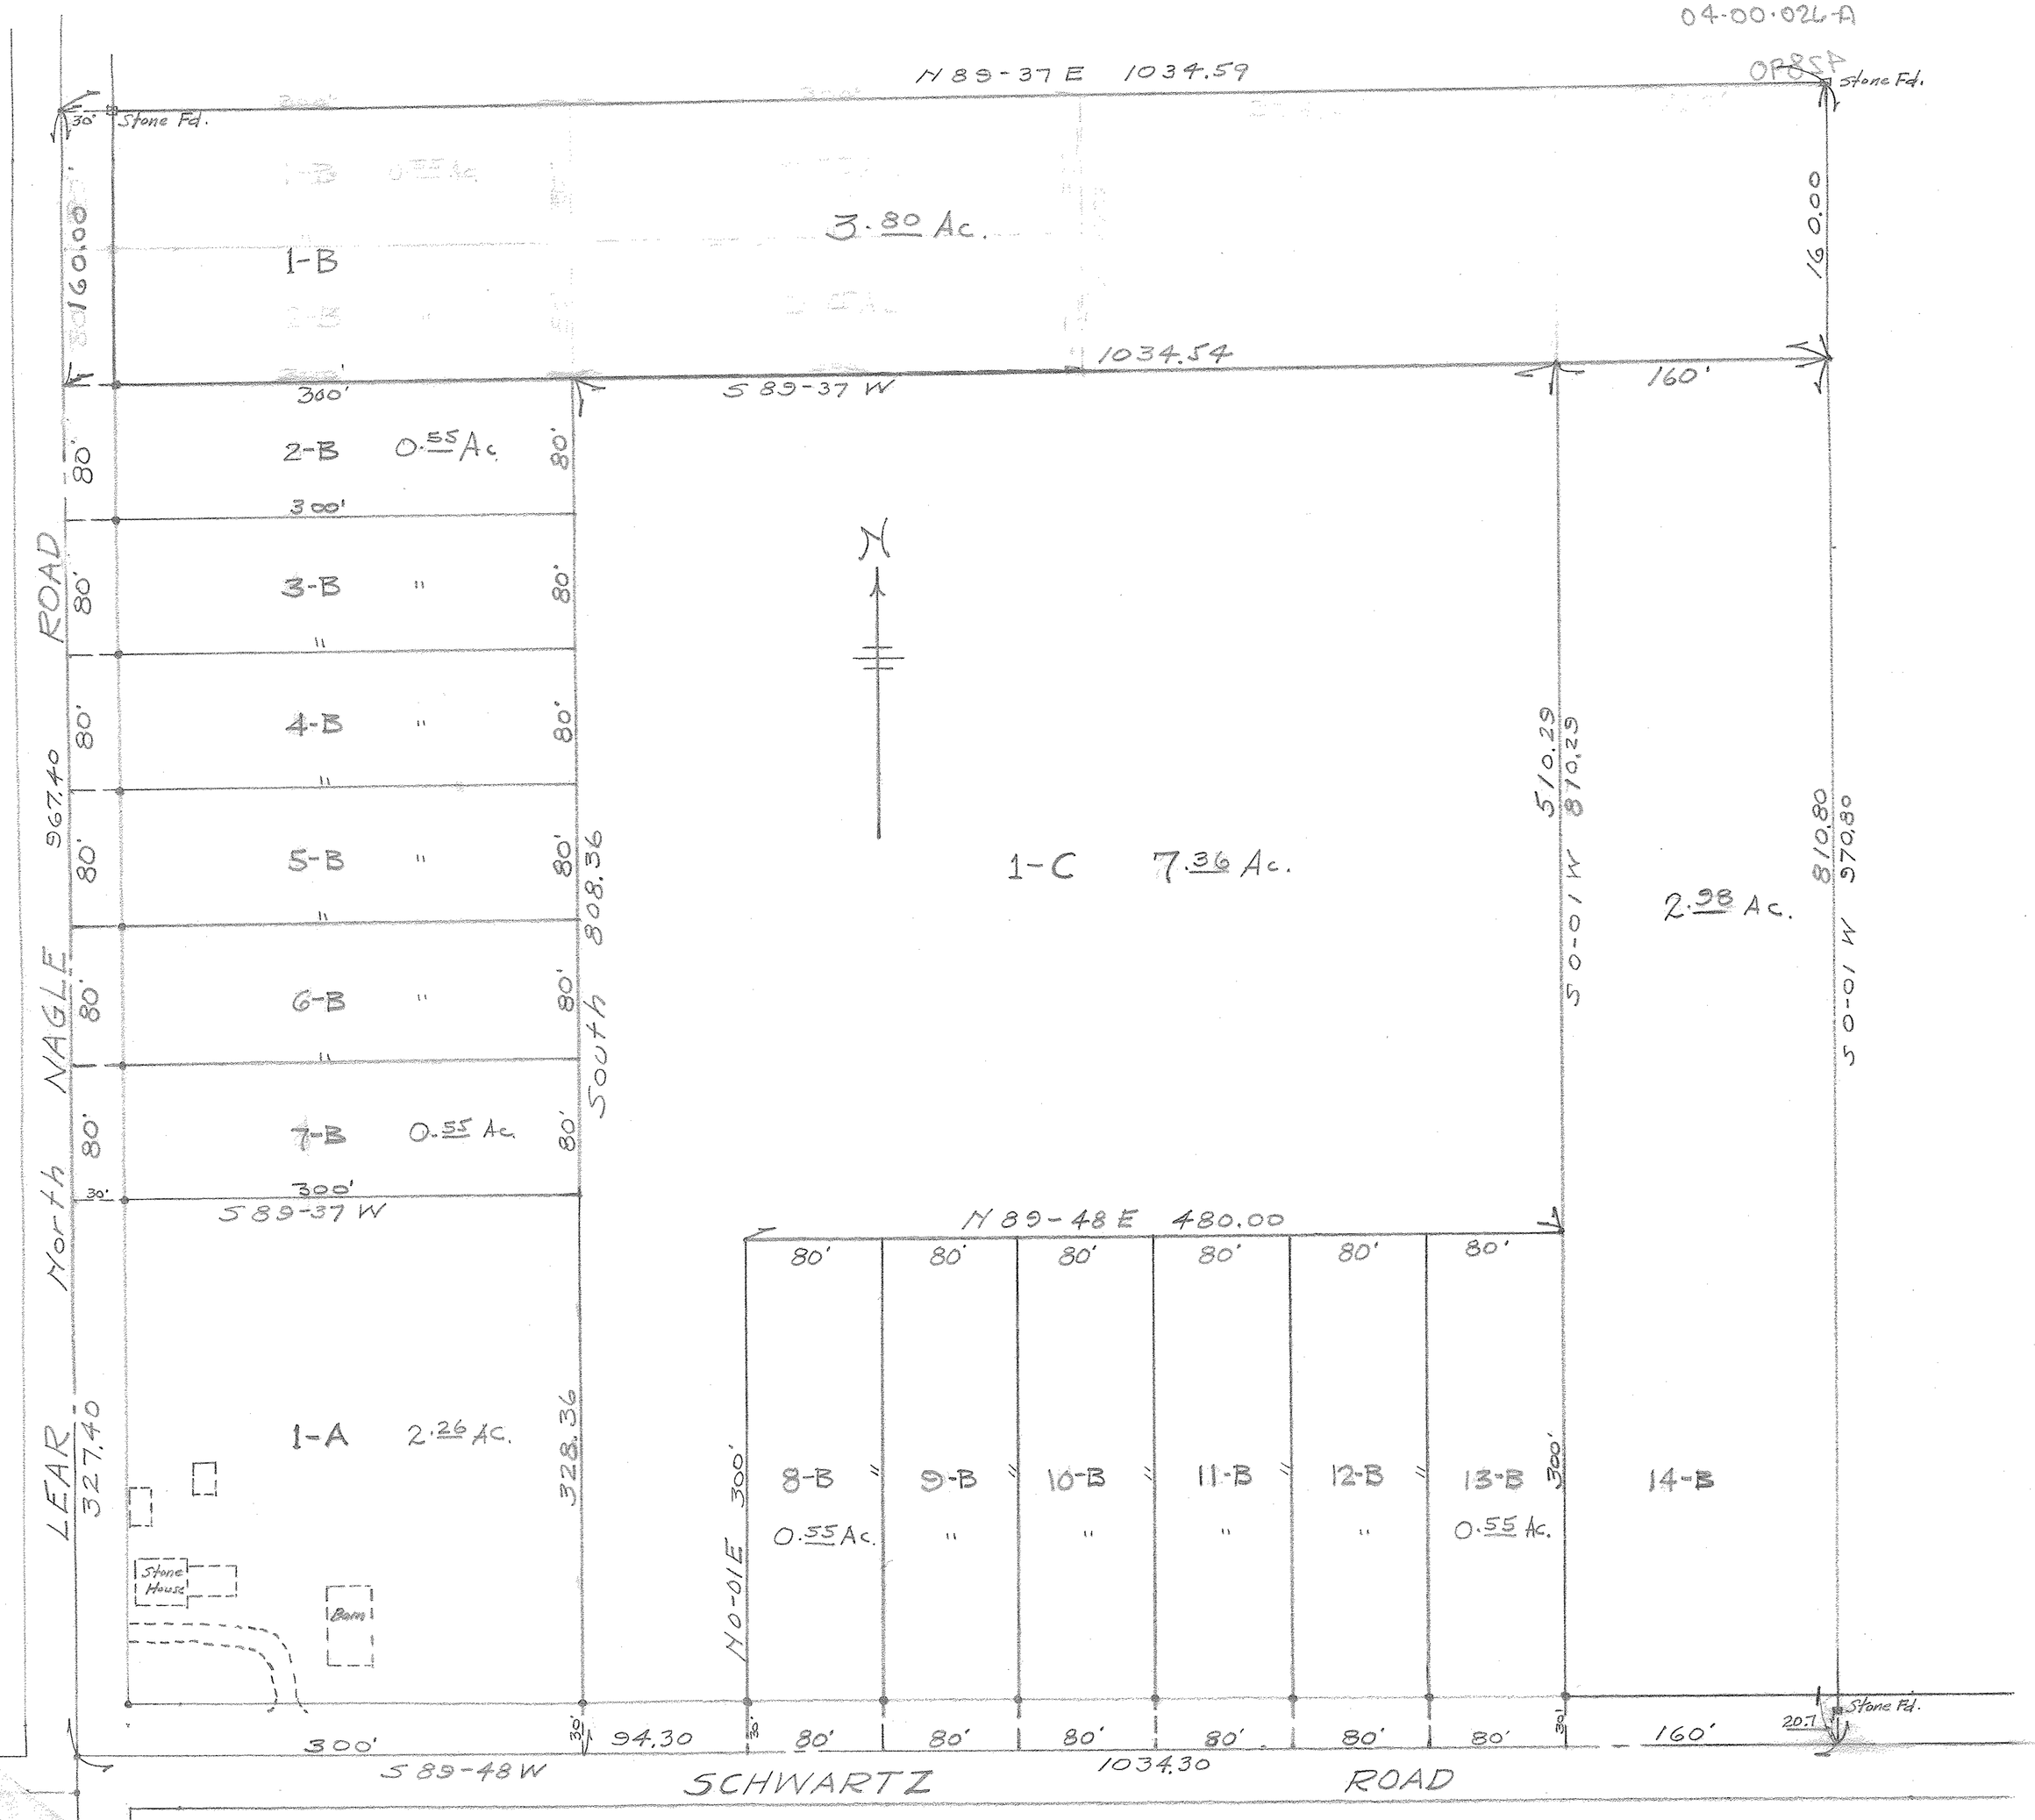

SURVEY FOR T. L. SAMPLE
Of The Joe Nagle Farm
In Original Avon Township
Section No. 26
Now In The Village Of Avon
Lorain County Ohio
Scale:- 1" = 60' May 29, 1950
J. H. Getz, Reg. Engr. & Surveyor

Void