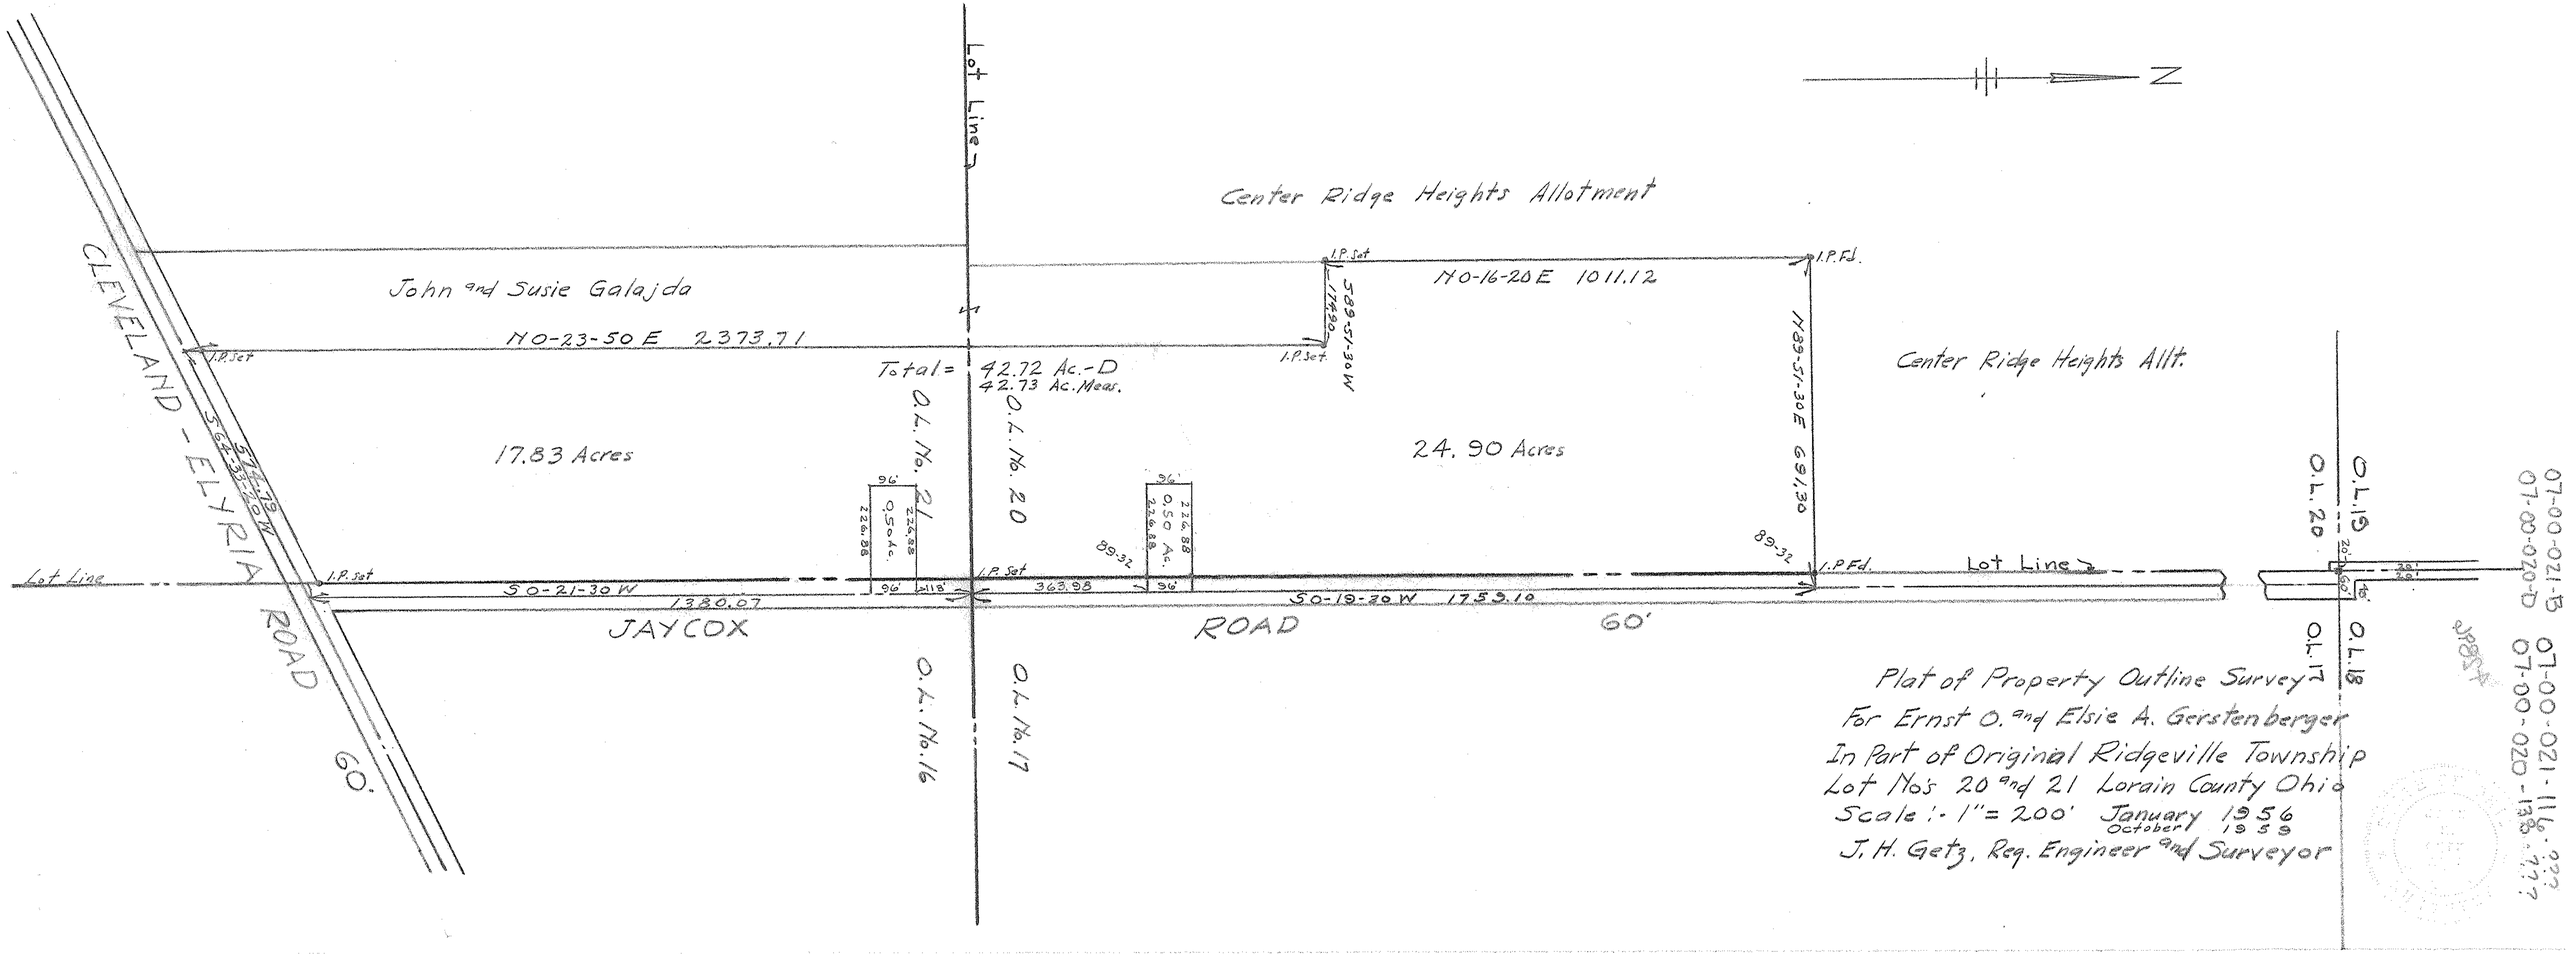

Plat of Property Outline Survey
For Ernst O. and Elsie A. Gerstenberger
In Part of Original Ridgeville Township
Lot Nos 20 and 21 Lorain County Ohio
Scale :- 1" = 200' January 1956
October 1958
J. H. Getz, Reg. Engineer and Surveyor