

BOUNDARY SURVEY

SITUATED IN THE TOWNSHIP OF LAGRANGE
COUNTY OF LORAIN, STATE OF OHIO
PART OF ORIGINAL LAGRANGE TOWNSHIP LOT 99
LOT 254 & NORTHWEST 20' of LOT 253 PHEASANT RUN VILLAGE PHASE I
RECORDED 8-15-1972 IN PLAT VOLUME 27 PAGES 16-19

ADDRESS
254 EAST LAKE DRIVE
LAGRANGE, OHIO

RECORD
PARCEL NO. 15-00-099-106-017
PAUL J. HORTEN
DEED NO. 1998-0565222
FILED 9-25-1998

LEGEND
○ 1/2" IRON REBAR FOUND (NO CAP ID)
● 5/8", 30" LONG REBAR SET WITH ID CAP "HAYWOOD 8284"
POB PLACE OF BEGINNING
(R) RECORD (P) PLAT
(D) DEED (M) MEASURED


NOTES
OCCUPATION IS CONSISTENT WITH TITLE LINES
DOCUMENTS USED ARE CITED ON THE PLAT
THE INTENT OF THIS SURVEY IS TO UPDATE THE
DESCRIPTION OF AN EXISTING PARCEL

I CERTIFY THAT THIS PLAT OF SURVEY WAS PREPARED IN
ACCORDANCE WITH OHIO ADMINISTRATIVE CODE CHAPTER
4733-37 STANDARDS FOR BOUNDARY SURVEYS. ALL
MONUMENTATION IS OR TO BE SET AS SHOWN.



DATE
FIELD: AUGUST 27, 2009
DRAWING: AUGUST 28, 2009

Dale Haywood
DALE HAYWOOD, P.S.
OHIO REG. 5-8284

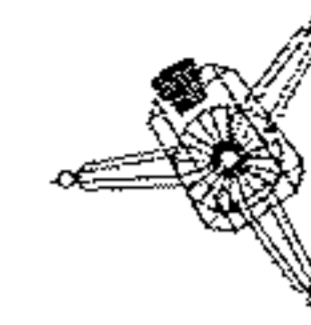

EXACTA OHIO
LAND SURVEYING
2132 E. 9TH STREET, SUITE 203
CLEVELAND, OHIO 44115
(216) 751-9000

