08-05-005-000-???
8-B

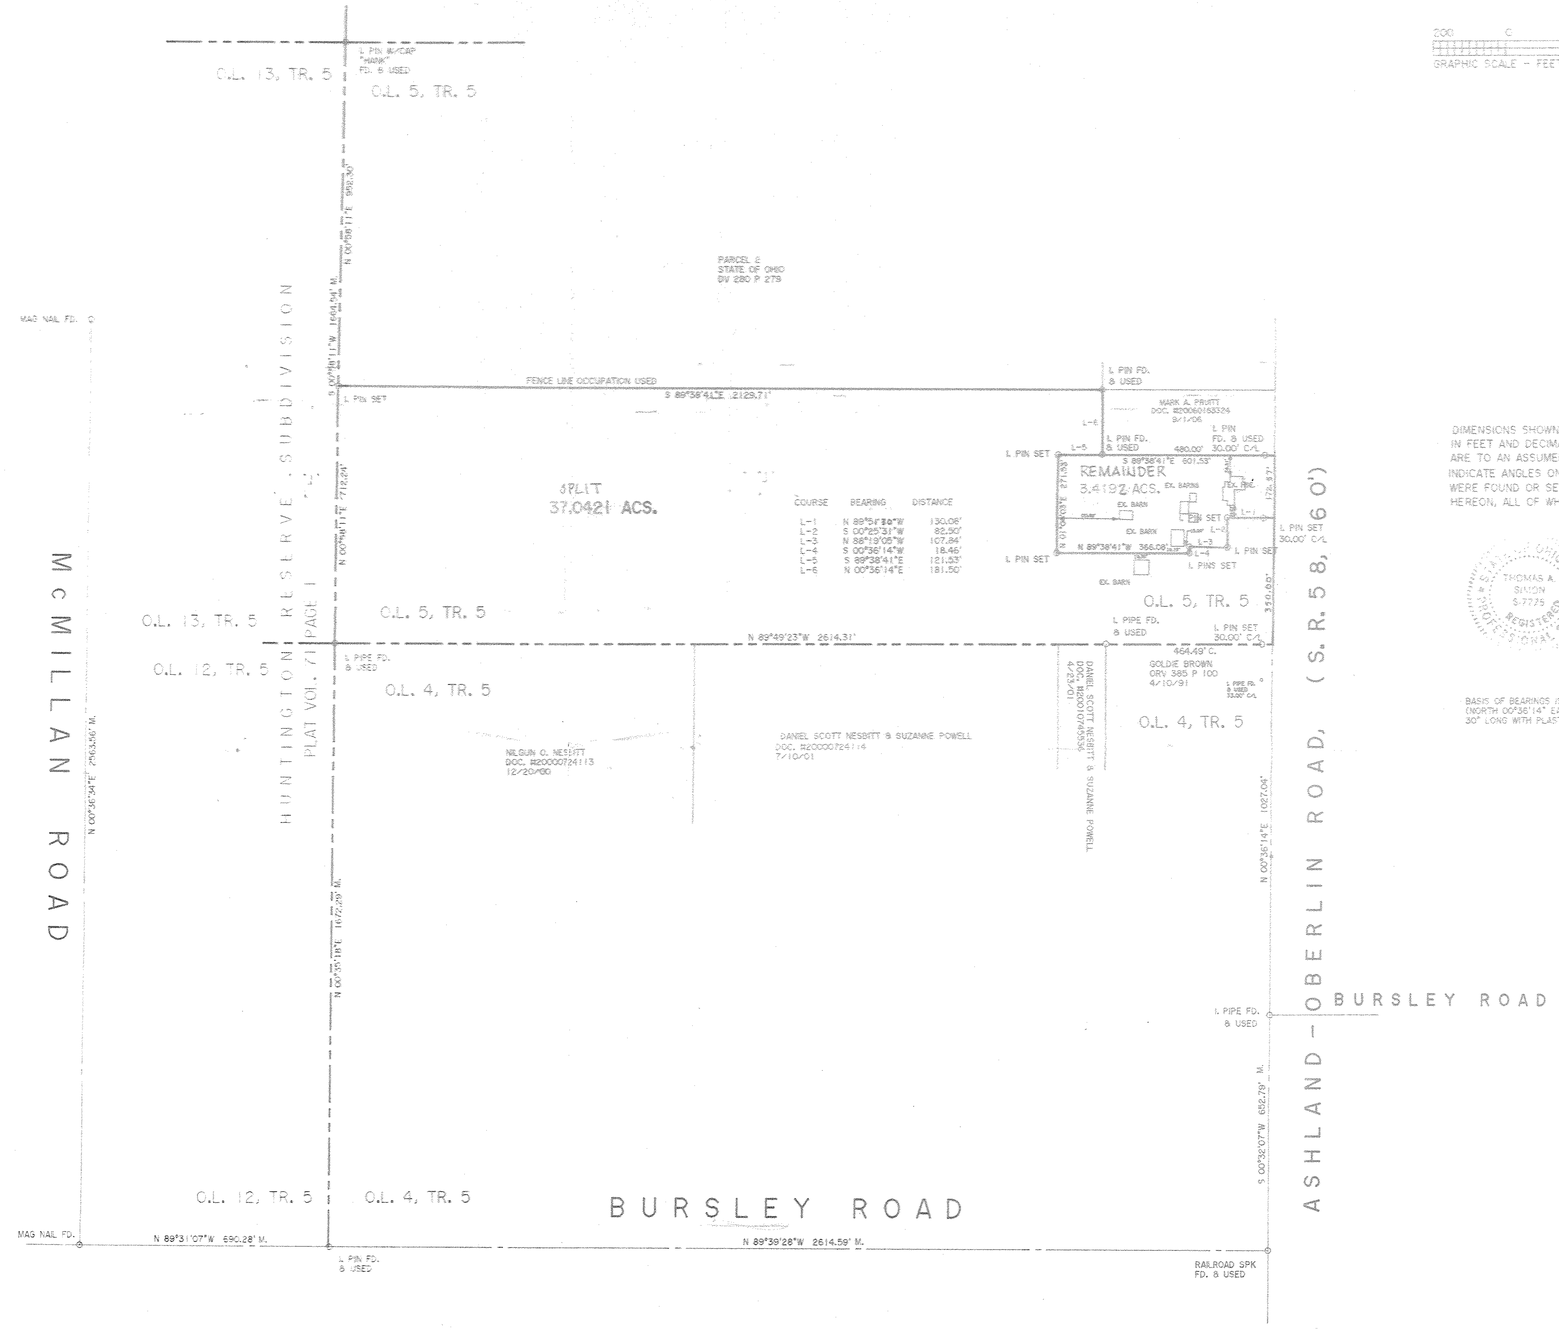

DIMENSIONS SHOWN ON THIS PLAT ARE EXPRESSED IN FEET AND DECIMAL PARTS THEREOF, ALL BEARINGS ARE TO AN ASSUMED MERIDIAN AND ARE USED TO INDICATE ANGLES ONLY. PERMANENT MONUMENTS WERE FOUND OR SET AT ALL POINTS INDICATED HEREON, ALL OF WHICH I CERTIFY TO BE CORRECT.

THOMAS A. SIMON
S-7775
REGISTERED
PROFESSIONAL SURVEYOR

THOMAS A. SIMON
REG. PROFESSIONAL SURVEYOR
NO. S-7775

BASIS OF BEARINGS IS THE CENTERLINE OF STATE ROUTE 58 (NORTH 00°36'14" EAST). IRON PINS SET ARE 5/8" DIAMETER, 30" LONG WITH PLASTIC CAPS " T. SIMON, S-7775".

THOMAS SIMON & ASSOCIATES, INC.
PROFESSIONAL LAND SURVEYORS
150 SOUTH OLIVE STREET
ELYRIA, OHIO 44035
(440) 327-2925
FAX 327-2964

PLAT OF SURVEY AND SPLIT
FOR
PRUITT FAMILY TRUST
RUSSELL PRUITT, SR., TRUSTEE

BEING KNOWN AS PART OF ORIGINAL HUNTINGTON TOWNSHIP
LOT NO. 5, TRACT 5

COUNTY OF LORAIN STATE OF OHIO
APRIL, 2009 SCALE: 1" = 200'

REV. 4/2009
REV. 7/2008

CRD FILE 2002-064
JOB NO. 2007-038