


Raymond & Katherine Flock

2892A

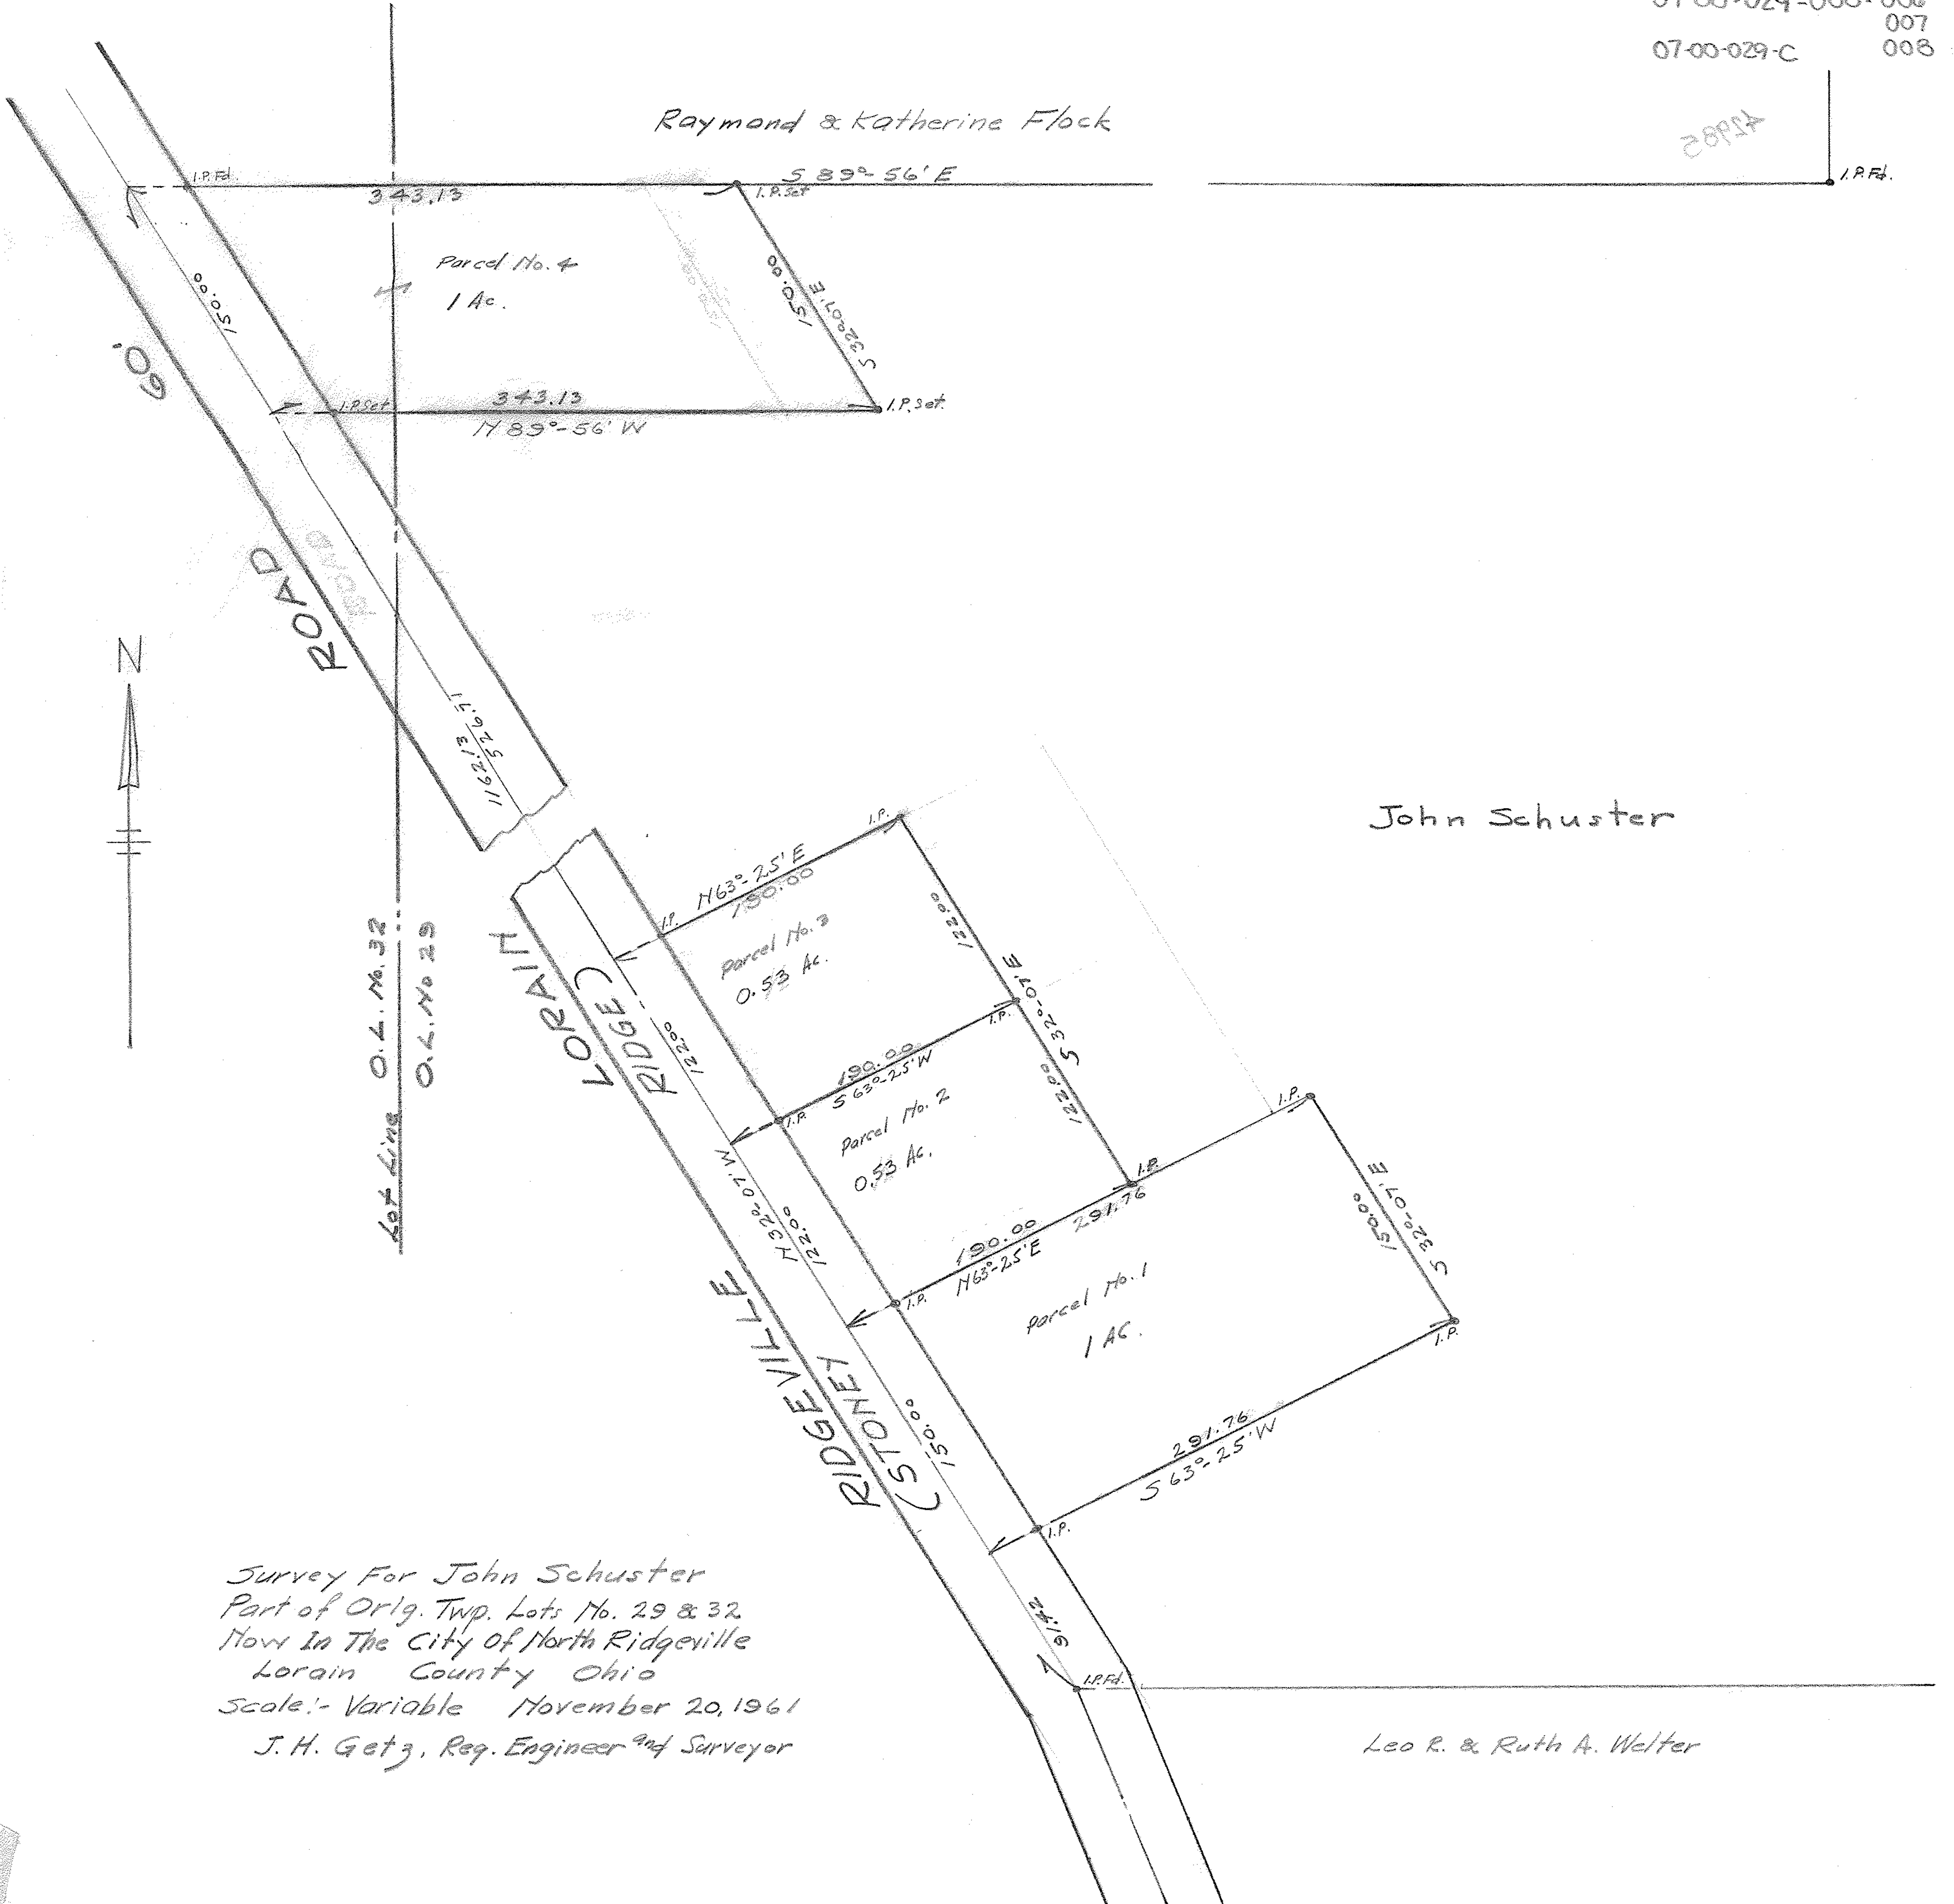

John Schuster

Survey For John Schuster
 Part of Orig. Twp. Lots No. 29 & 32
 Now in The City of North Ridgville
 Lorain County Ohio
 Scale:- Variable November 20, 1961
 J. H. Getz, Reg. Engineer and Surveyor

Leo R. & Ruth A. Welter