Survey Of Walter J. Herbert Property
At The Request Of Miss Guelah Martin
In Part Of Original Avon Township Section No. 11
Now In The City Of Avon, And Also Sublots No.
6, 7, 8, 9 and Part Of 10 In Benham's First
Addition To Town Plat Of French Creek
As Recorded In Volume 3 Page 9 Of Lorain County
Record Plats, Lorain County, Ohio
Scale:- 1"=50' August 10, 1962
J. H. Getz, Reg. Engineer and Surveyor

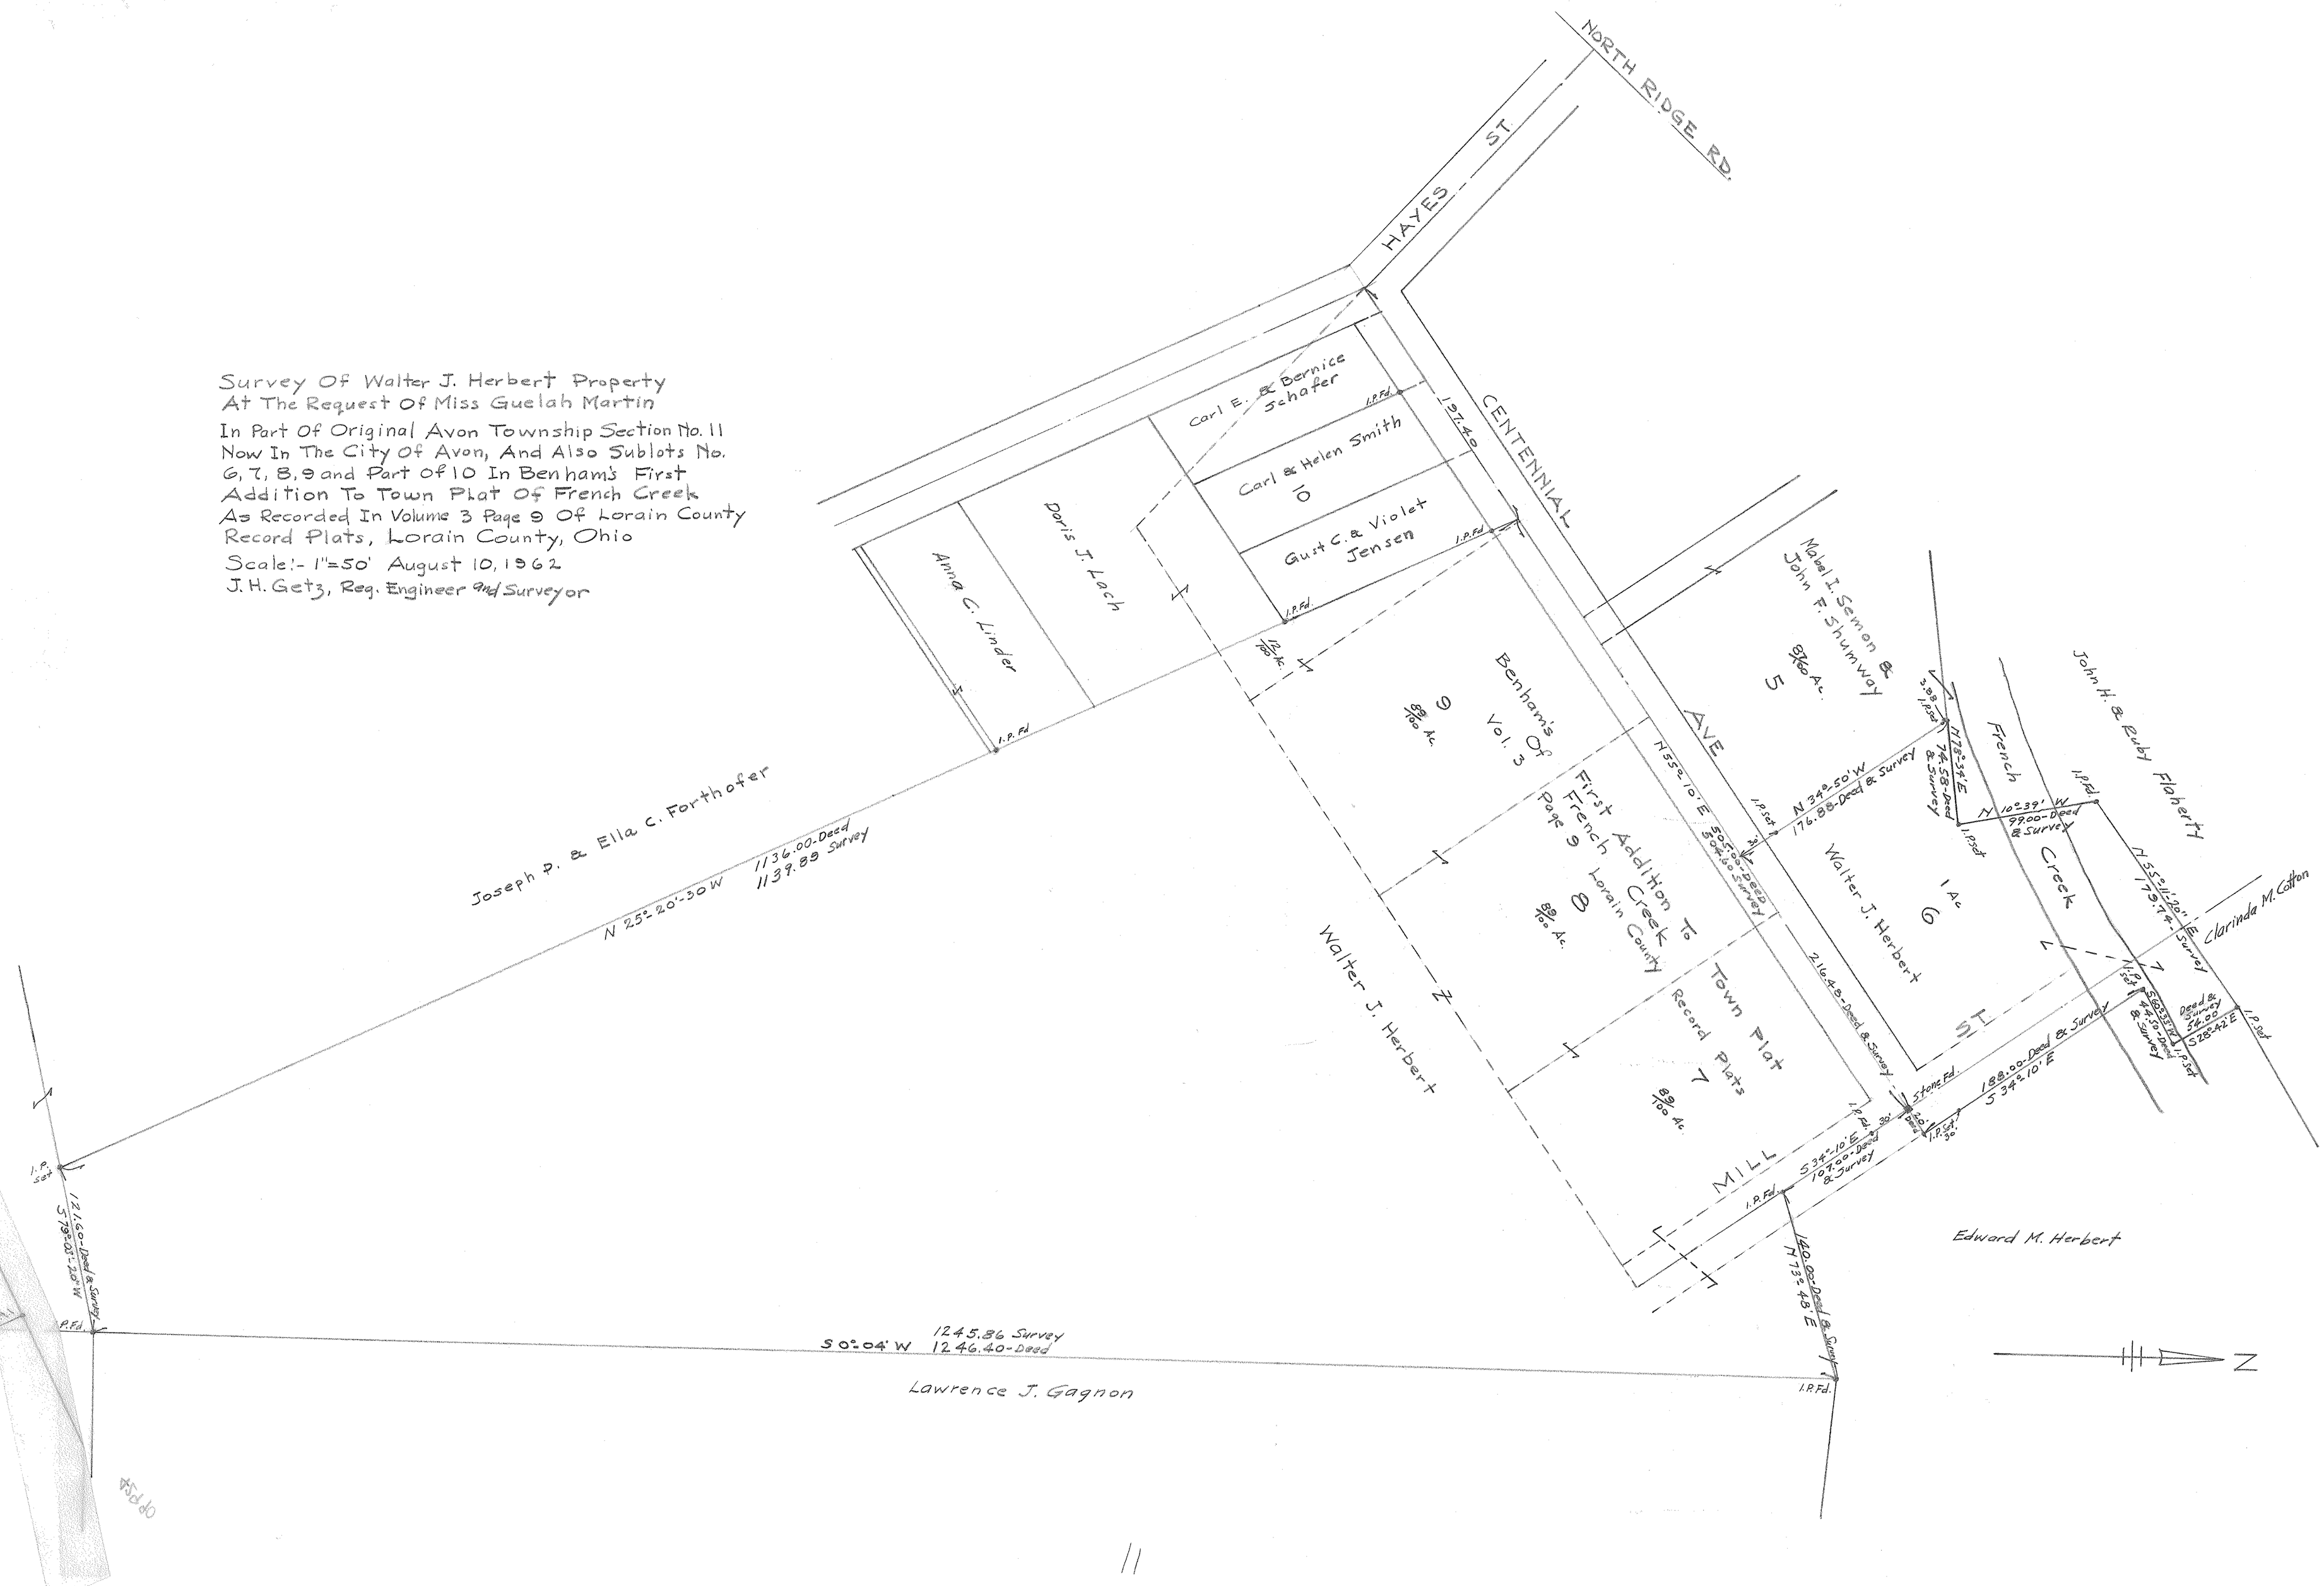

04-00-011-102-22
04-00-011-B