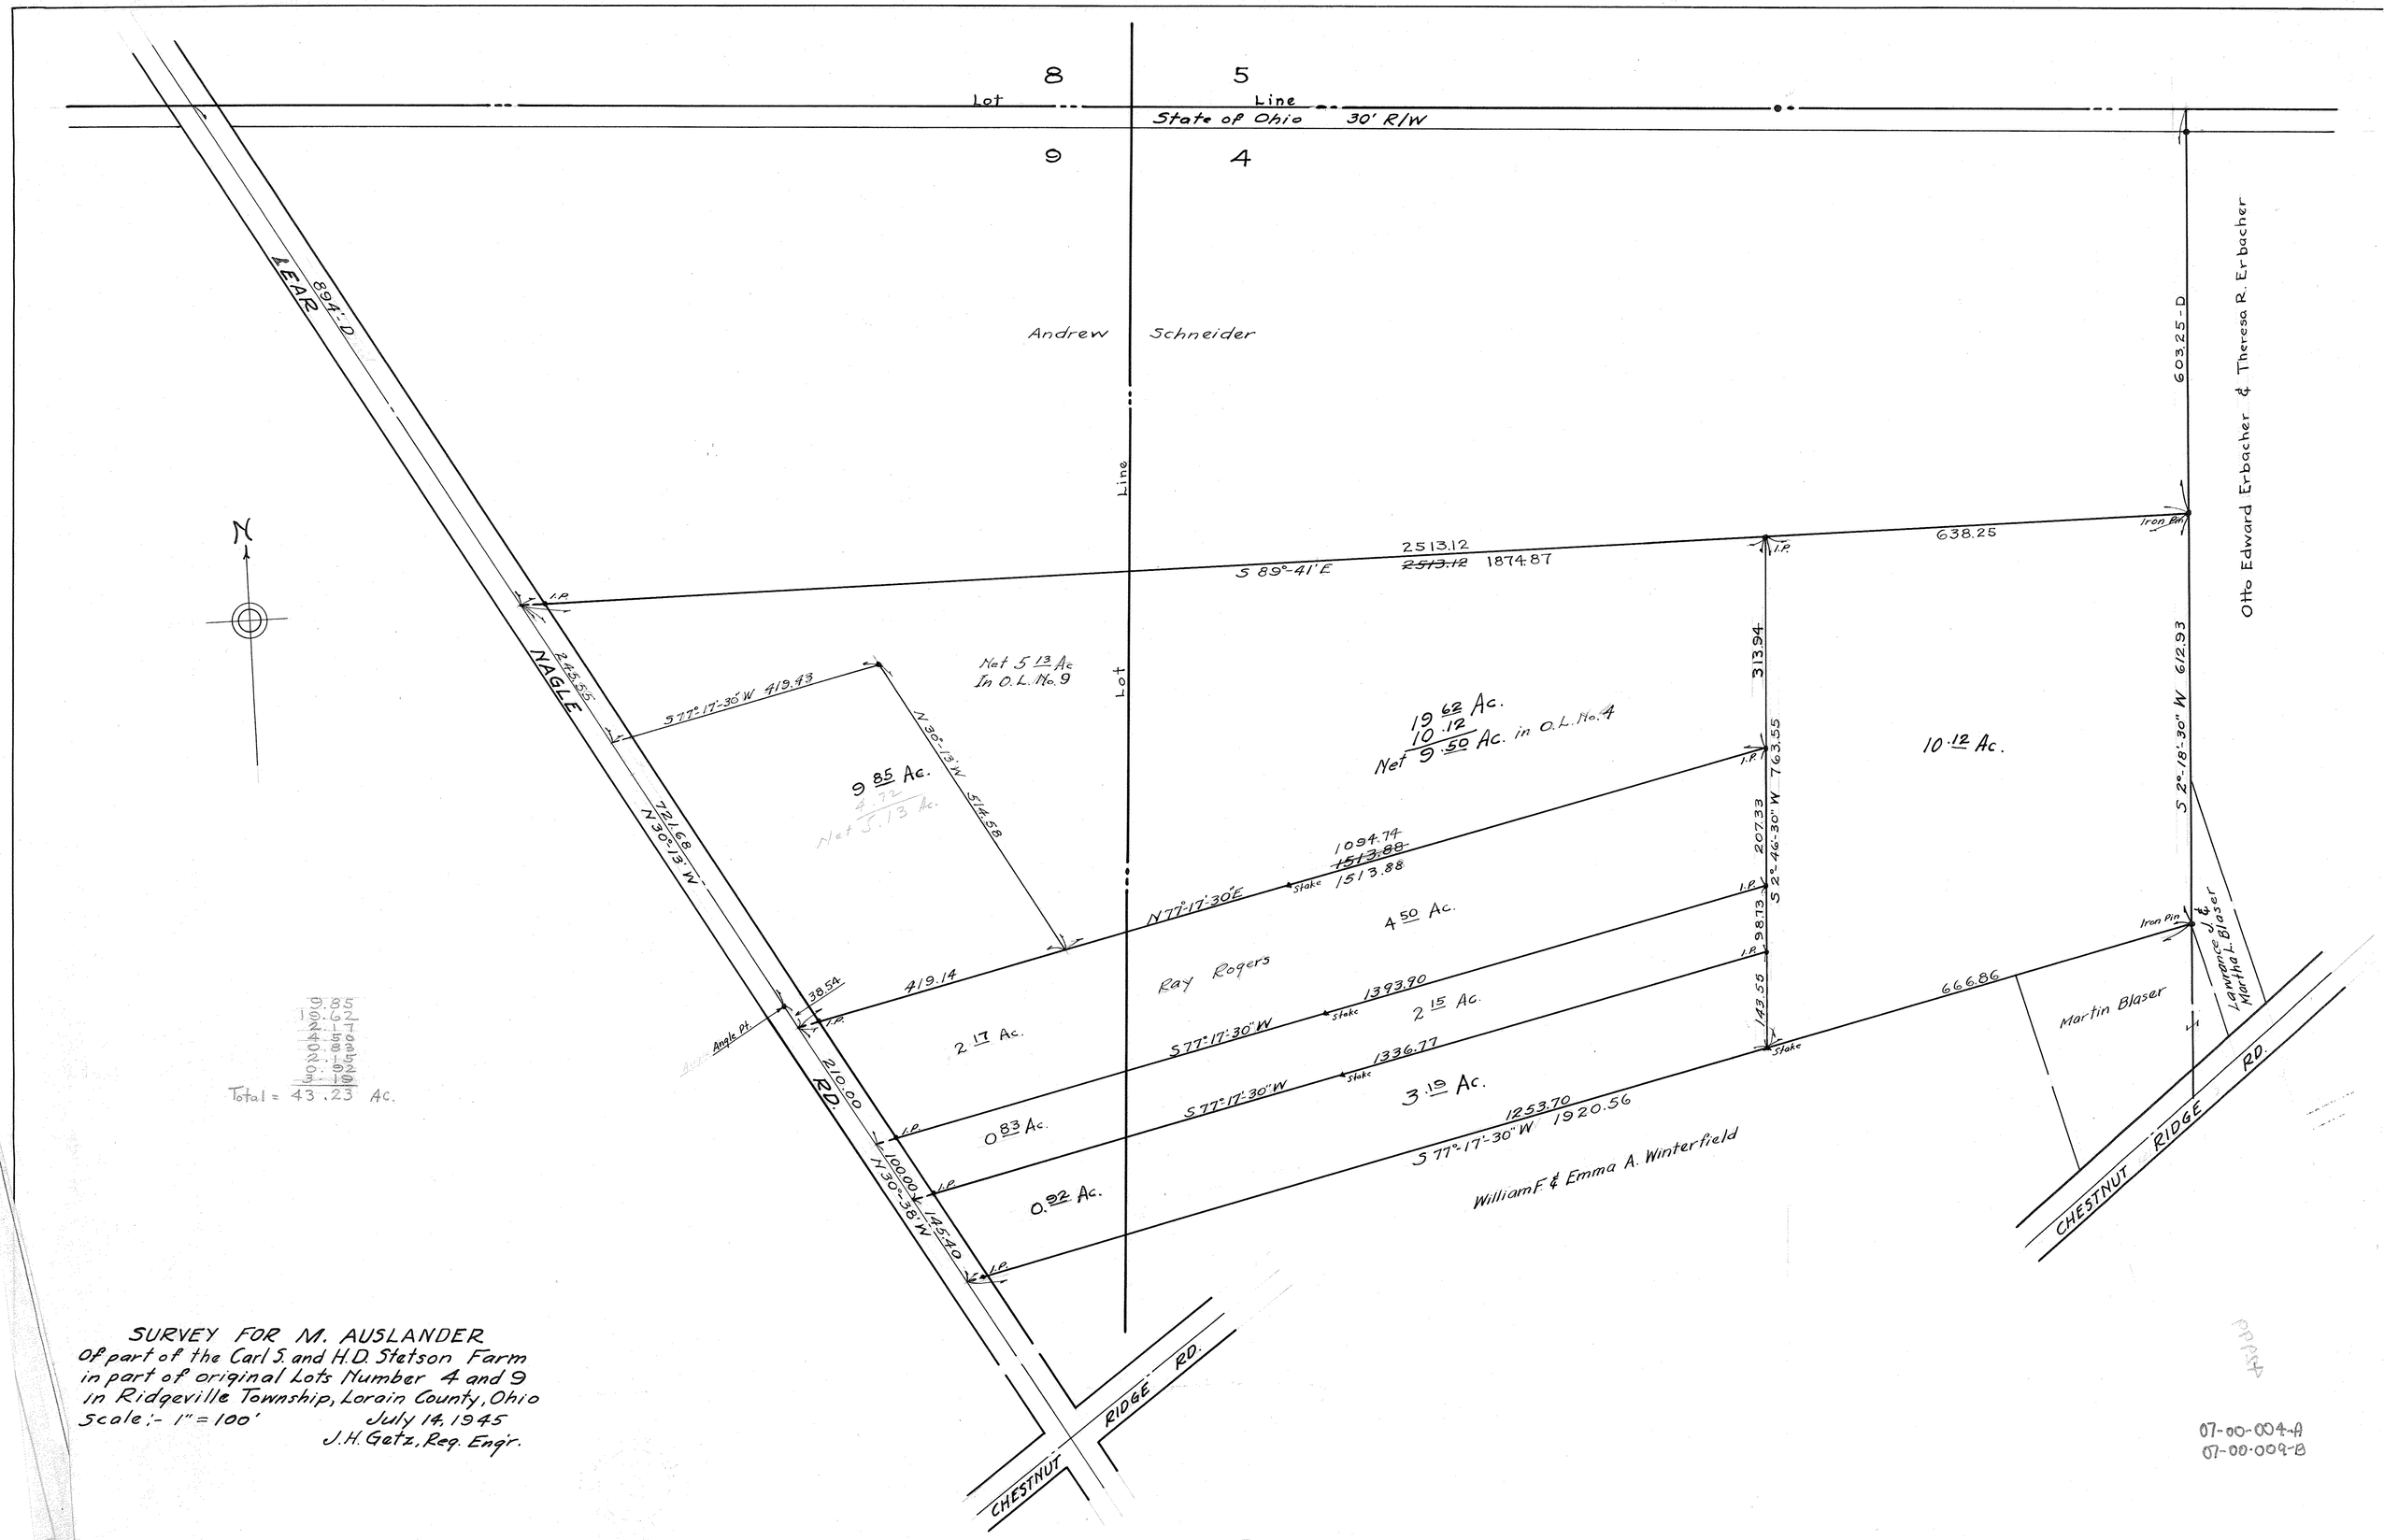

9.85
19.62
4.17
4.72
0.83
2.15
0.92
3.19
Total = 43.23 Ac.

SURVEY FOR M. AUSLANDER
Of part of the Carl S. and H.D. Stetson Farm
in part of original Lots Number 4 and 9
in Ridgeville Township, Lorain County, Ohio
Scale:- 1" = 100' July 14, 1945
J.H. Getz, Reg. Engr.

07-00-004-A
07-00-009-B