07-00-009-120-???
07-00-009-8

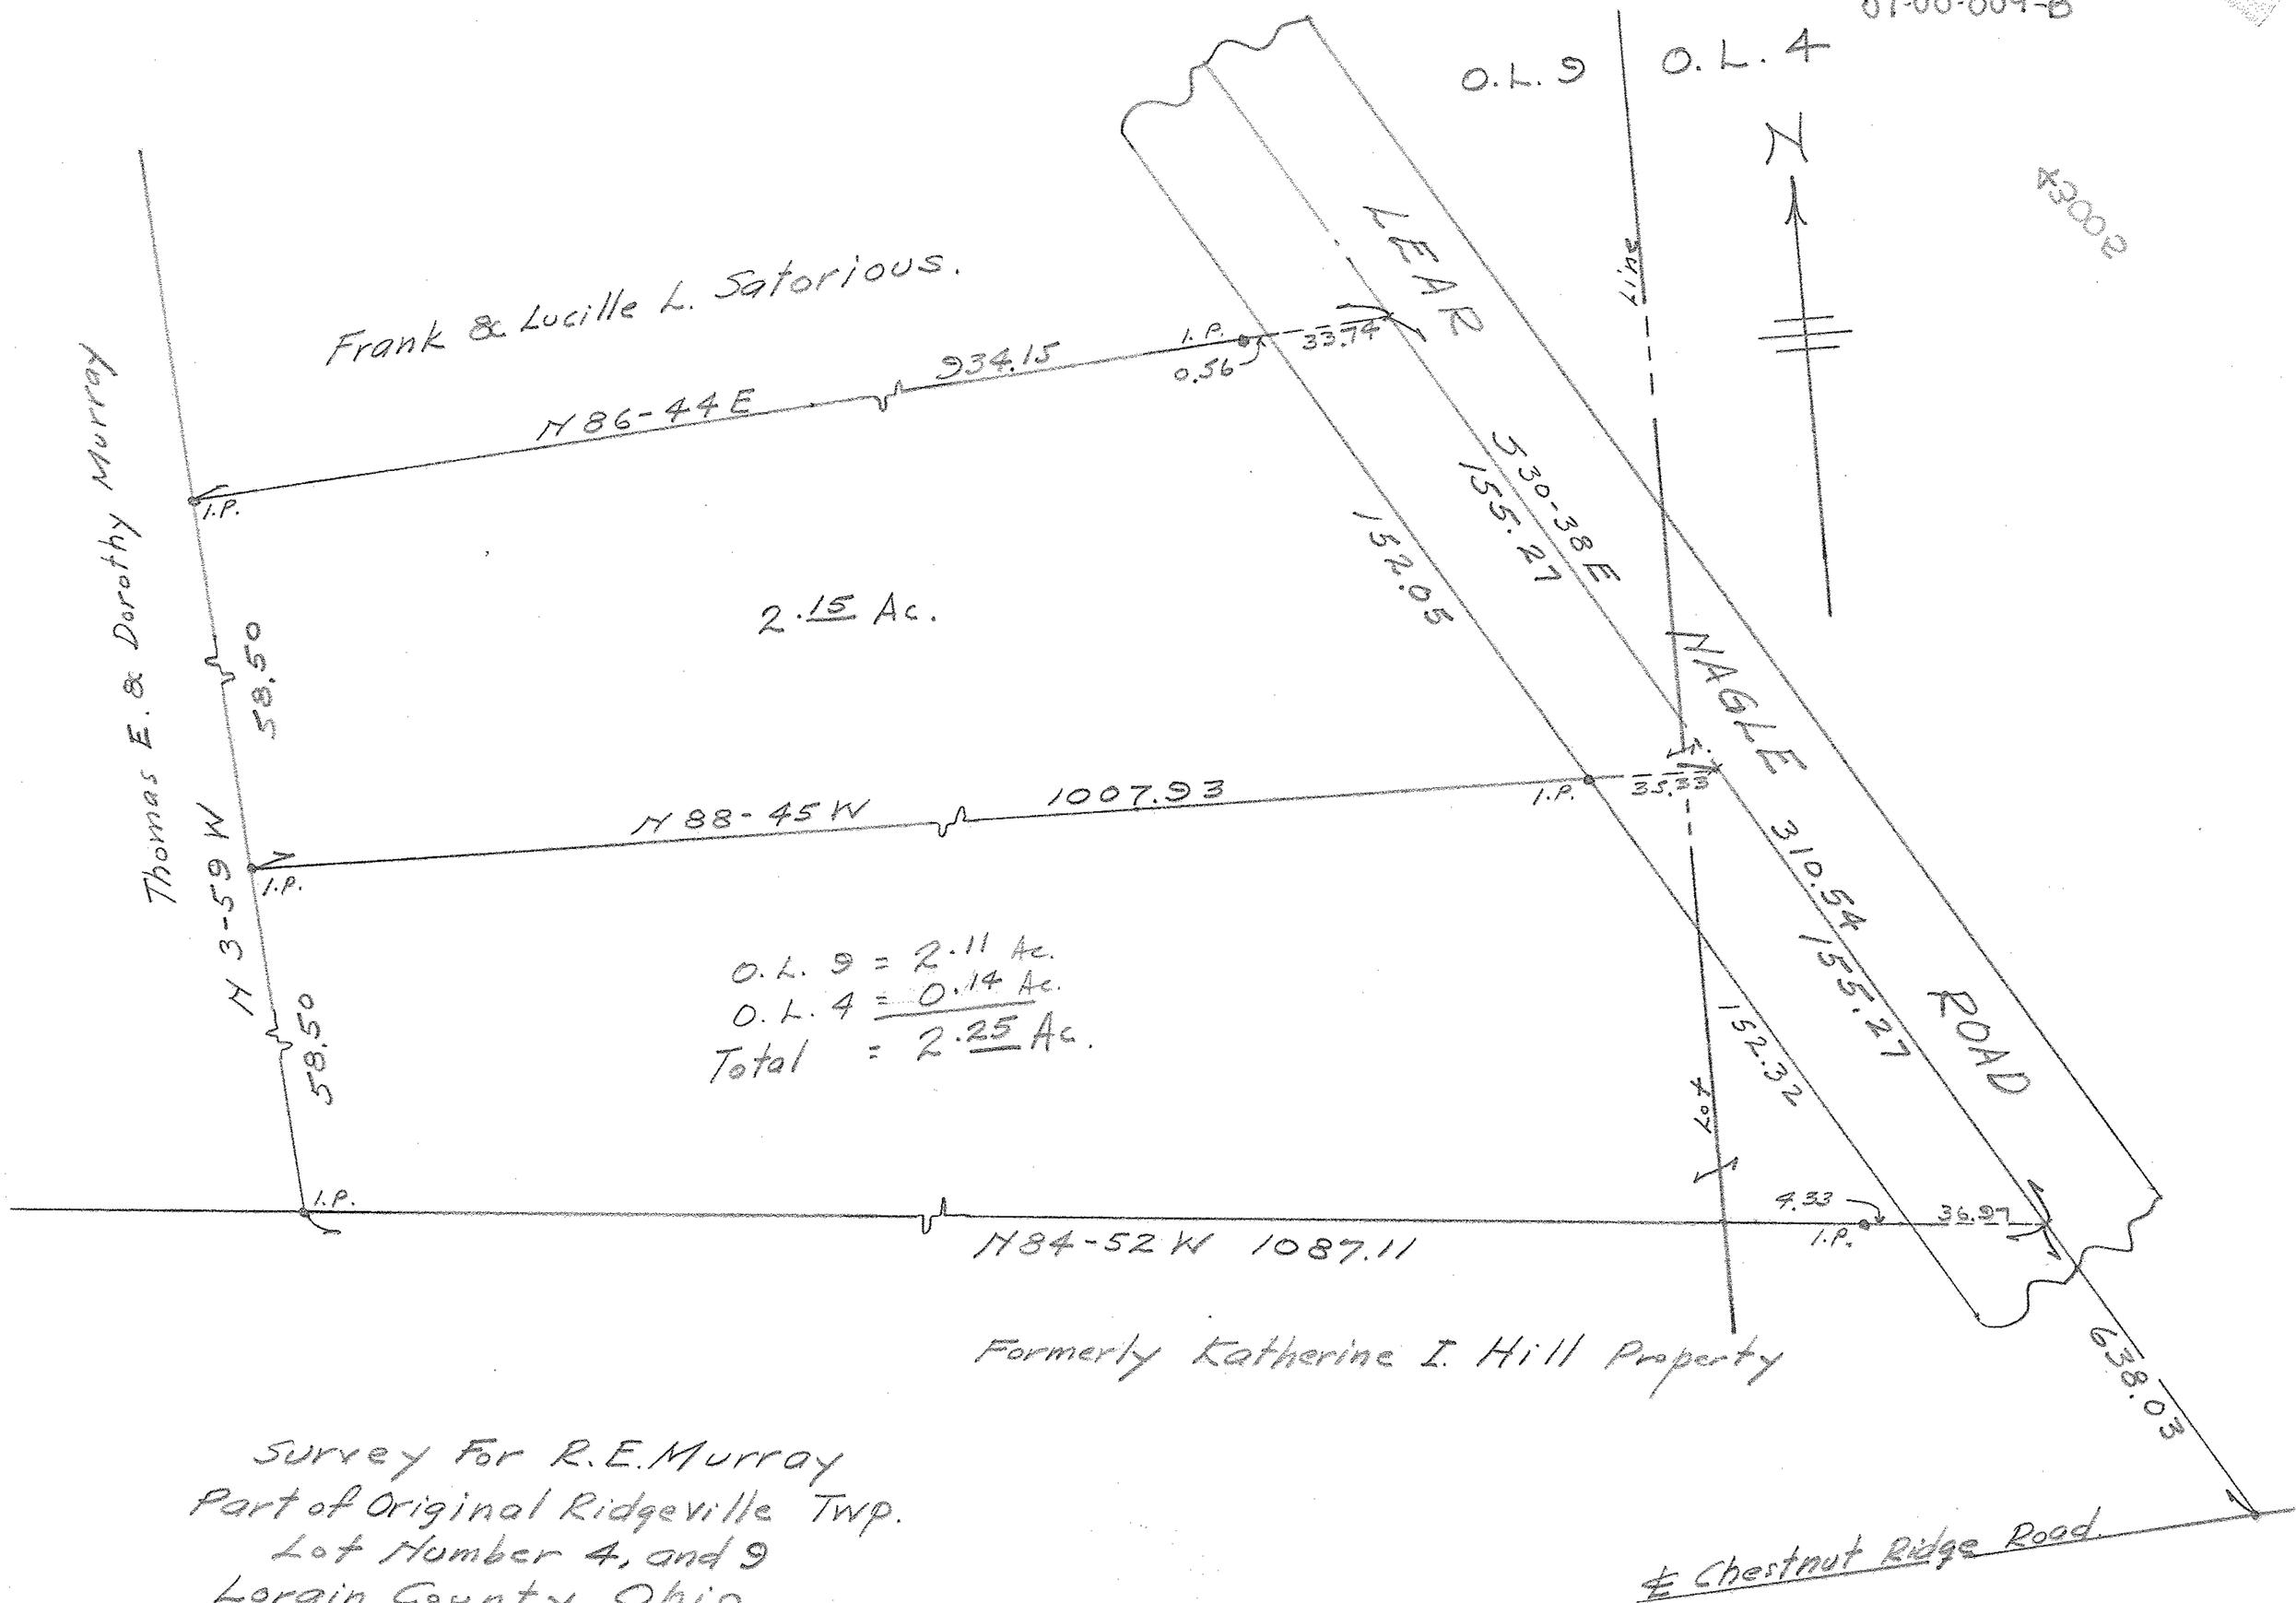

Survey For R.E. Murray
Part of Original Ridgeville Twp.
Lot Number 4, and 9
Lorain County Ohio
Scale:- Variable Date Feb. 2, 1951
J.H. Getz, Reg. Engr., & Surveyor