04-00-006-109-008
04-00-006-B

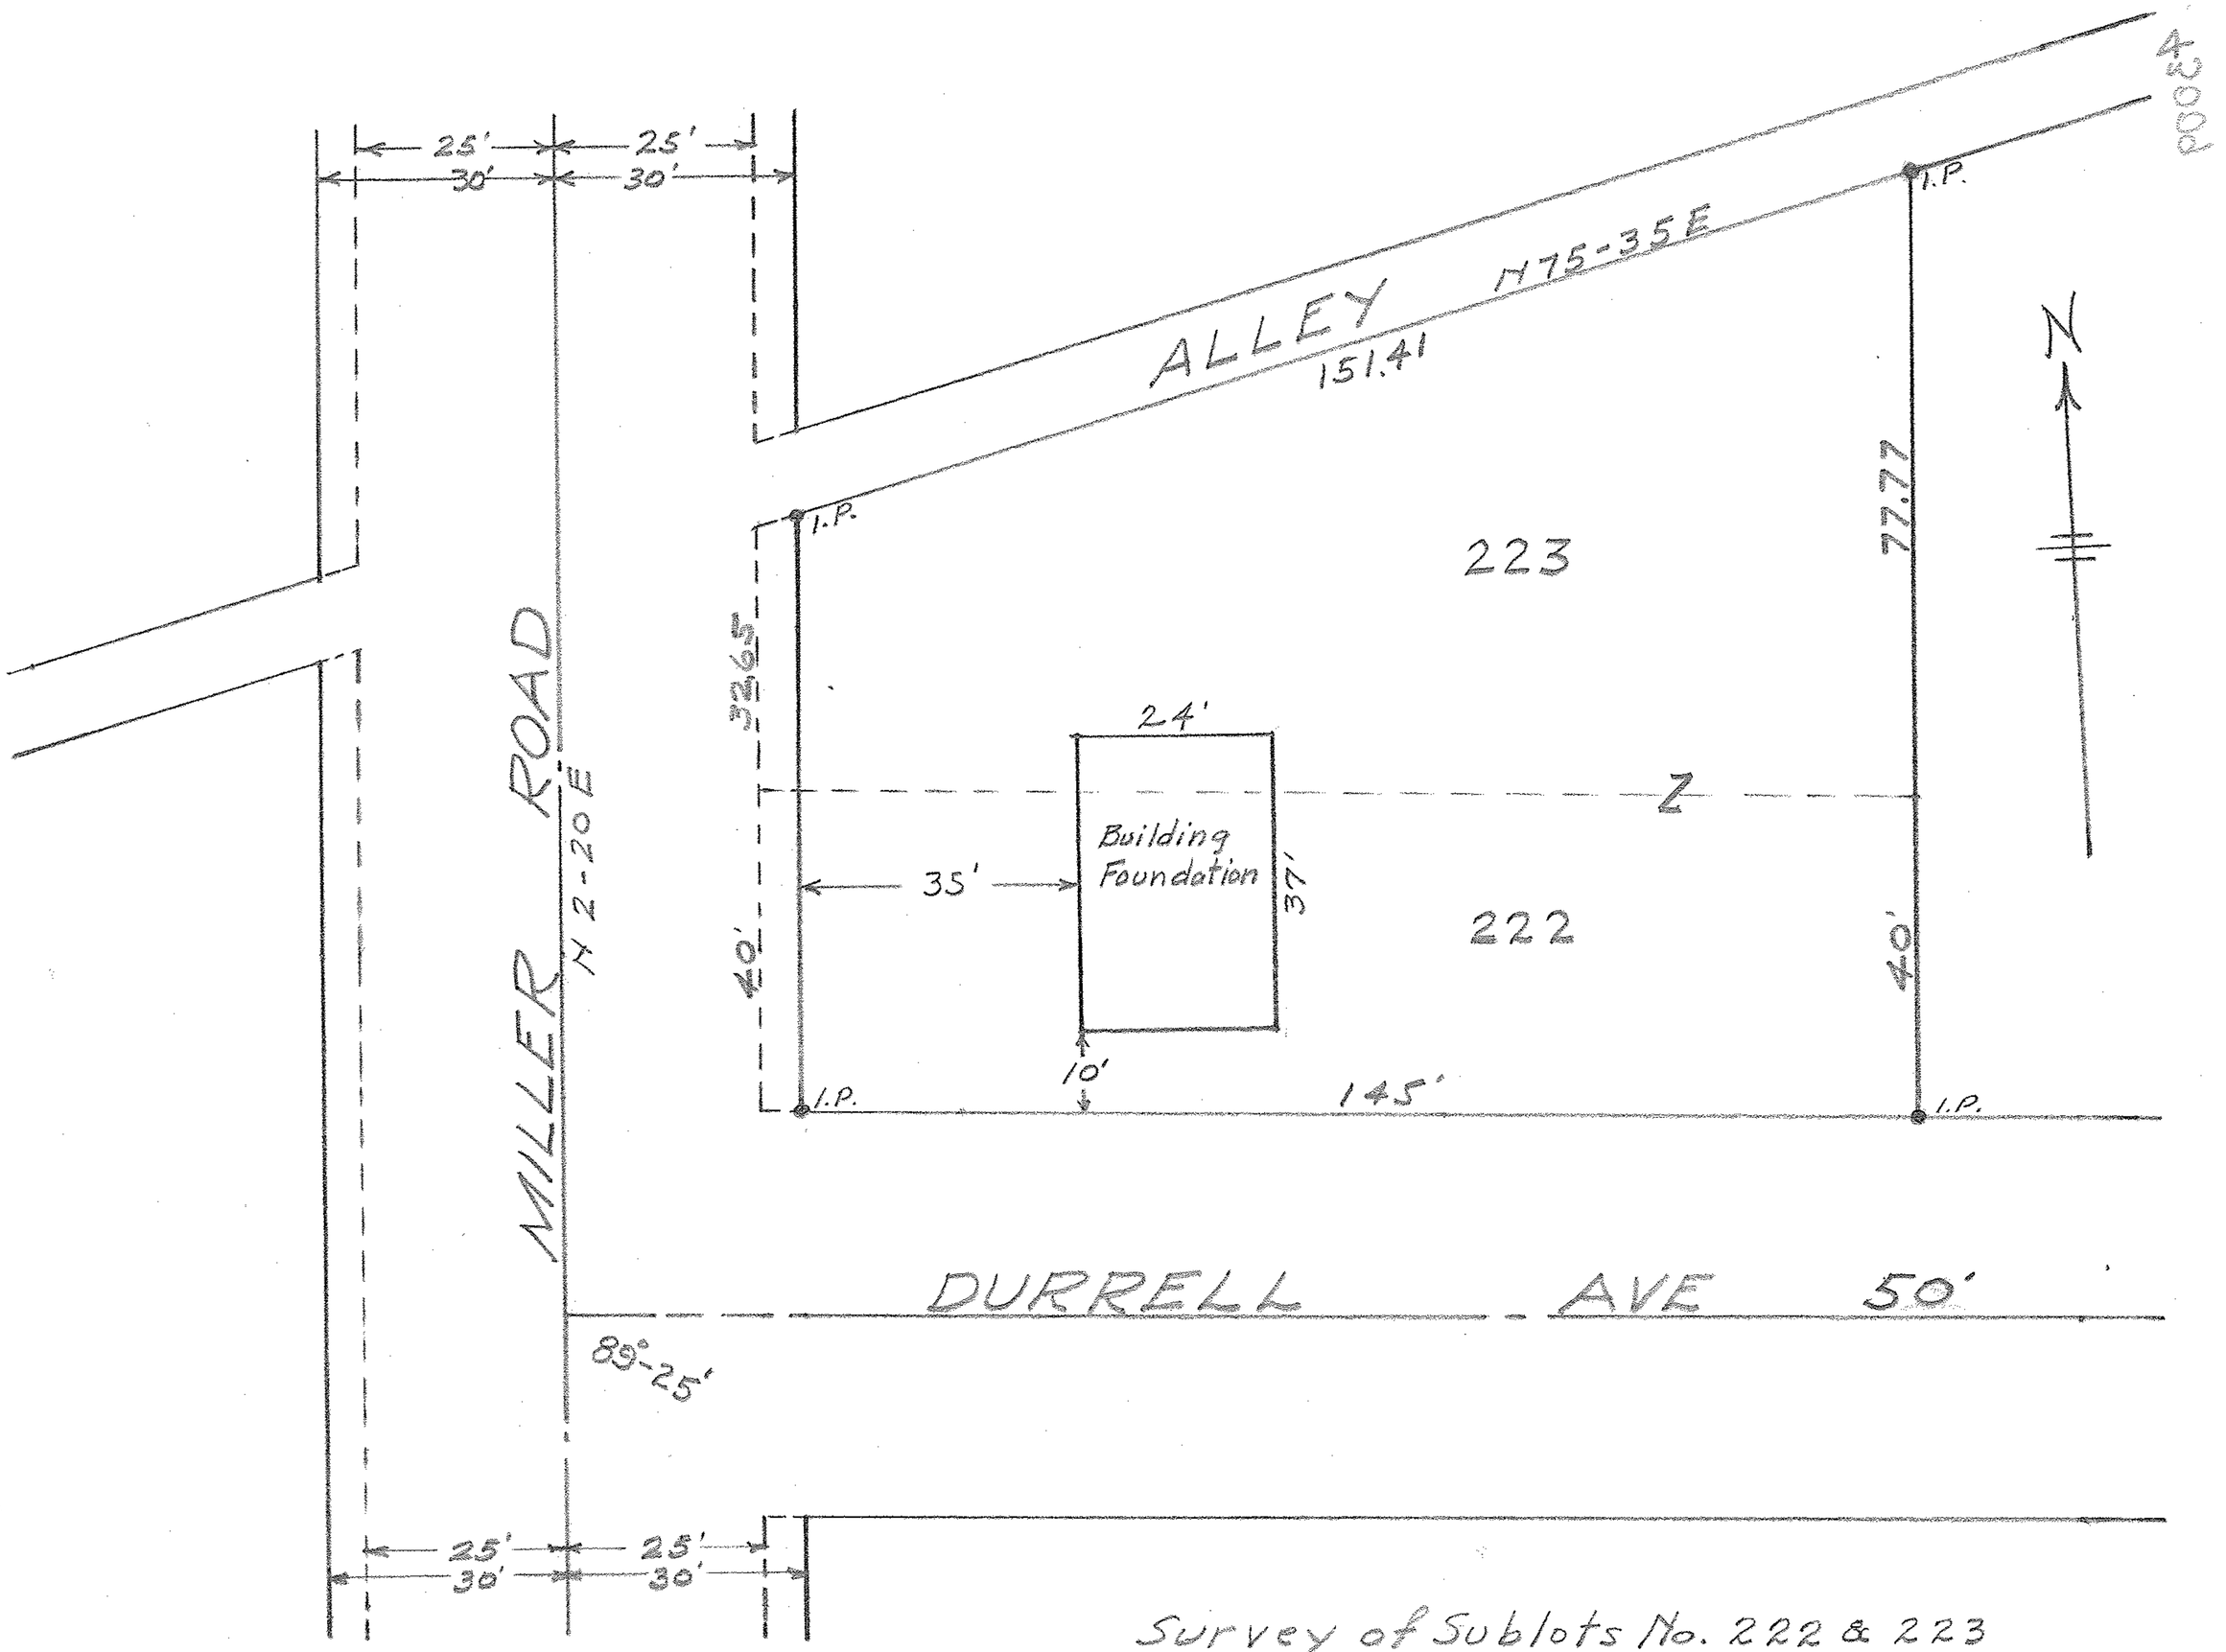

Survey of Sublots No. 222 & 223
In Avon Lake Harbor Estates
And sketch of Building Foundation
For Ralph Tait
Avon Lake Village
Lorain County Ohio
Scale:- 1" = 20' October 10, 1949
J. H. Getz Reg. Engr & Surveyor