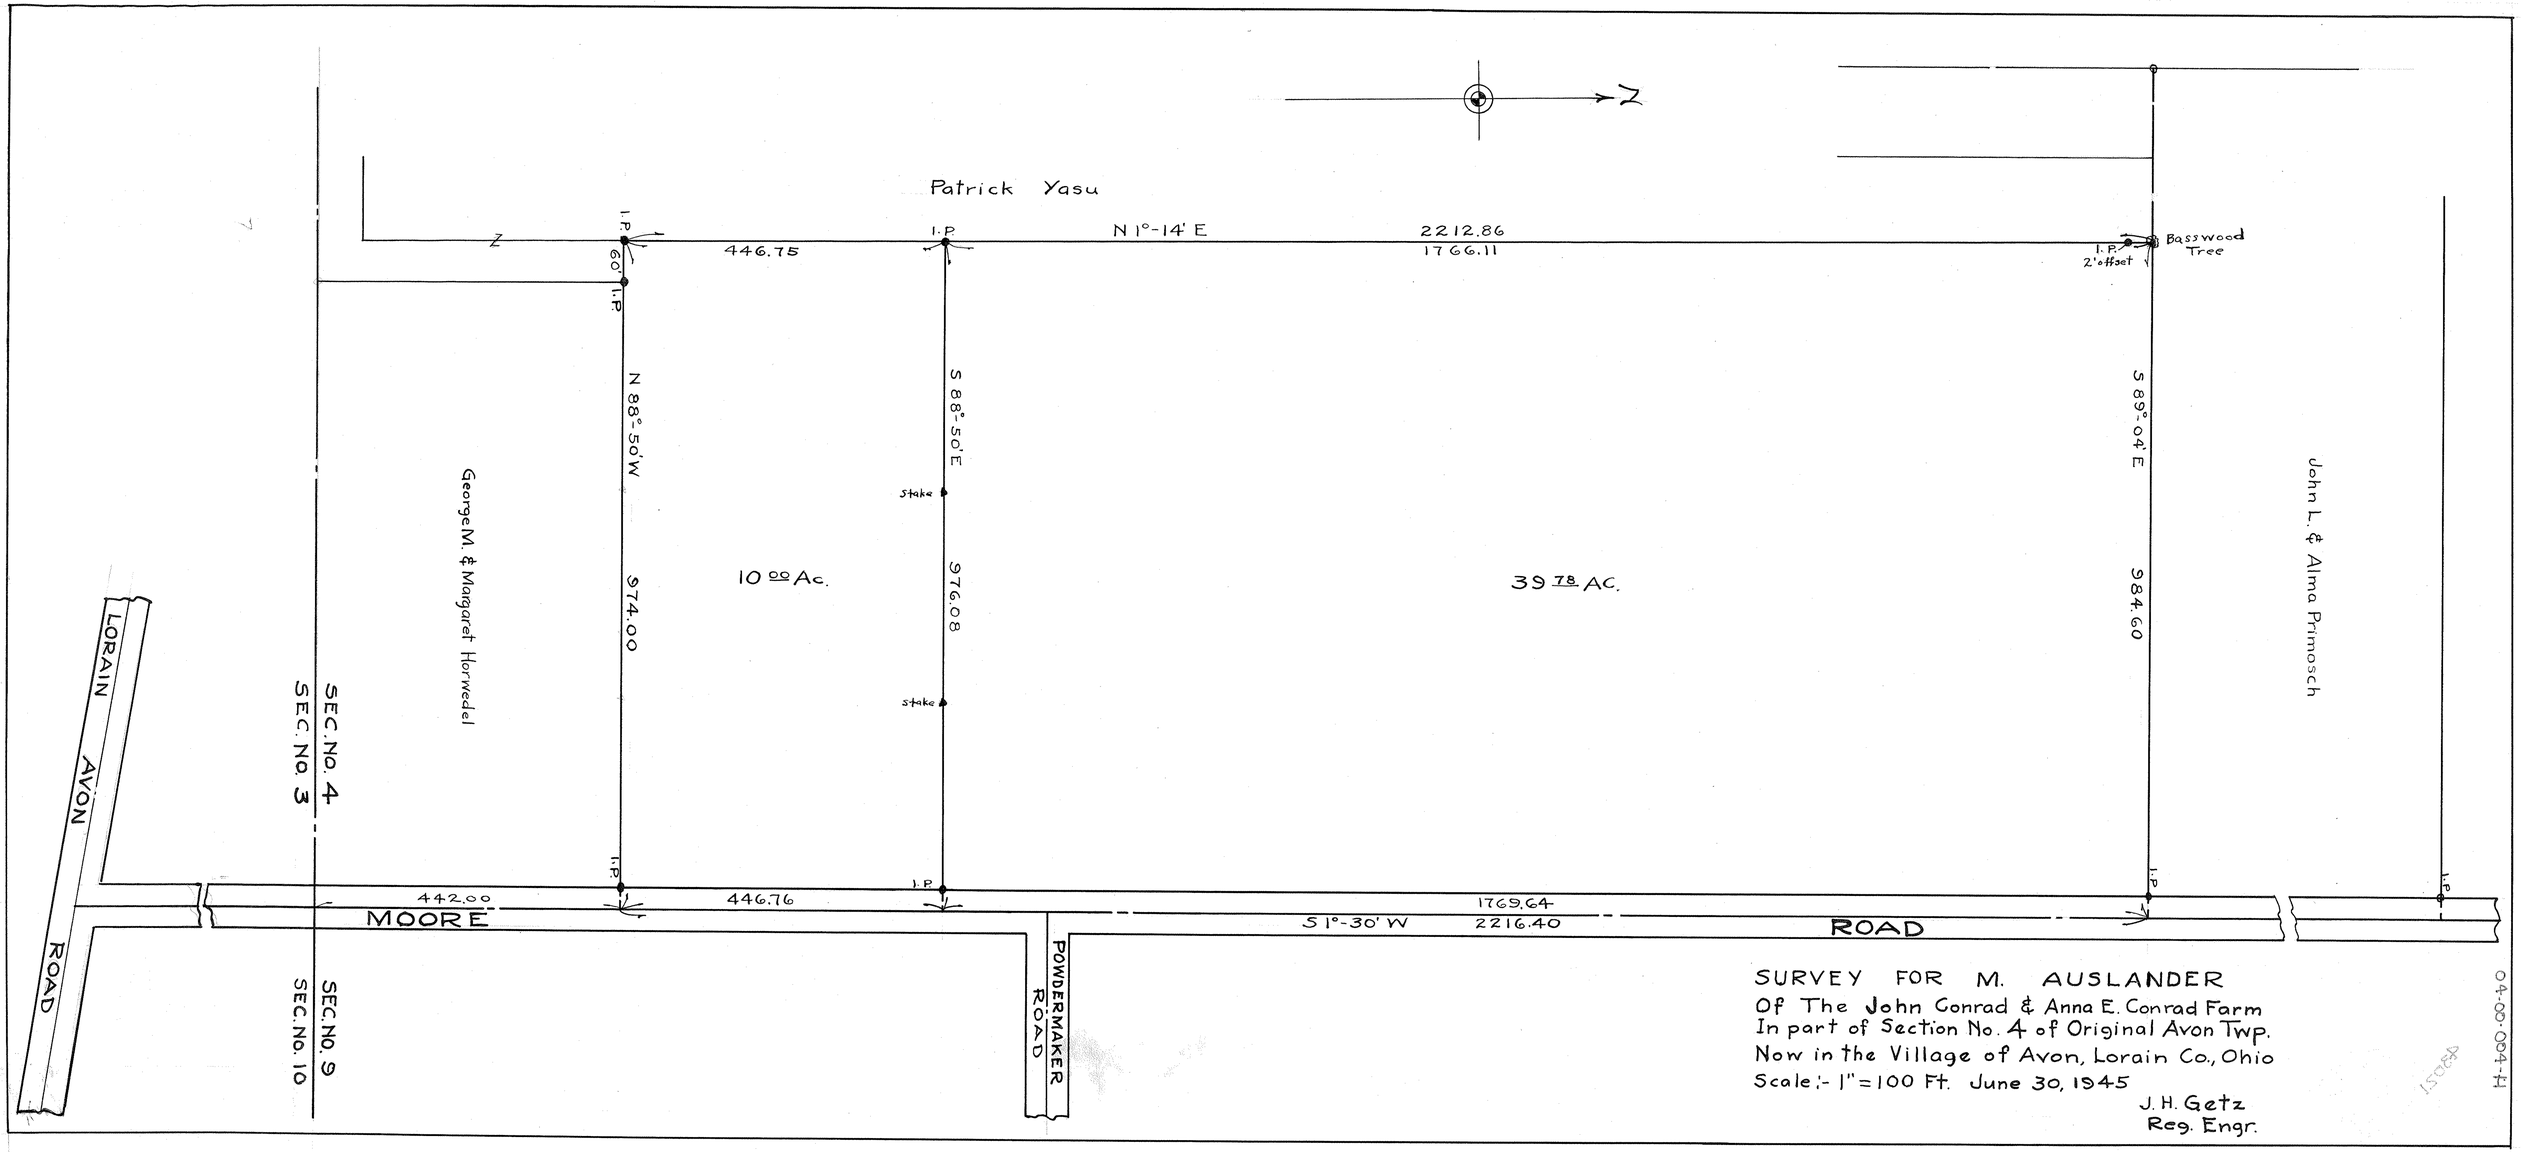

SURVEY FOR M. AUSLANDER
Of The John Conrad & Anna E. Conrad Farm
In part of Section No. 4 of Original Avon Twp.
Now in the Village of Avon, Lorain Co., Ohio
Scale:- 1" = 100 Ft. June 30, 1945

J. H. Getz
Reg. Engr.

04-00-004-107.222