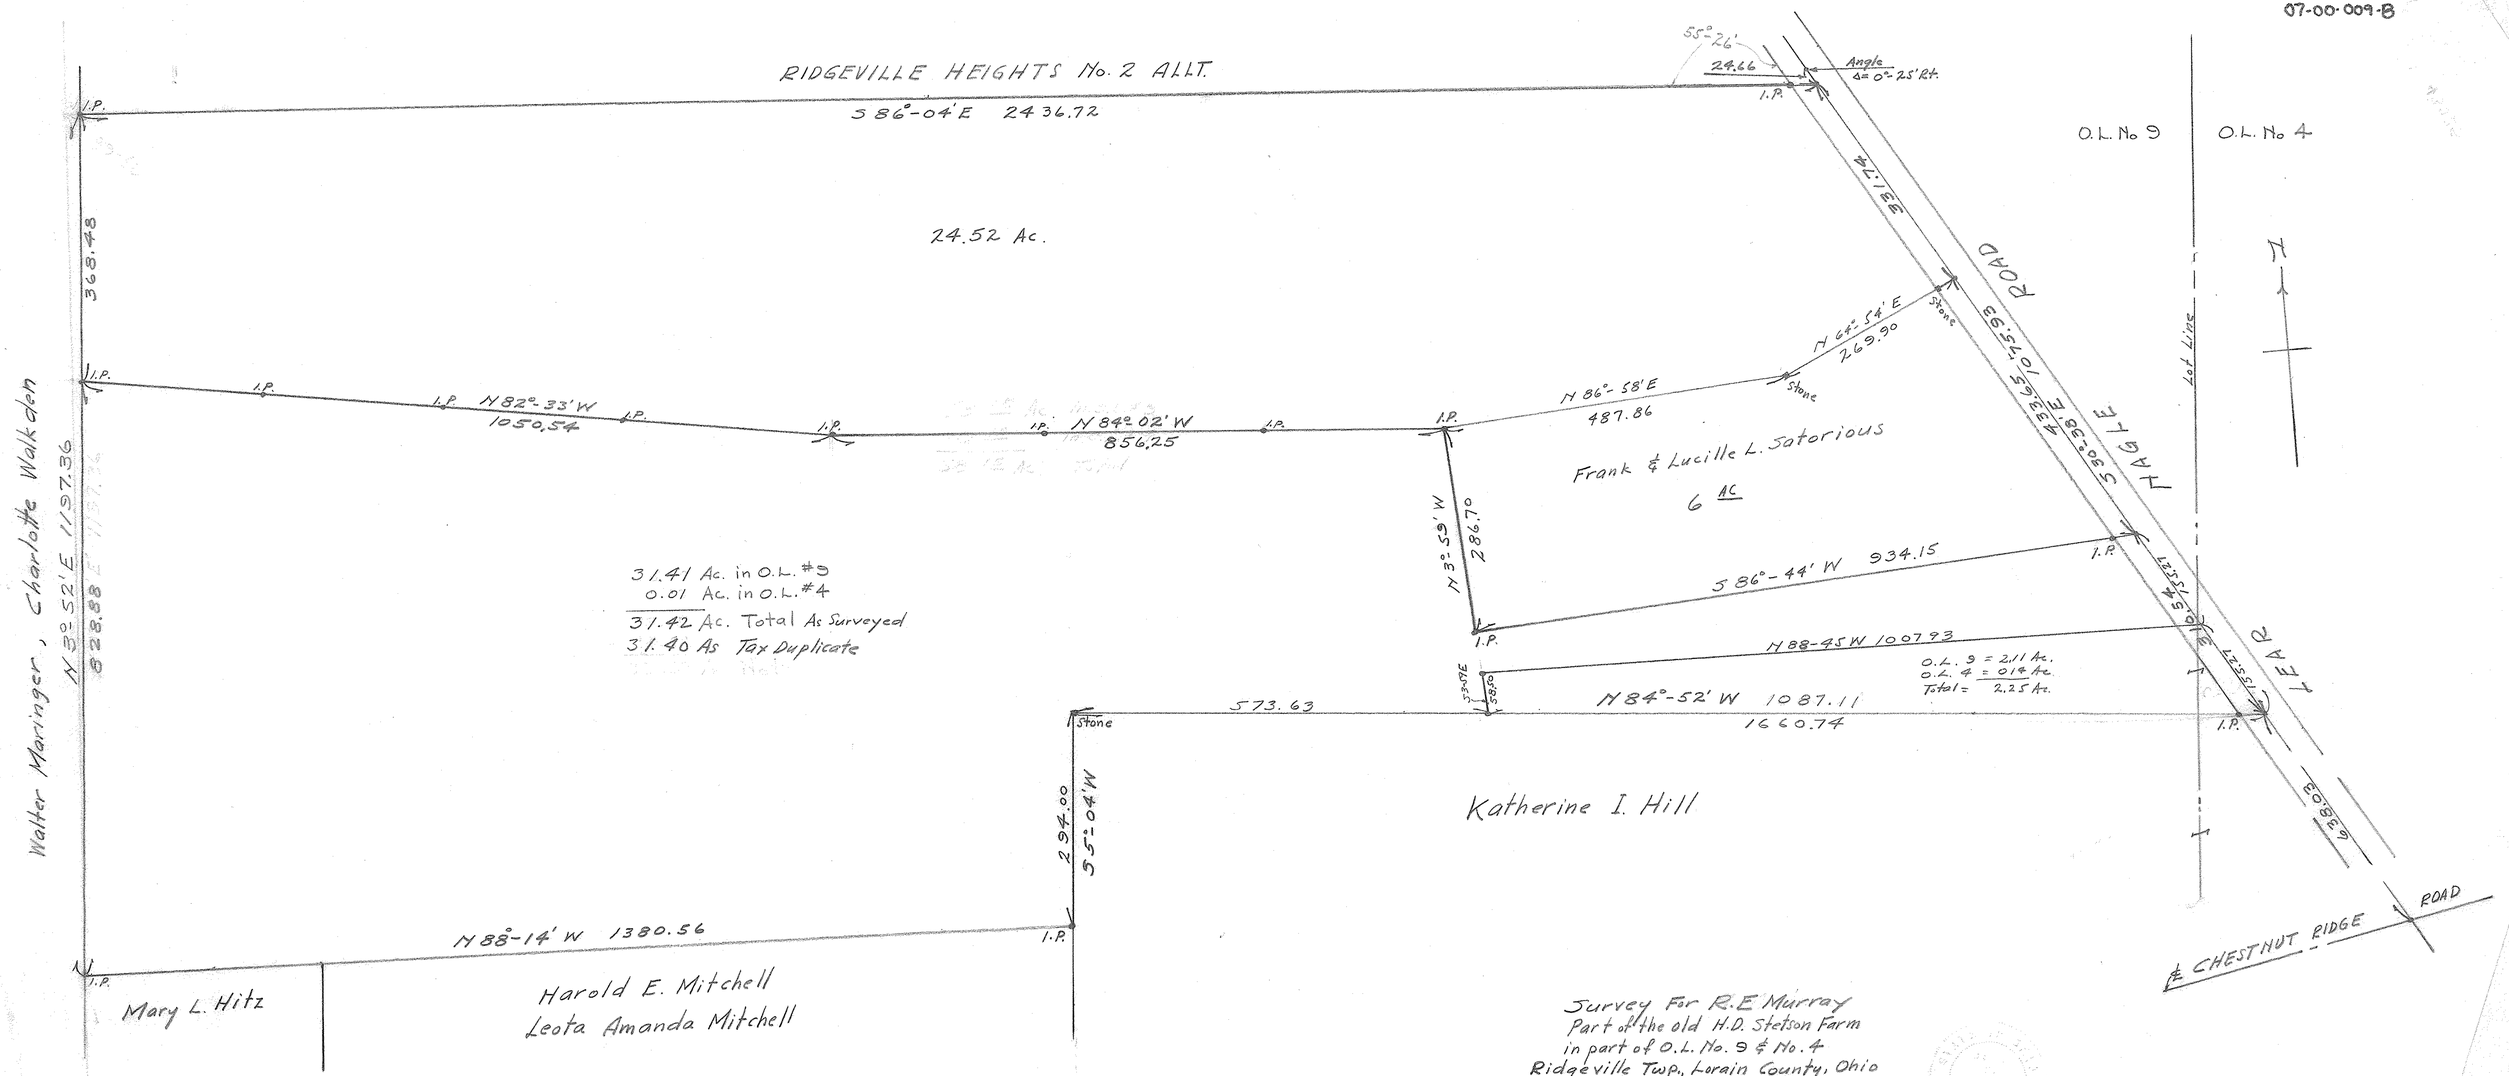07-00-009-120-???
07-00-009-B